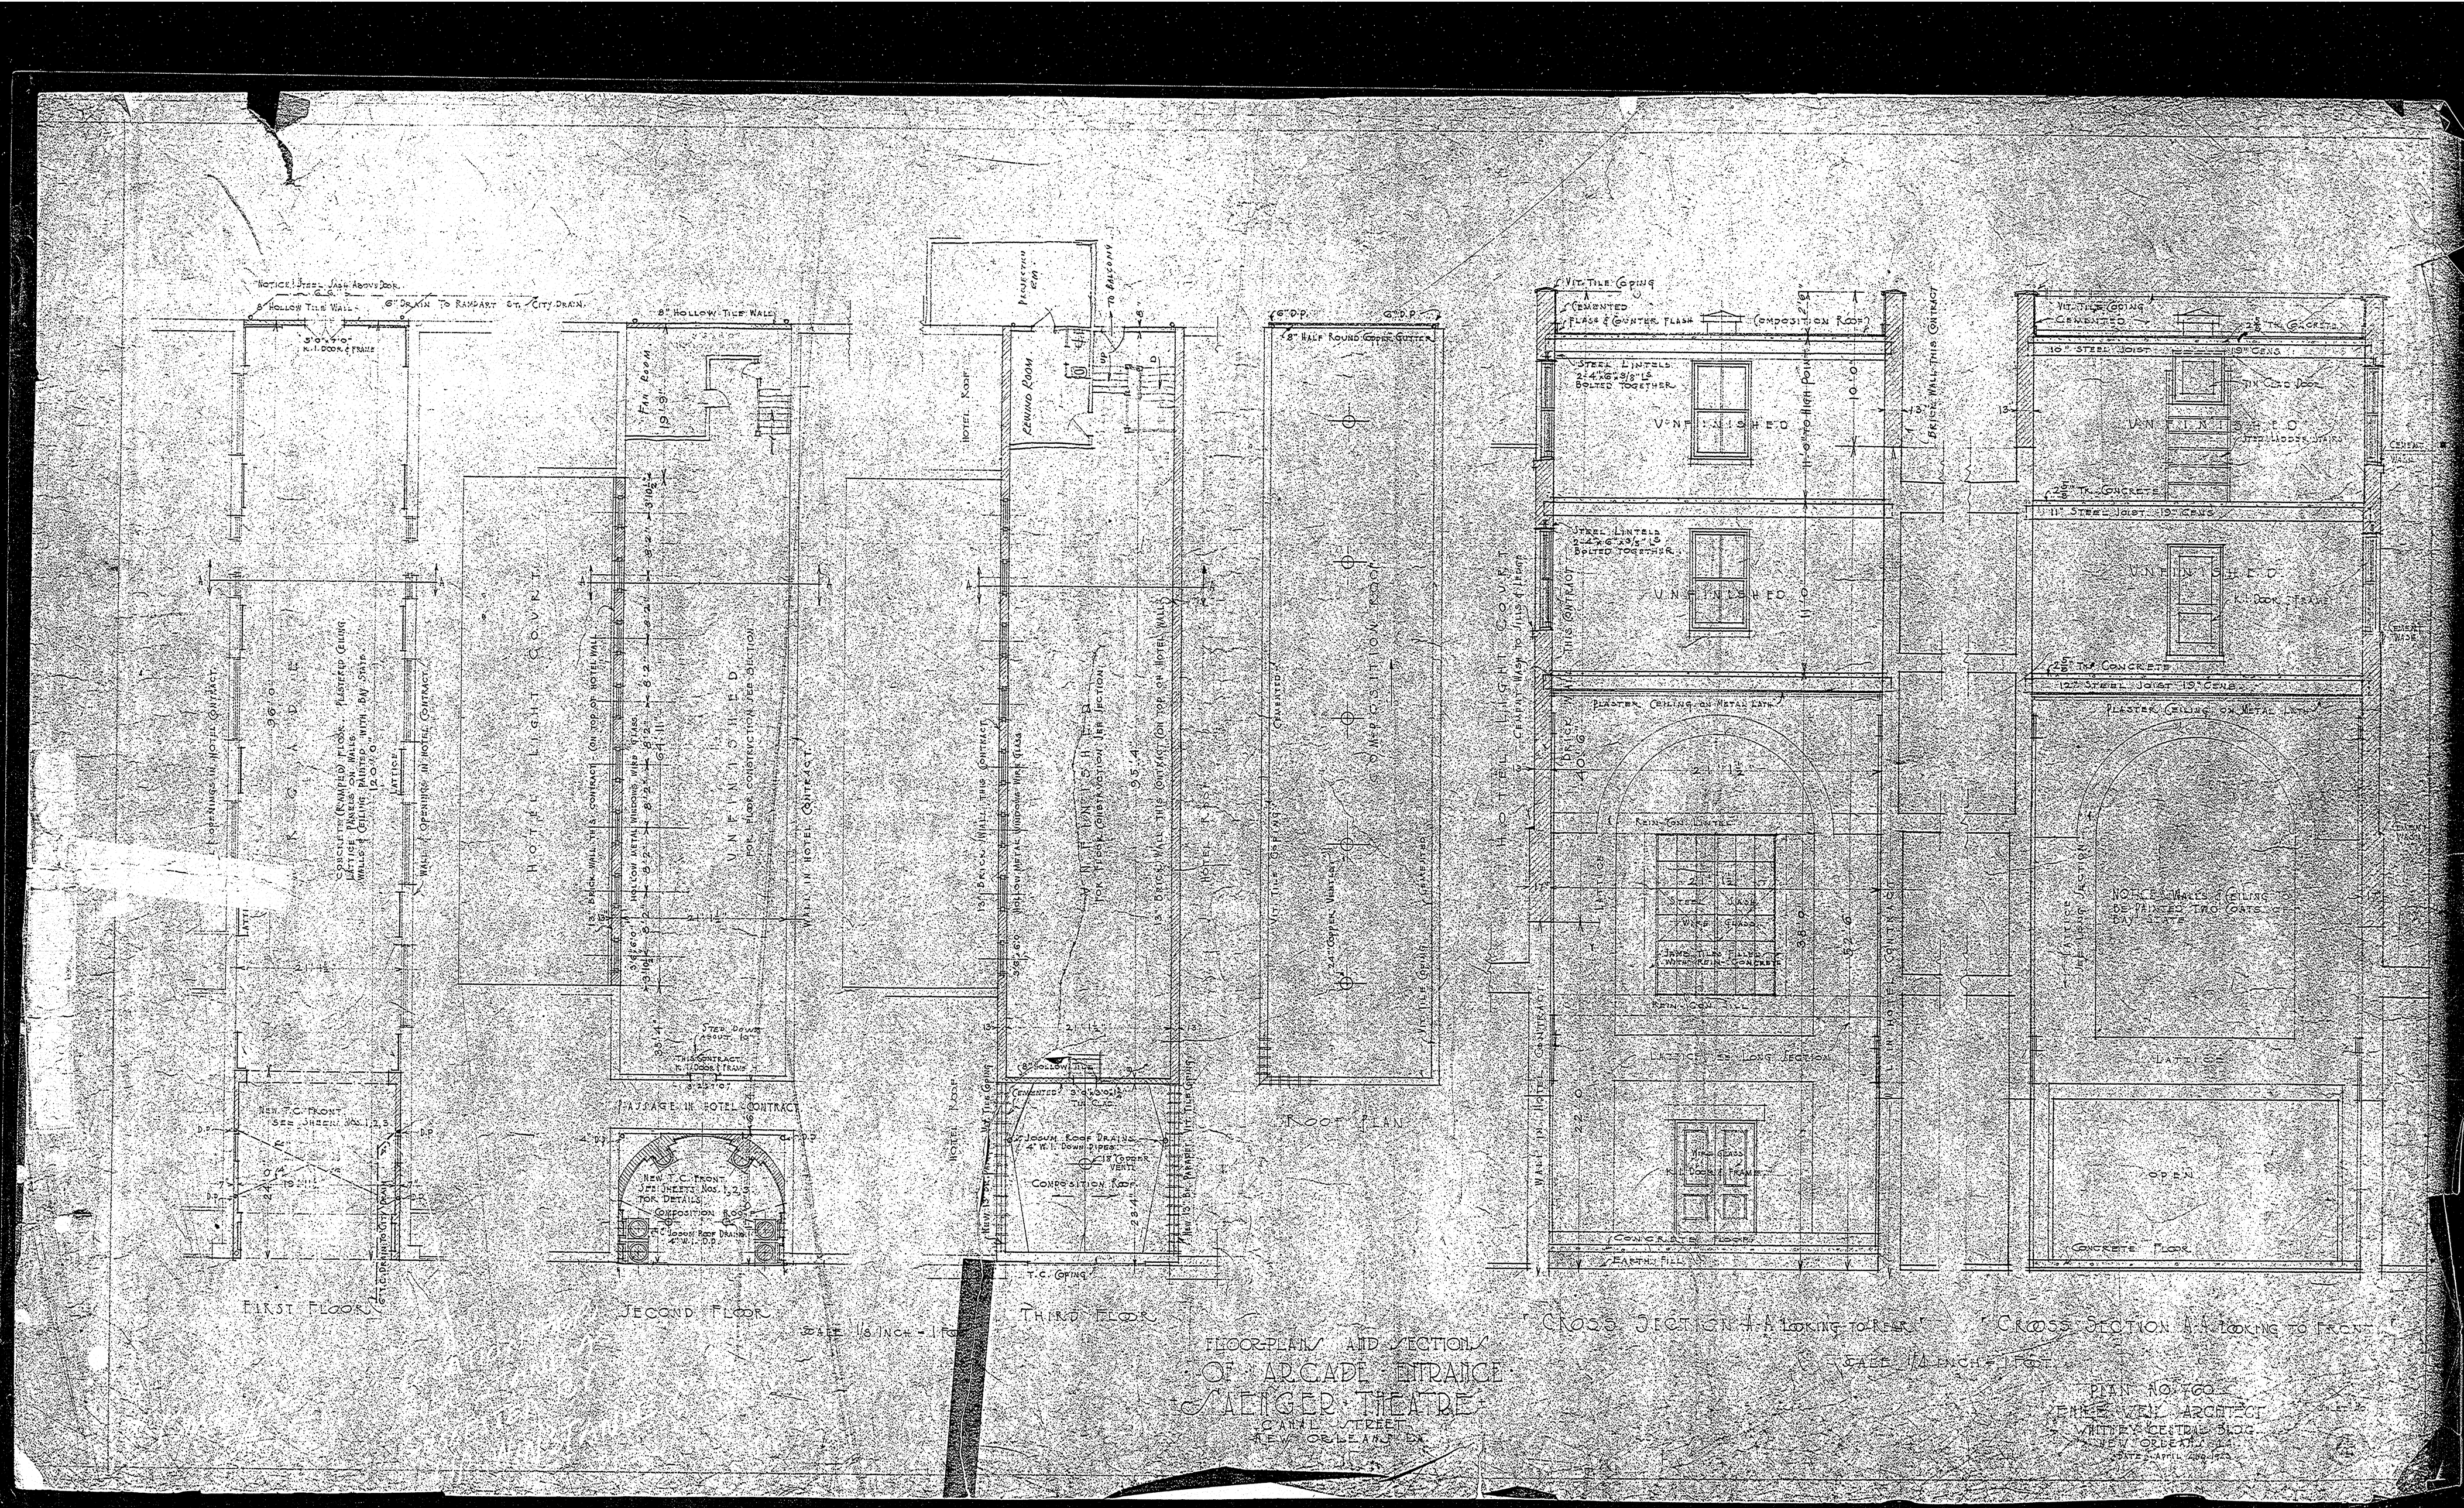
FIRST FLOOR
SECOND FLOOR
THIRD FLOOR
ROOF PLAN
CROSS SECTION A-A LOOKING TO REAR
CROSS SECTION B-B LOOKING TO FRONT
FLOOR PLANS AND SECTIONS
OF ARCADE ENTRANCE
CANAL STREET
NEW ORLEANS LA.
PLAN NO. 700
WHITE'S CENTRAL BLDG
NEW ORLEANS LA.
DATED APRIL 2nd 1920