

**THE SAENGER
THEATRE RENEWAL
PROJECT**

142 North Rampart Street
New Orleans, LA

Client
Saenger Theatre Redevelopment Company
200 West Loop South, Suite
1040 Houston TX 77027

Architect
**MARTINEZ+JOHNSON
ARCHITECTURE**

1412 Eye St., NW
Washington, DC 20005
202.333.4480

Structural Engineer
Shawn J. Franke, P.E.
549 Heimer Road, San
Antonio TX 78232
210.979.7900

Theatre Consultant
Schuler Shook
123 Third Street North #210
Minneapolis, MN 55401
612.333.5959

Acoustical Engineer
Akustiks
93 North Main Street South
Norwalk, CT 06854
202.299.1904

MEP Engineer
JBA Consulting Engineers, Inc.
3525 N. Causeway Blvd. Suite
500 Metairie, LA 70002
504.830.0139

Civil Engineer
Linfield, Hunter, & Junius, Inc.
3608 18th Street Suite 200
Metairie, LA 70002
504.333.5392

Architectural Historian
EHT Traceries, Inc.
1121 Fifth Street NW
Washington, DC 20001
202.393.1199

7502

DATE: No.: ISSUE:

02.19.10 1 PERMIT SET

04.02.10 2 GMP CONTRACT SET

DATE: No.: REVISION:

11.11.10 CONTRACT SET

SHEET TITLE:

THEATRE - ORCHESTRA
LEVEL PLAN

P-1.02

09.03.04


ISSUED FOR PERMIT

© 2010 M+J

NOTES

- ① 3" M.G., 6" V., 4" C.W. AND 1/2" H.W.R. FROM BELOW AND UP AND 4" C.W., 2 1/2" H.W., AND 3" W. FROM ABOVE AND DOWN.
- ② 4" V. FROM BELOW.
- ③ 4" V. UP.
- ④ 4" W. FROM ABOVE.
- ⑤ 4" W. DOWN.
- ⑥ 2 1/2" C.W. AND 1 1/4" H.W. UP AND 1" H.W.R. FROM ABOVE.
- ⑦ 2 1/2" C.W. AND 1 1/4" H.W. FROM BELOW AND 1" H.W.R. DOWN.
- ⑧ NEW PROPOSED LOCATION OF GAS METER (5# MEDIUM PRESSURE GAS TO BUILDING).
- ⑨ REFER TO GAS PIPING DIAGRAM P-5.03.
- ⑩ 3" M.G. DOWN.
- ⑪ 6" S.D. & O.S.D. FROM ABOVE. PIPE S.D. DOWN TO BELOW GRADE WITH W.C.O. AND O.S.D. DOWN AND TERMINATE +12" ABOVE FINISHED GRADE.
- ⑫ REFER TO CIVIL FOR CONTINUATION (INV. = -3'-0" BELOW FINISHED FLOOR).
- ⑬ 1 1/4" C.W. AND 3/4" H.W. FROM BELOW AND UP, 3/4" H.W.R. FROM ABOVE AND DOWN, 2" V. FROM BELOW AND UP, 3" W. DOWN.
- ⑭ 1" C.W. AND 3/4" H.W. FROM BELOW AND UP, 3/4" H.W.R. FROM ABOVE AND DOWN, 2" V. UP, 2" W. DOWN.
- ⑮ 1" C.W. AND 3/4" H.W. FROM BELOW AND UP, 3/4" H.W.R. FROM ABOVE AND DOWN, 3" W. DOWN.
- ⑯ 2" V. FROM BELOW.
- ⑰ 2" W. FROM ABOVE.
- ⑱ 2" V. UP.
- ⑲ 3/4" C.W. TO RECESSED HOSE BIBB.
- ⑳ 3/4" C.W. UP FROM BELOW.
- ㉑ 3" W. DOWN, 2" V. UP AND 3/4" H. & C.W. UP FROM BELOW WITH CHECK AND SHUT-OFF VALVES TO S.S.-1.
- ㉒ 2" W. DOWN, 2" V. UP AND 1/2" C.W. UP FROM BELOW TO E.W.C.-2.
- ㉓ 2" W. DOWN, 2" V. UP, AND 3/4" H. & C.W. UP FROM BELOW TO TEMPERING STATION AND PIPE T.W. TO EYEWASH.
- ㉔ 3" W. FROM ABOVE.

PROVIDE NEW GAS METER FOR ESTIMATED 7000 CFH CONNECTED GAS LOAD AT 5 PSI. COORDINATE CONNECTION OF NEW METER WITH GAS UTILITY.

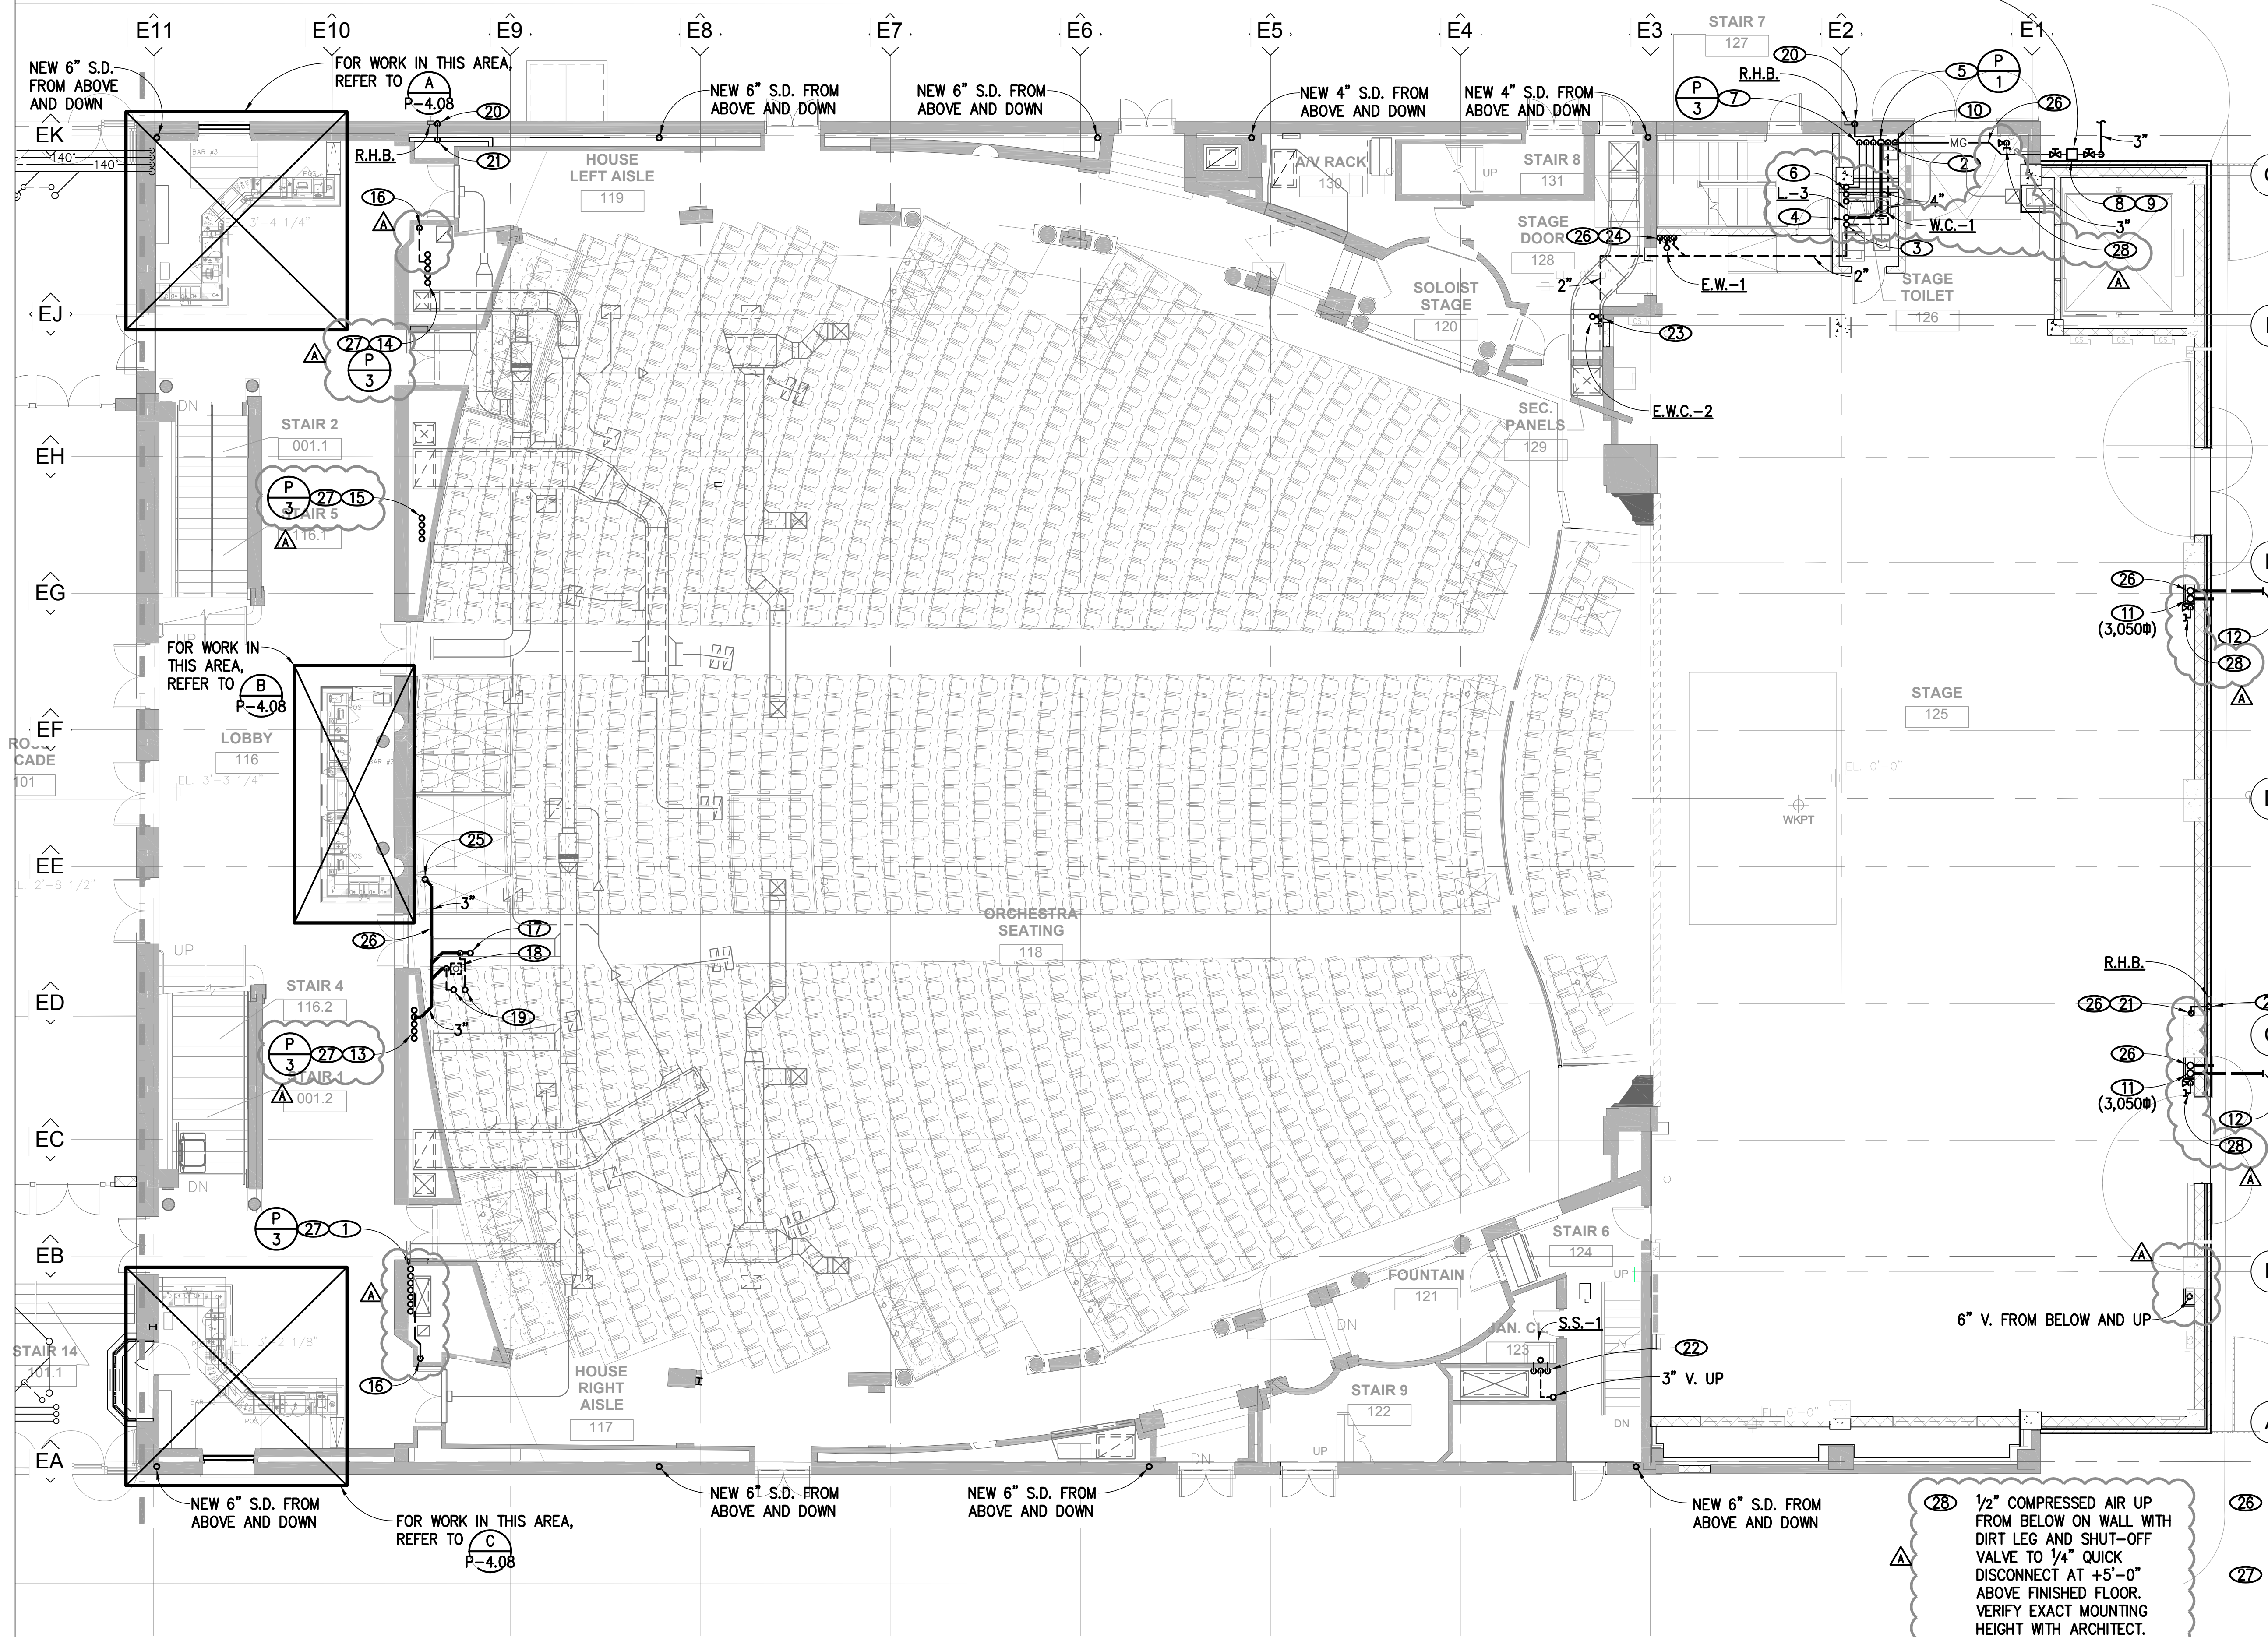

THEATRE - ORCHESTRA LEVEL PLAN

1/8" = 1'-0"

1

ISSUED FOR PERMIT

© 2010 M+J