


Level 1

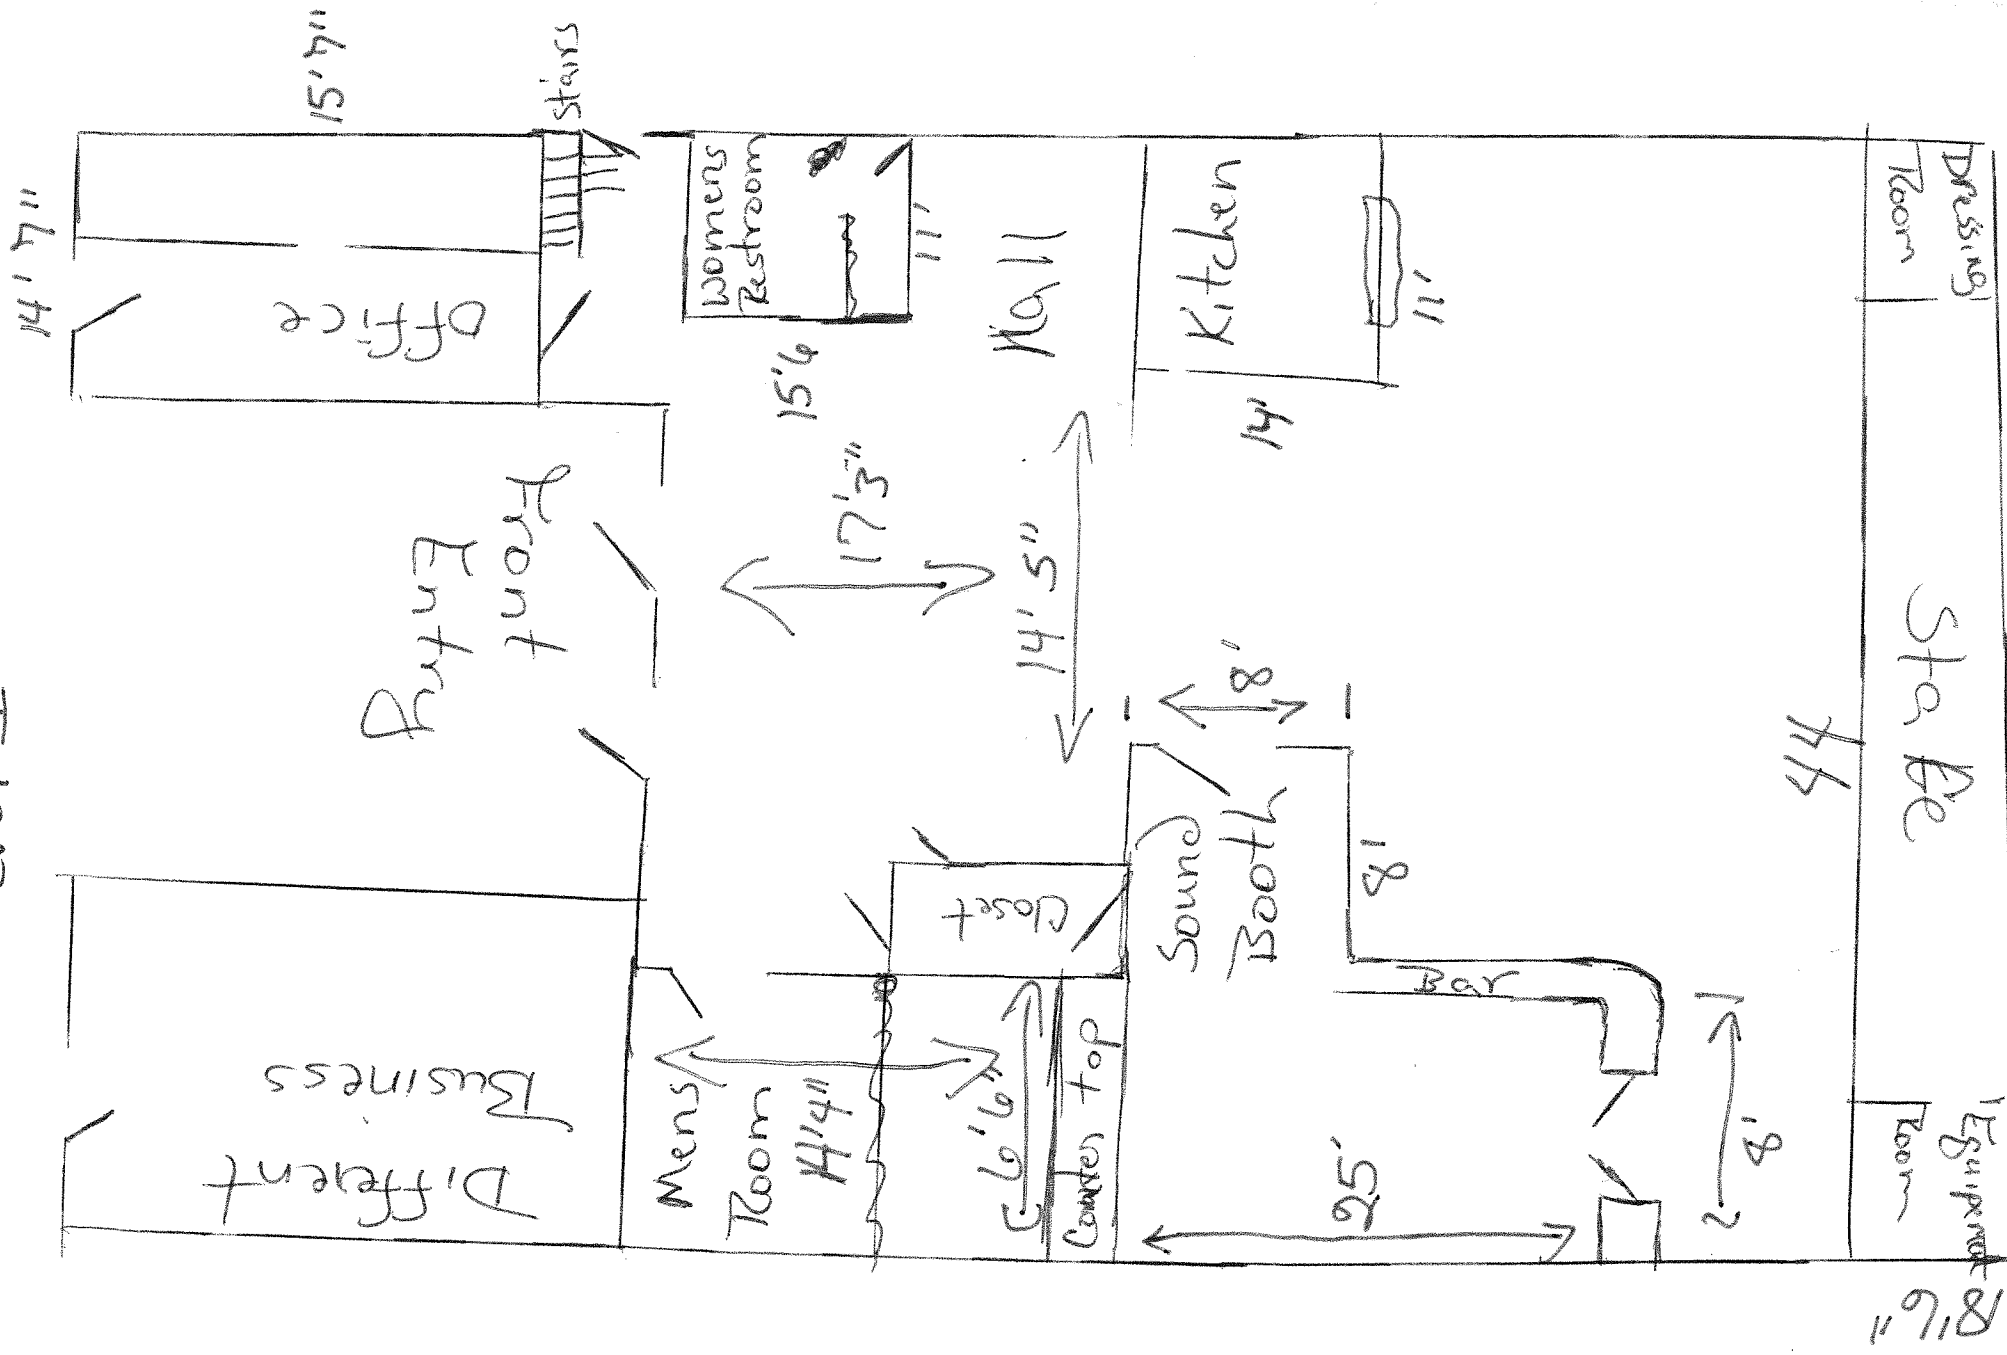

14' 7"

Office

15' 51"

stairs

Womens Restroom

11'

Hall

Kitchen

11'

14'

Front Entry

15' 6"

17' 3"

14' 5"

Sound Booth

18'

18'

Bar

25'

18' 2"

Different Business

Mens Room

11' 4"

Closet

6' 6" Counter top

Dressing Room


Equipment Room

8' 6"

7h