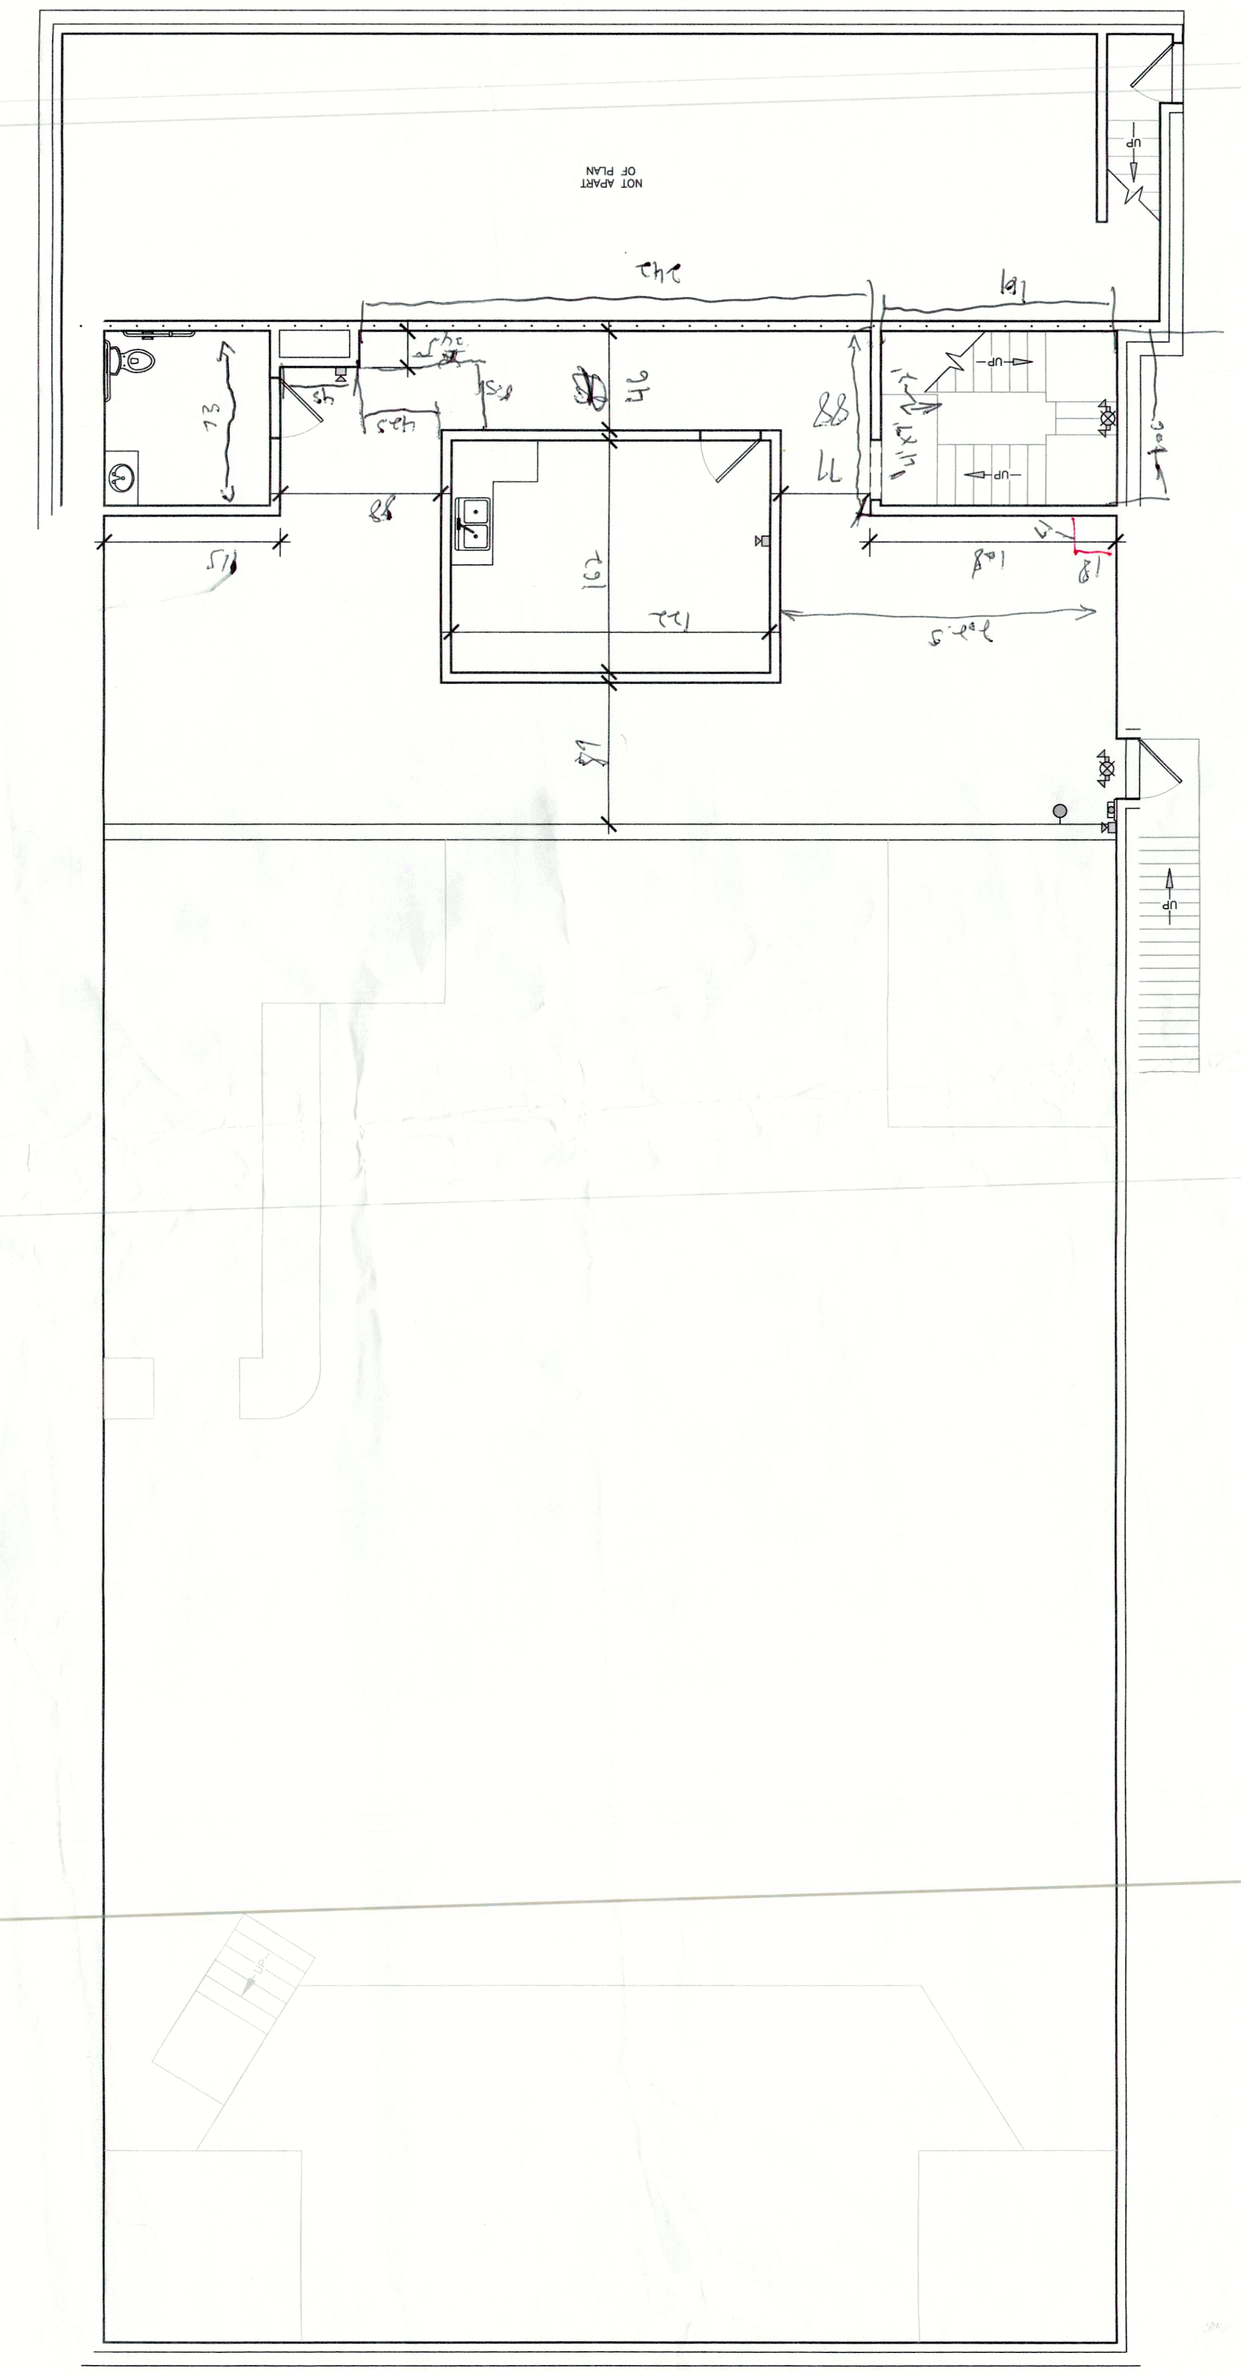
NOT APART
OF PLAN
UP
UP
UP

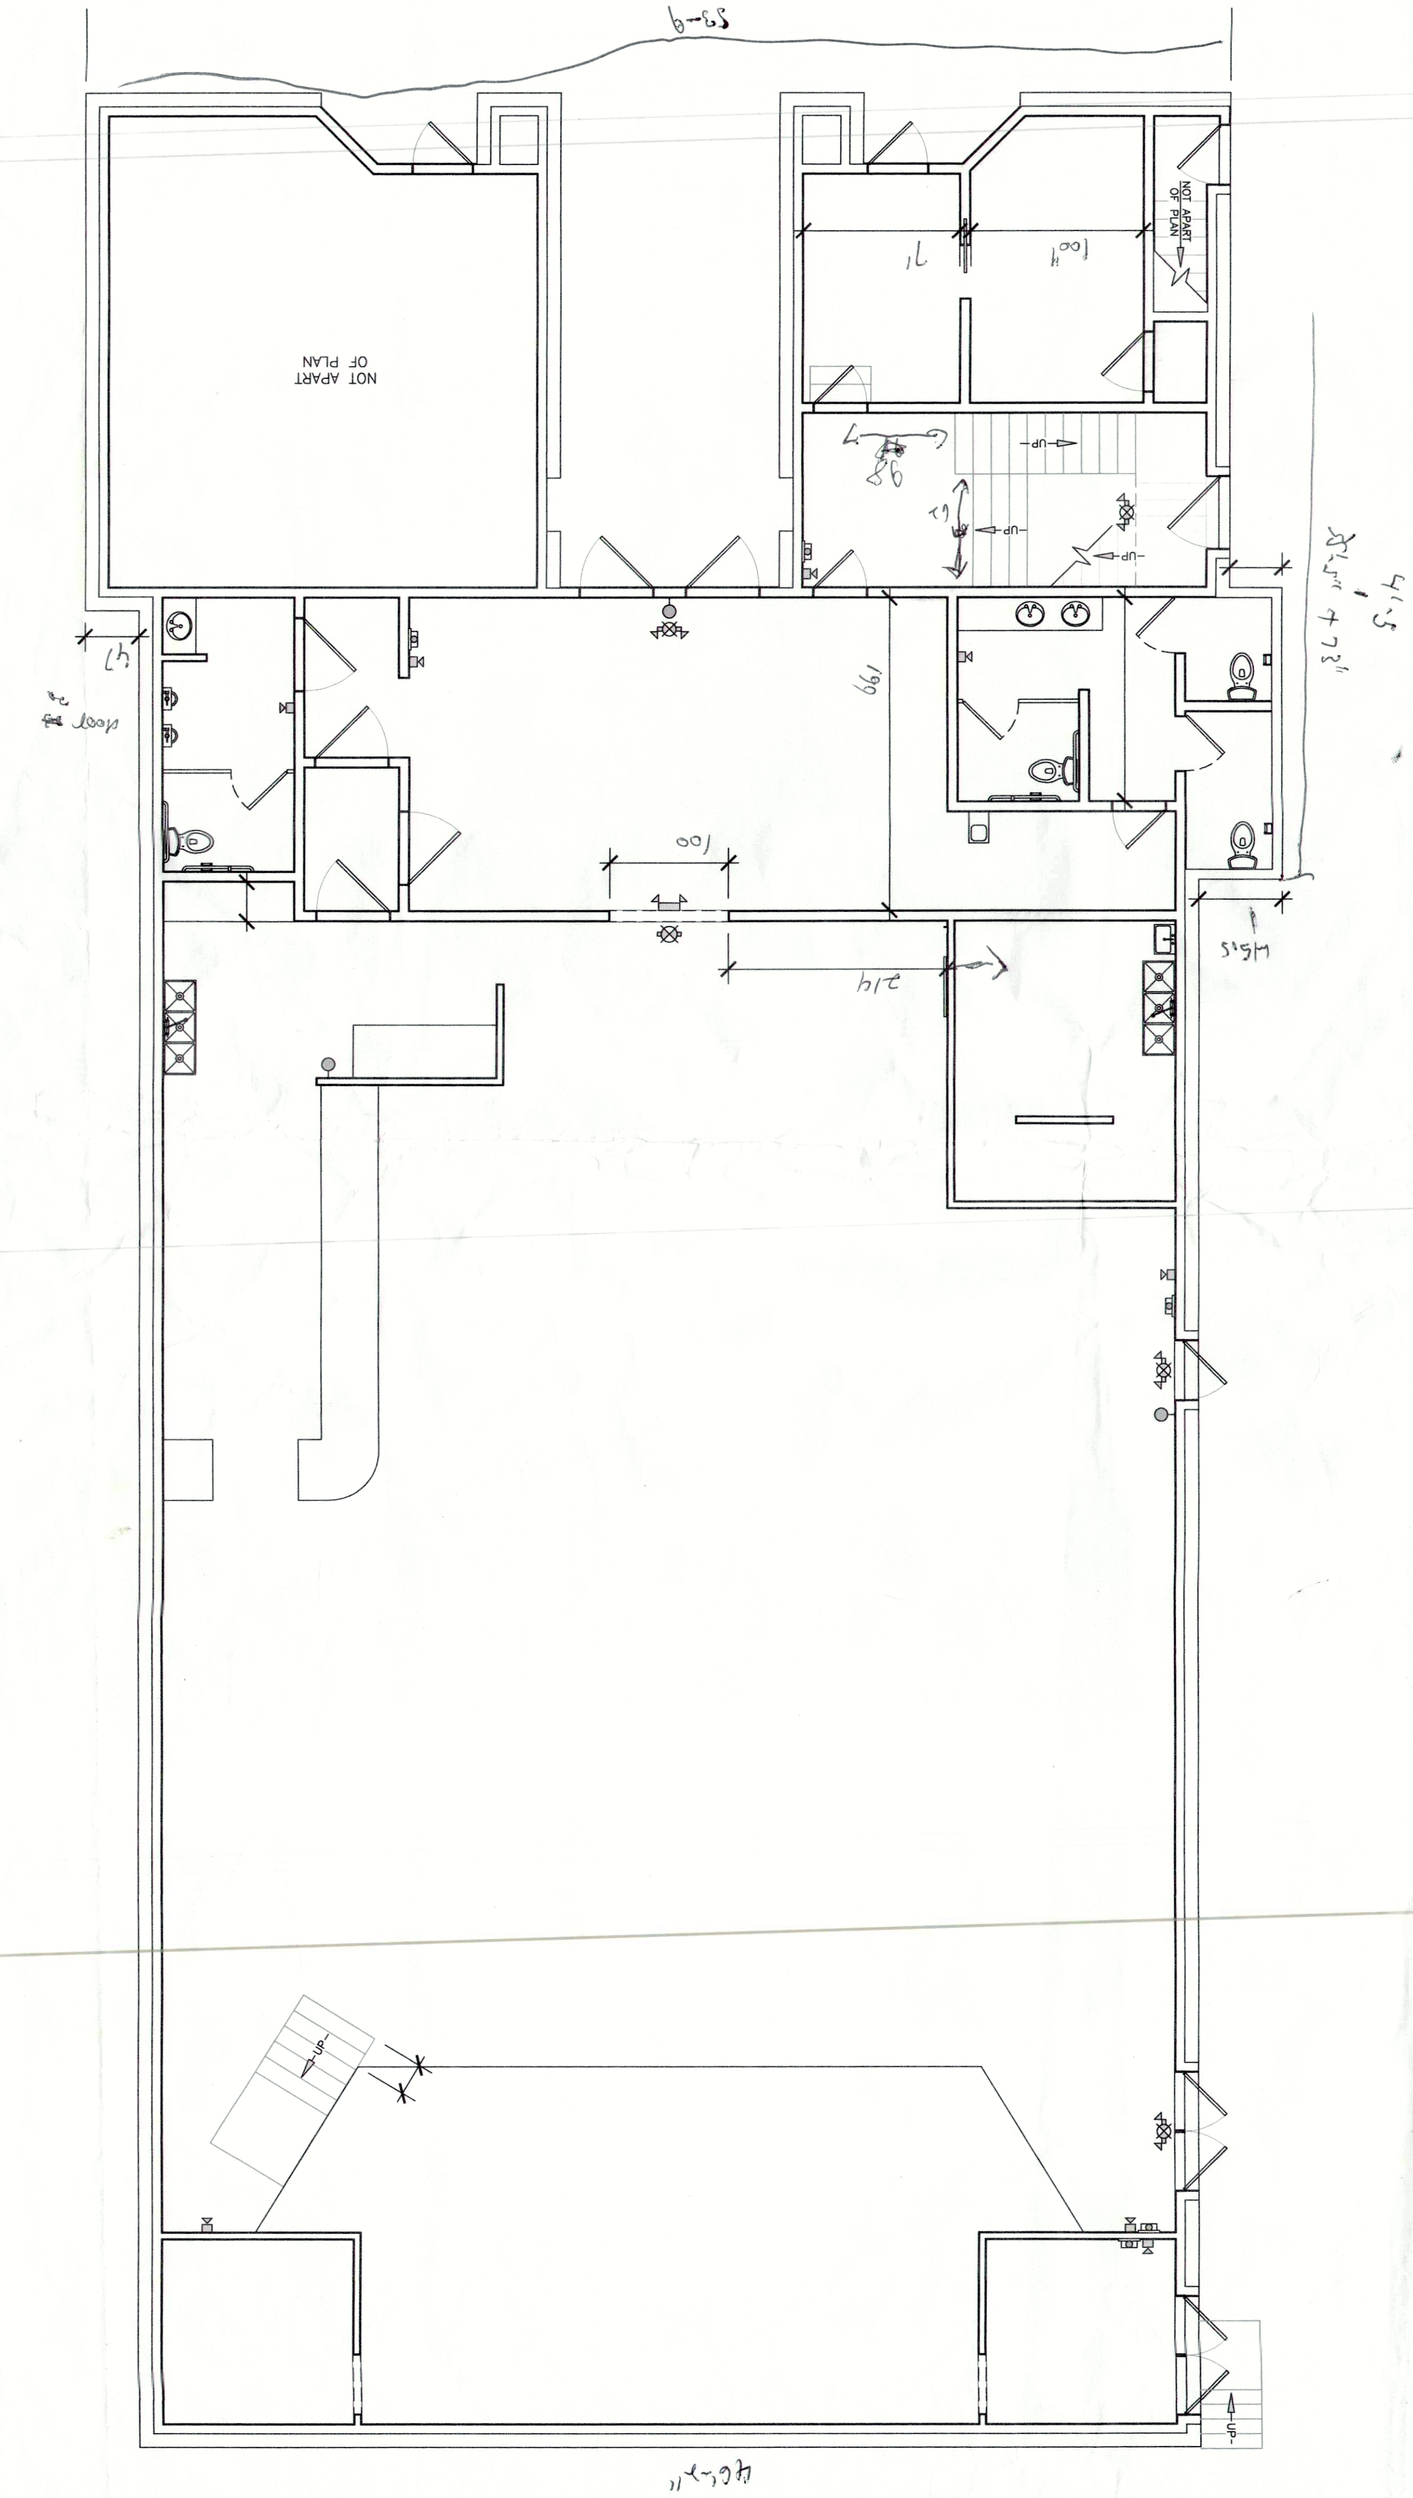
NOT APART
OF PLAN
NOT APART
OF PLAN
UP
UP
UP
UP
UP
UP