





 MATCH @ 5/12 P

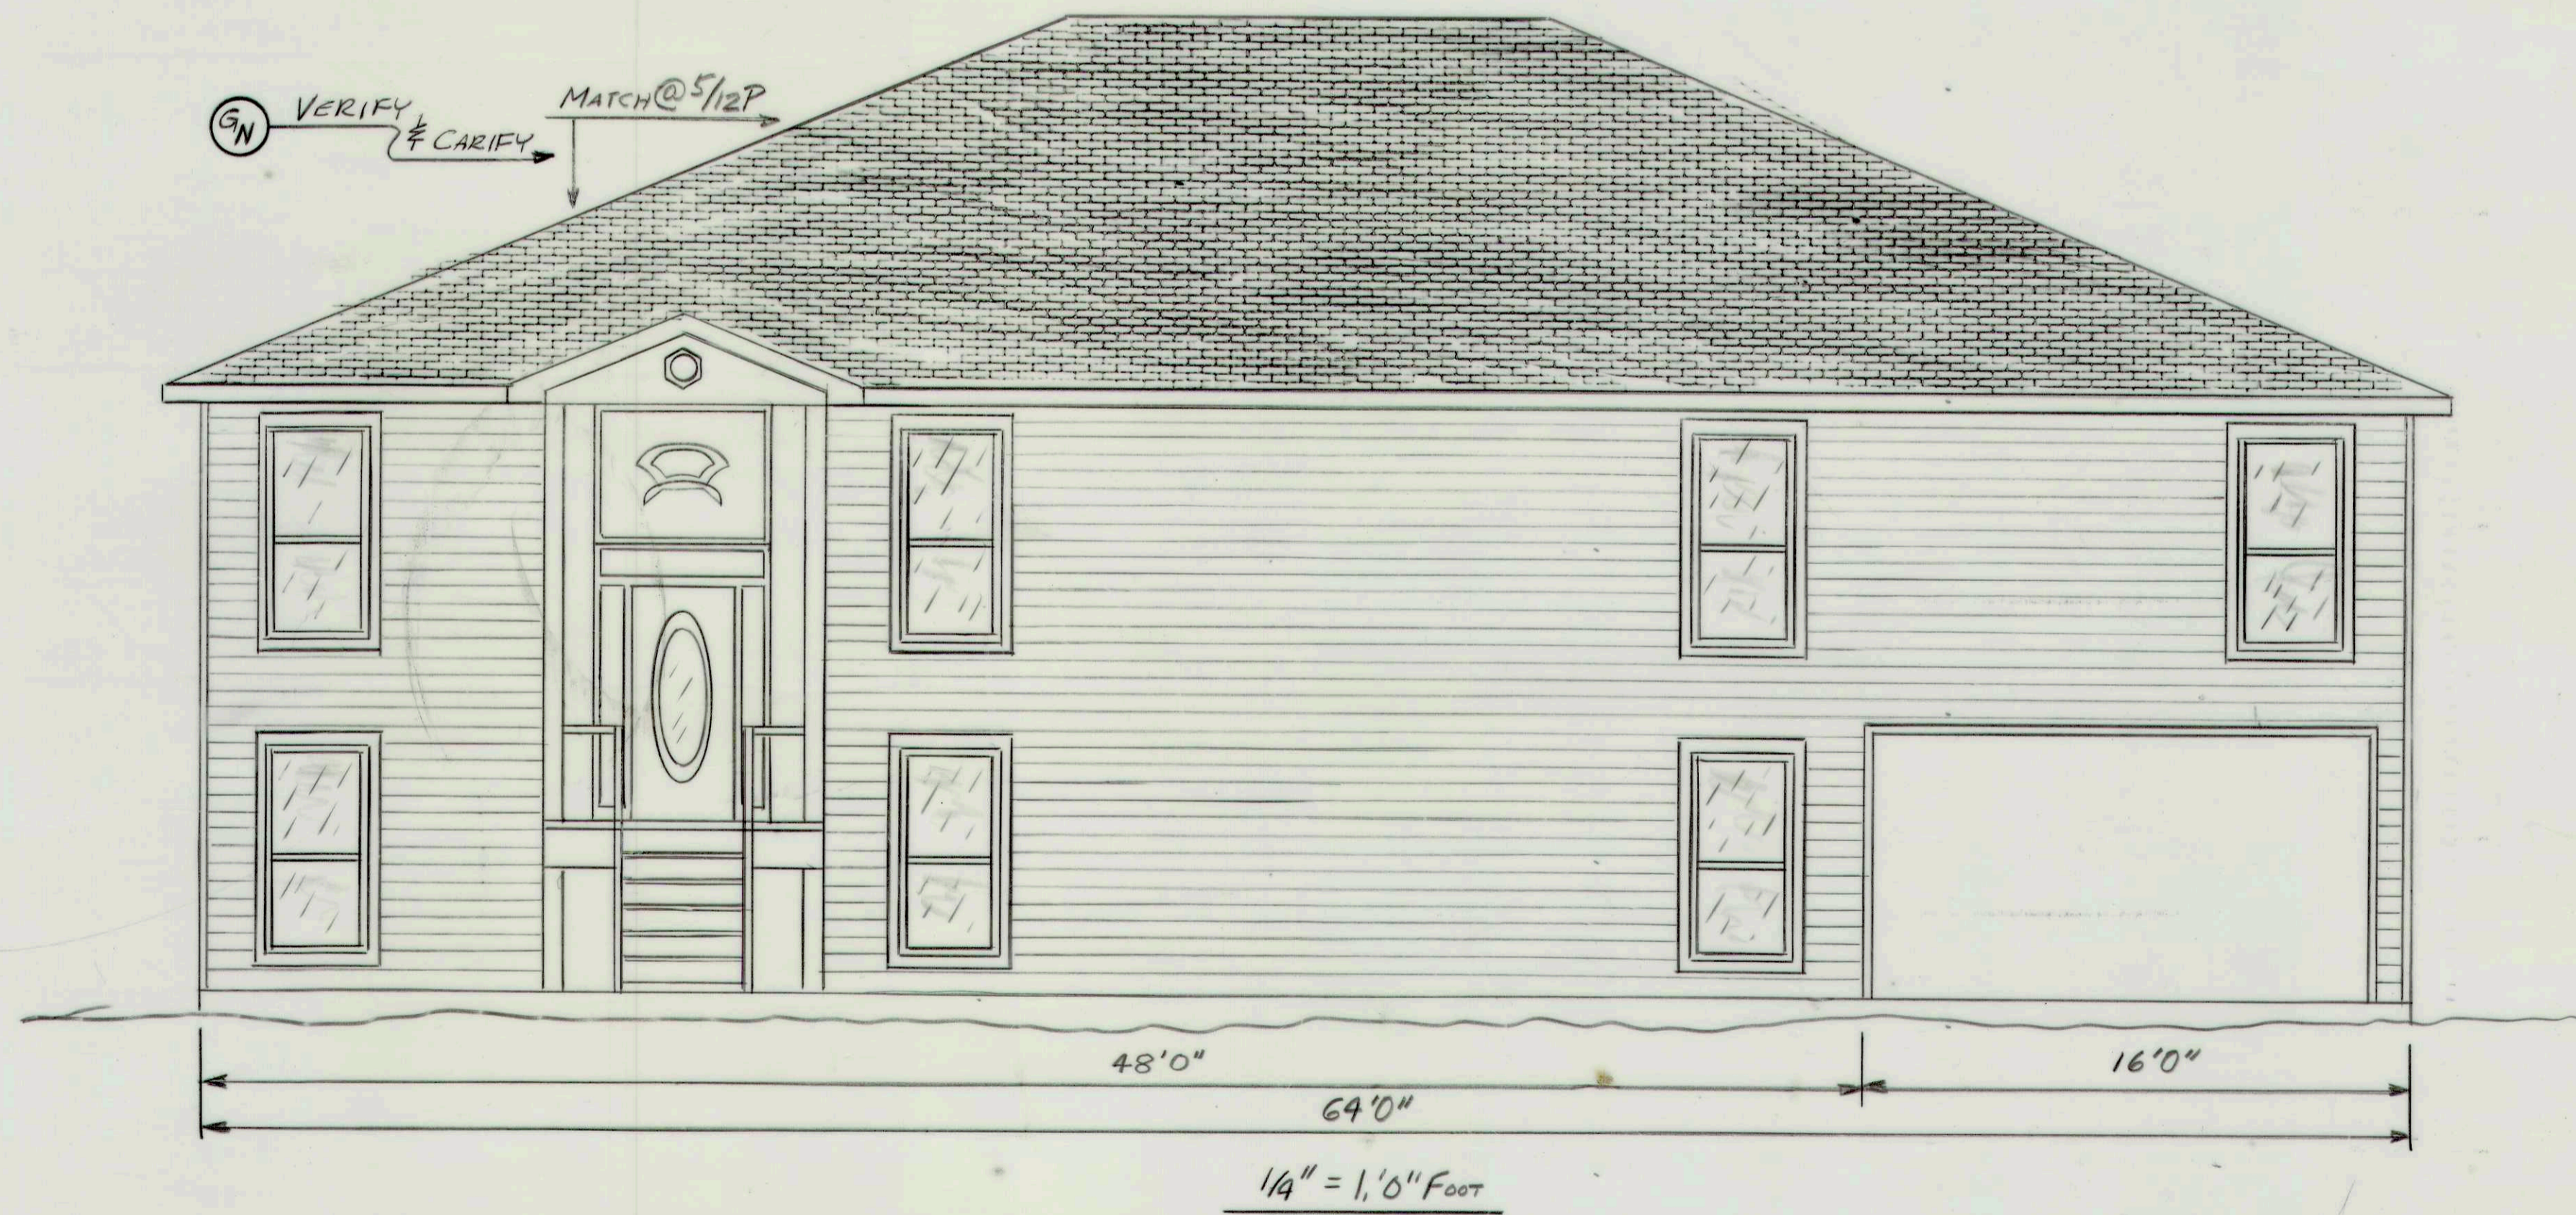