NOTE ACCORDING TO H U D F I A FLOOD HAZARD BOUNDARY MAP H 01 76
THIS PROPERTY IS
____ NOT IN A FLOOD PRONE AREA
X IS LOCATED IN FLOOD ZONE A-10

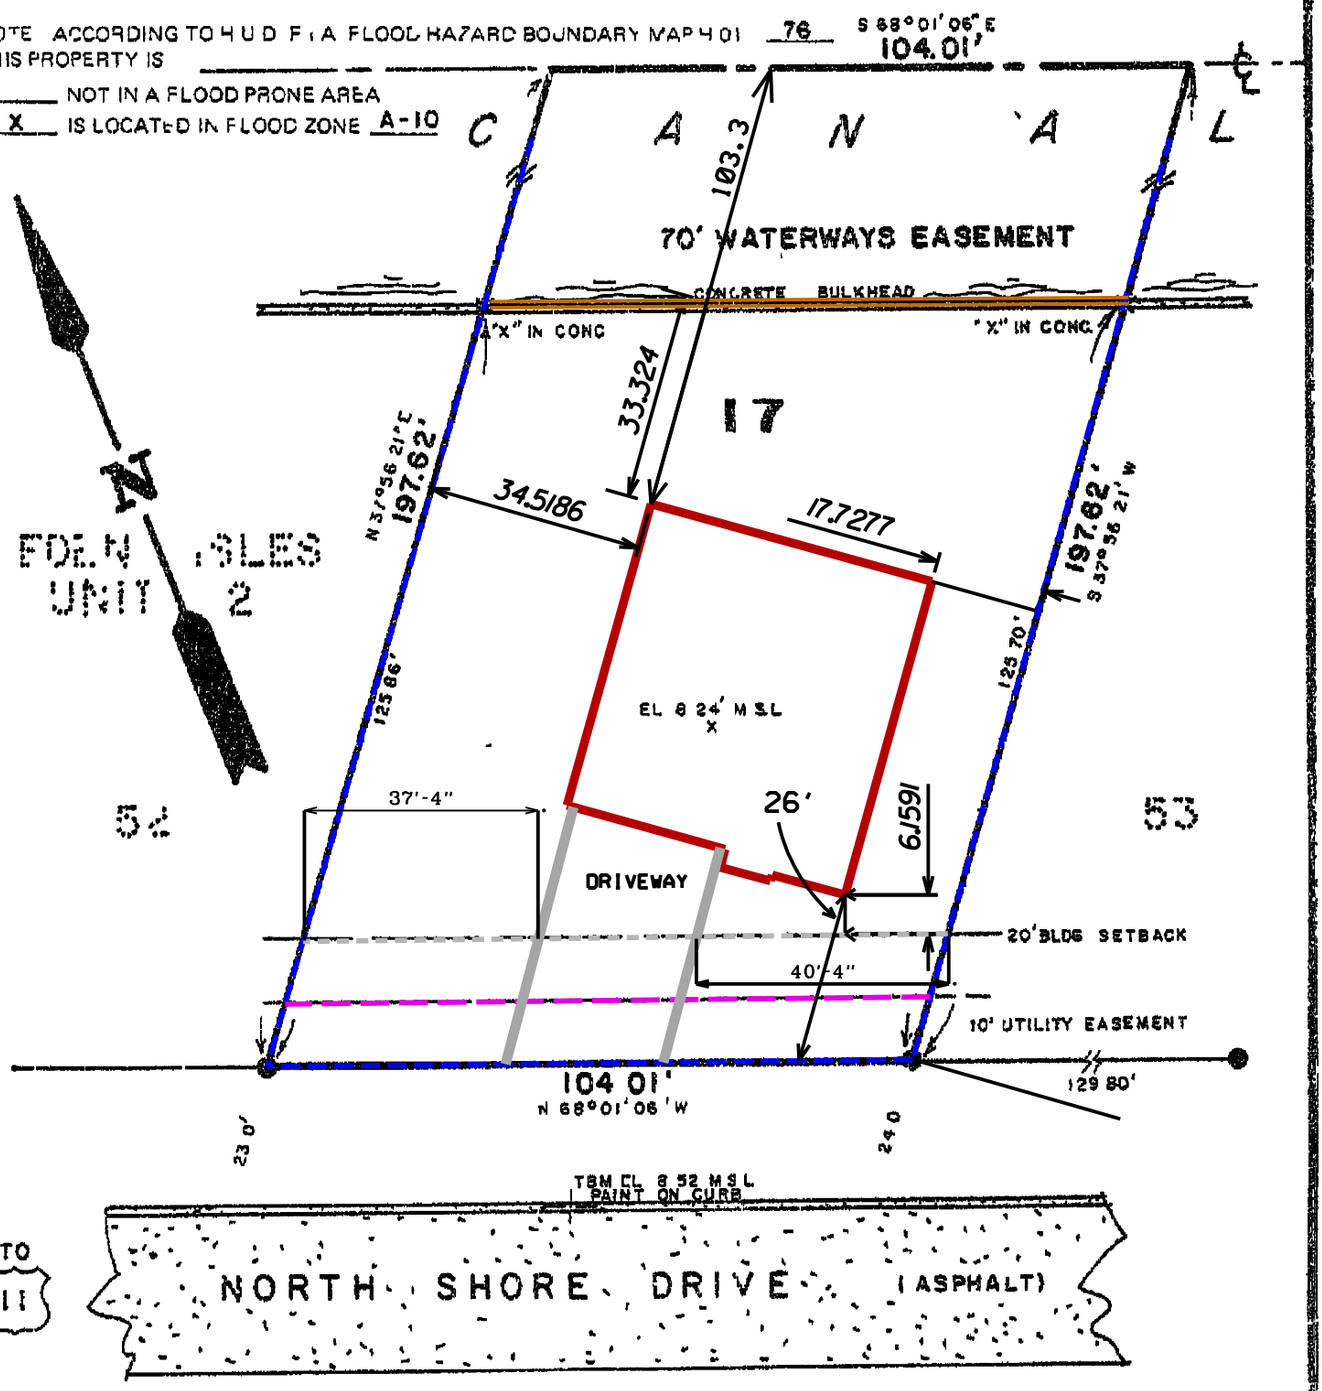

NOTE SETBACKS AND EASEMENTS ARE AS ESTABLISHED FOR EDEN ISLES S/D
REF RECORDED S/D PLATS, PONTLAKE ESTATES & EDEN ISLES UNIT 2

○ SET IRON
● FOUND IRON
⊙ FENCE POST

SCALE 1" = 30'

MAP SHOWING SURVEY OF A PORTION OF LOT 17,

SUBDIVISION PONTLAKE ESTATES, LOCATED IN SECTIONS 32 & 33, T9S - R14E, G.L.D, NEAR THE CITY OF SLIDELL, ST TAMMANY PARISH, LOUISIANA

FOR PAUL MICHEL

STATE OF LOUISIANA
ALBERT A. LOVELL
9302
REGISTERED
SURVEYOR

TO ALL PARTIES INTERESTED IN TITLE TO PREMISES SURVEYED
I HEREBY CERTIFY THAT THE ABOVE SHOWN SURVEY WAS ACTUALLY MADE ON THE GROUND, AS PER RECORD DESCRIPTION AND IS CORRECT AND THAT THERE ARE NO ENCROACHMENTS EITHER WAY ACROSS PROPERTY LINES EXCEPT AS MAY BE NOTED ABOVE

SLIDELL, LOUISIANA

DATE 1 APRIL 1983
JOB NO 96249

ALBERT A LOVELL & ASSOCS, INC
CONSULTING ENGINEERS