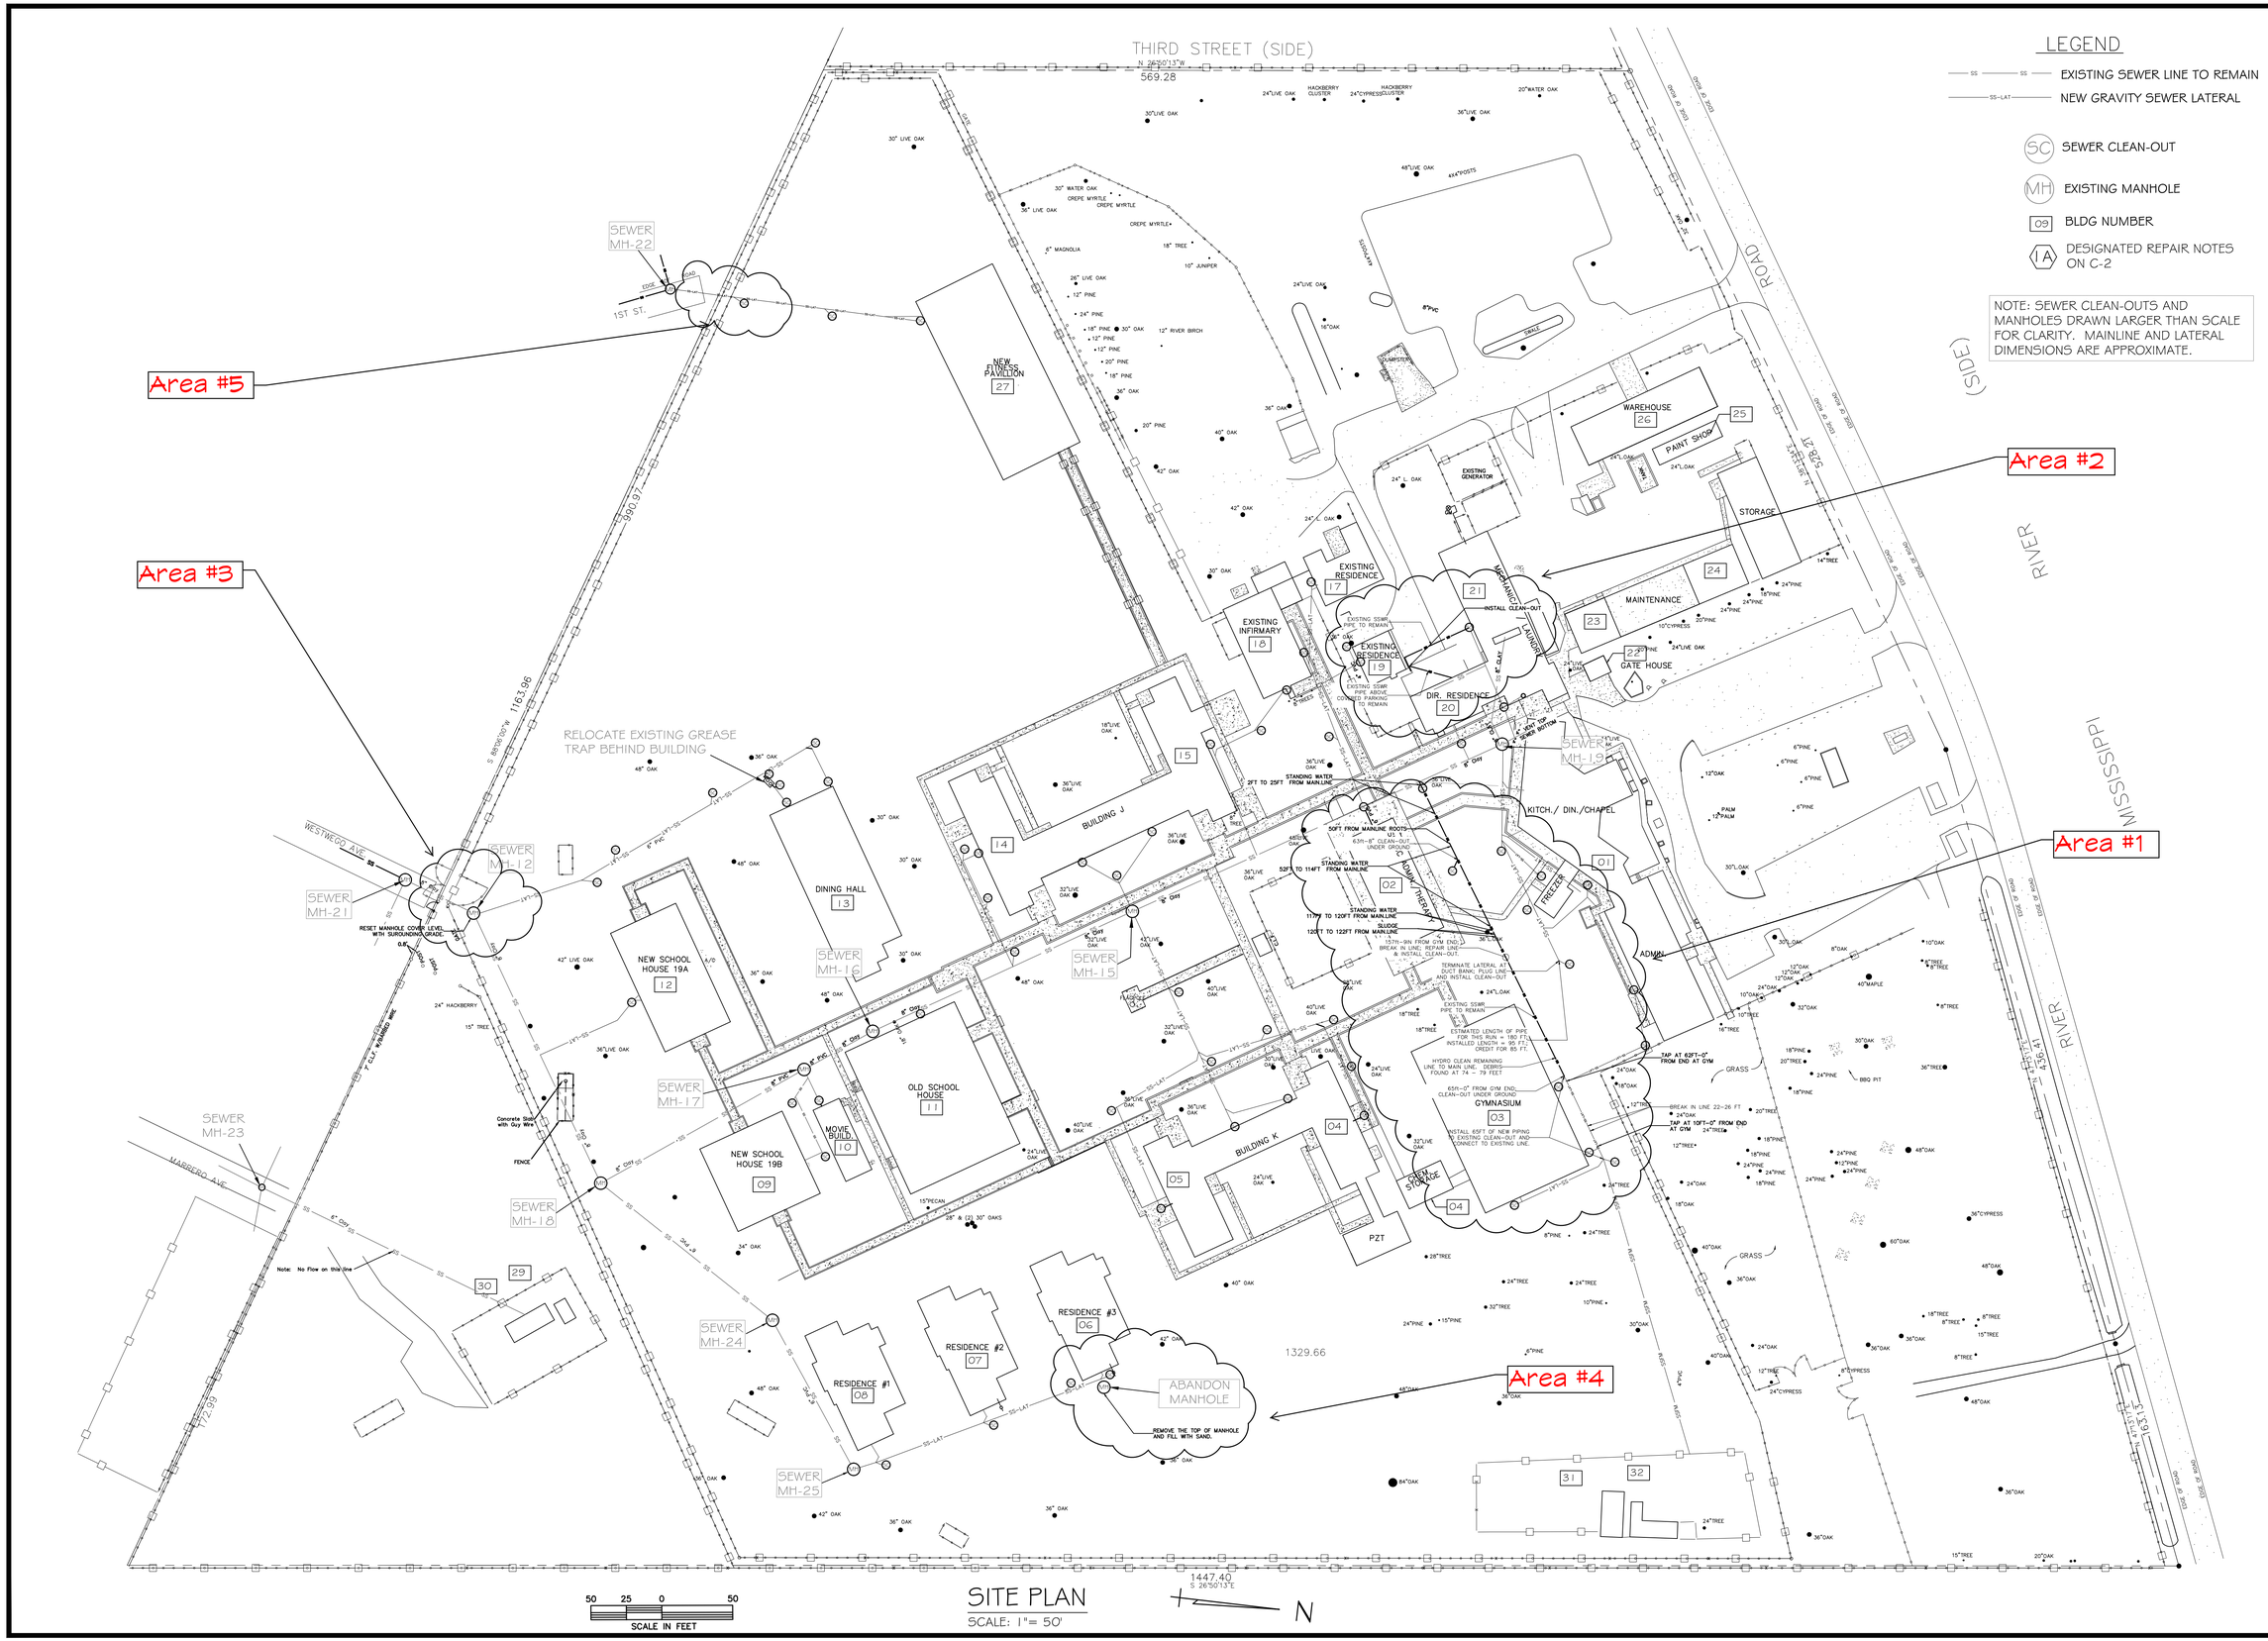

DAMMON ENGINEERING, INC.
554 Old Spanish Trail Slidell, LA 70458 (985) 649-5832
www.dammonengineering.com
info@dammonengineering.com
PH: 985.649.5832

Chief Engineer: Brian Mistich, PE
554 Old Spanish Trail
Slidell, LA 70458

REVISIONS

#	DESCRIPTION	DATE
1	CHANGE ORDER PROPOSAL REQUEST #1	7/31/2017

SEAL:

SEWER SYSTEM RENOVATION;
PROJECT NUMBERS: 08-403-11-01 PART 1 &
08-403-04B-01, PART 20 & 01-107-06B-11, Part U7

BRIDGE CITY CENTER FOR YOUTH

3225 RIVER ROAD
BRIDGE CITY, LA 70094

JOB No:	2154	DATE:	10/1/2016
DRAWN BY:	DPD	CHECKED BY:	BAM

The data contained in any part of Dammon Engineering's work product is proprietary and shall not be reproduced or disclosed to others, nor used for construction work or any other purpose other than the specific project for which it was prepared and delivered by Dammon Engineering. Any reproduction or disclosure of this data to others, or use for construction work or any other purpose other than the specific project for which it was prepared and delivered by Dammon Engineering, is prohibited. 

SHEET TITLE:
SITE PLAN

DRAWING NUMBER:
C-3

SHEET No: 4 of 5