AIR HANDLING UNIT SCHEDULE

TAG	SERVICE	CONFIGURATION	AIRFLOW (CFM)	Fan: EXT. S.P. ("WC)	Fan: WHEEL	Fan: MAX. MOTOR H.P.	Motor: VAC	Motor: PH	Motor: HZ	CHW Cooling Coil: TOTAL MBH	CHW Cooling Coil: SENSIBLE MBH	CHW Cooling Coil, Air Side: ENT. FDB	CHW Cooling Coil, Air Side: ENT. FWB	CHW Cooling Coil, Air Side: MAX. DP (" WC)	CHW Cooling Coil, Water Side: GPM	CHW Cooling Coil, Water Side: ENT. (DEG F)	CHW Cooling Coil, Water Side: DP ("WC)	HW Heating Coil: SENSIBLE MBH	HW Heating Coil, Air Side: ENT. FDB	HW Heating Coil, Air Side: DP ("WC)	HW Heating Coil, Water Side: GPM	HW Heating Coil, Water Side: ENT (DEG F)	HW Heating Coil, Water Side: MAX. DP ("WC)	Filters: MERV RATING	Filters: CPNFIGURATION	CONTROL	MAKE / MODEL	REMARKS
AHU 1	Troop L	Vertical Draw Thru Ublast	11,010	2.0	AF	10	460	3	60	450	326	82.0	67.0	0.8	75	44	10	560	66.8	0.6	36	180	5	8	Angled, Side Access	VFD w/ NEMA 1 Disconnect	York XTI-54X84	1, 2, 3, 4, 5, 6, 7, 8

1. Performance to be rated in accordance with AHRI standard 210/280 for ASHRAE standard design weather conditions in New Orleans, LA.
2. Unit to be of double wall insulated construction with base rail and internal vibration isolation.
3. Provide spare set of filters for installation after after commissioning and final acceptance.
4. Install unit in accordance with manufacturer's recommendations.
5. Furnish with duct mounted smoke detector for fan shut down.
6. Furnish with matching duct mounted SP sensor.
7. Reference specifications for additional requirements.
8. Naming a certain brand, make or manufacturer is to designate the general style, type, character and quality standard of the product desired. See Specifications for additional approved Manufactures and models. Substitution requests shall be submitted prior to bid.

CONTRACTOR NOTE:

SCOPE OF WORK (SOW) INCLUDES BUT IS NOT LIMITED TO THE INSTALLATION OF A VARIABLE AIR VOLUME (VAV) SYSTEM AS SHOWN ON THESE PLANS. THIS INCLUDES THE PROCUREMENT AND INSTALLATION OF AN AIR HANDLING UNIT, VAV BOXES DIFFUSERS, DUCTWORK, PIPING, CONTROLS AND APPURTANCES AS REQUIRED FOR A COMPLETE AND FUNCTIONAL SYSTEM IN ACCORDANCE WITH CURRENT CODES AND STANDARDS. REFERENCE SPECIFICATIONS FOR ADDITIONAL REQUIREMENTS..

GENERAL HVAC DETAIL NOTES

1. ALL MECHANICAL WORK SHALL BE COORDINATED WITH THE WORK OF OTHER TRADES.
2. VERIFY ROUTING OF ALL WORK ON SITE.
3. HVAC CONTRACTOR REPLACE ALL EQUIPMENT FILTERS AT THE TIME OF POSSESSION OF THE PROJECT BY THE OWNER, USING ONLY NEW FILTERS OF THE PROPER SIZE AND TYPE.
4. CONTRACTOR SHALL LEAVE THE HVAC SYSTEM IN PROPER WORKING ORDER AND SHALL GUARANTEE SAME FOR A PERIOD OF TWELVE (12) MONTHS FROM THE DATE OF SUBSTANTIAL COMPLETION.
5. WHERE MOUNTING HEIGHTS ARE NOT INDICATED OR DIMENSIONED, INSTALL MECHANICAL SERVICES AND OVERHEAD EQUIPMENT TO PROVIDE THE MAXIMUM HEADROOM POSSIBLE.
6. FIELD VERIFY DIMENSIONS AND INTERFERENCES PRIOR TO FABRICATION, AND INSTALLATION.
7. INSTALL FIRE DAMPERS PER SMACNA AND NFPA STANDARDS.
8. INSULATE PIPING AND DUCTS PER SPECIFICATIONS. INSULATION SHALL BE APPLIED AFTERLEAK TESTING AND AFER REVIEW AND APPROVAL BY DAMMON ENGINEERING.
9. REFERENCING SPECIFICATIONS FOR ADDITIONAL REQUIREMENTS..

VAV BOX SCHEDULE

TAG	MAKE/MODEL	SIZE	MINIMUM FLOW CFM	DESIGN FLOW CFM	CONTROL	REMARKS
VAV-1	Johnson Control TSS	10	600	1400	STAND ALONE CONTROL WITH PROGRAMMABLE ROOM SENSOR AND HEAT/COOL SWITCHOVER	1, 2
VAV-2	Johnson Control TSS	8	300	800	STAND ALONE CONTROL WITH PROGRAMMABLE ROOM SENSOR AND HEAT/COOL SWITCHOVER	1, 2
VAV-3	Johnson Control TSS	12	800	1850	STAND ALONE CONTROL WITH PROGRAMMABLE ROOM SENSOR AND HEAT/COOL SWITCHOVER	1, 2
VAV-4	Johnson Control TSS	10	600	1470	STAND ALONE CONTROL WITH PROGRAMMABLE ROOM SENSOR AND HEAT/COOL SWITCHOVER	1, 2
VAV-5	Johnson Control TSS	10	600	1380	STAND ALONE CONTROL WITH PROGRAMMABLE ROOM SENSOR AND HEAT/COOL SWITCHOVER	1, 2
VAV-6	Johnson Control TSS	14	1100	2730	STAND ALONE CONTROL WITH PROGRAMMABLE ROOM SENSOR AND HEAT/COOL SWITCHOVER	1, 2
VAV-7	Johnson Control TSS	8	300	880	STAND ALONE CONTROL WITH PROGRAMMABLE ROOM SENSOR AND HEAT/COOL SWITCHOVER	1, 2
VAV-8	Johnson Control TSS	6	200	500	STAND ALONE CONTROL WITH PROGRAMMABLE ROOM SENSOR AND HEAT/COOL SWITCHOVER	1, 2

FURNISH WITH AIRFLOW SENSOR AND 120/24 V-UL APPROVED TRANSFORMER.

. NAMING A CERTAIN BRAND, MAKE OR MANUFACTURER IS TO DESIGNATE THE GENERAL STYLE, TYPE, HARACTER AND QUALITY STANDARD OF THE PRODUCT DESIRED. SEE SPECIFICATIONS FOR ADDITIONAL PPROVED DEVICES. SUBSTITUTION REQUESTS SHALL BE SUBMITTED PRIOR TO BIDDING.

LEGEND

- EXHAUST GRILLE AND ALL ASSOCIATED DUCT WORK TO REMAIN
- VAV/ZONE NUMBER TAG
- NEW VAV BOX
- RETURN AIR DIFFUSER (SIZED BELOW)
- SUPPLY AIR DIFFUSER (SIZED BELOW)
- TWO (2) WAY SUPPLY AIR GRILLE (SIZED BELOW)
- AIR FLOW DIRECTION
- SUPPLY AIR DUCT BEFORE VAV
- SUPPLY AIR DUCT AFTER VAV
- VAV VARIABLE DAMPER
- RETURN AIR DUCT
- FLEX DUCT
- ELECTRICAL WIRING
- THERMOSTAT, REF SPECIFICATIONS
- CAPPED OFF DUCT
- 1 = CFM FLOW RATE OR RETURN AIR; A = REGISTER/GRILL SIZE SEE BELOW; 2 = ROUND DUCT SIZE FOR SUPPLY OR RETURN DUCT SIZE IN INCHES
- A = 24x24 SUPPLY DIFFUSER
- B = 12x12 SUPPLY DIFFUSER
- C = ROUND SUPPLY DIFFUSER
- D = NOT USED
- E = 24x24 RETURN GRILLE
- F = 12x12 RETURN GRILLE
- DUCT SMOKE DETECTOR, REF SPECIFICATIONS
- DUCT STATIC PRESSURE SENSOR, REF SPECIFICATIONS
- FIRE STAT, REF SPECIFICATIONS
- TEMPERATURE CONTROLLER
- LIMIT OF NEW WORK

ABBREVIATIONS

HWS - HOT WATER SUPPLY	R/A - RETURN AIR
HWR - HOT WATER RETURN	S/A - SUPPLY AIR
CHS - CHILLED WATER SUPPLY	O/A - OUTSIDE AIR
CHR - CHILLED WATER RETURN	
V.D. - VOLUME DAMPER	

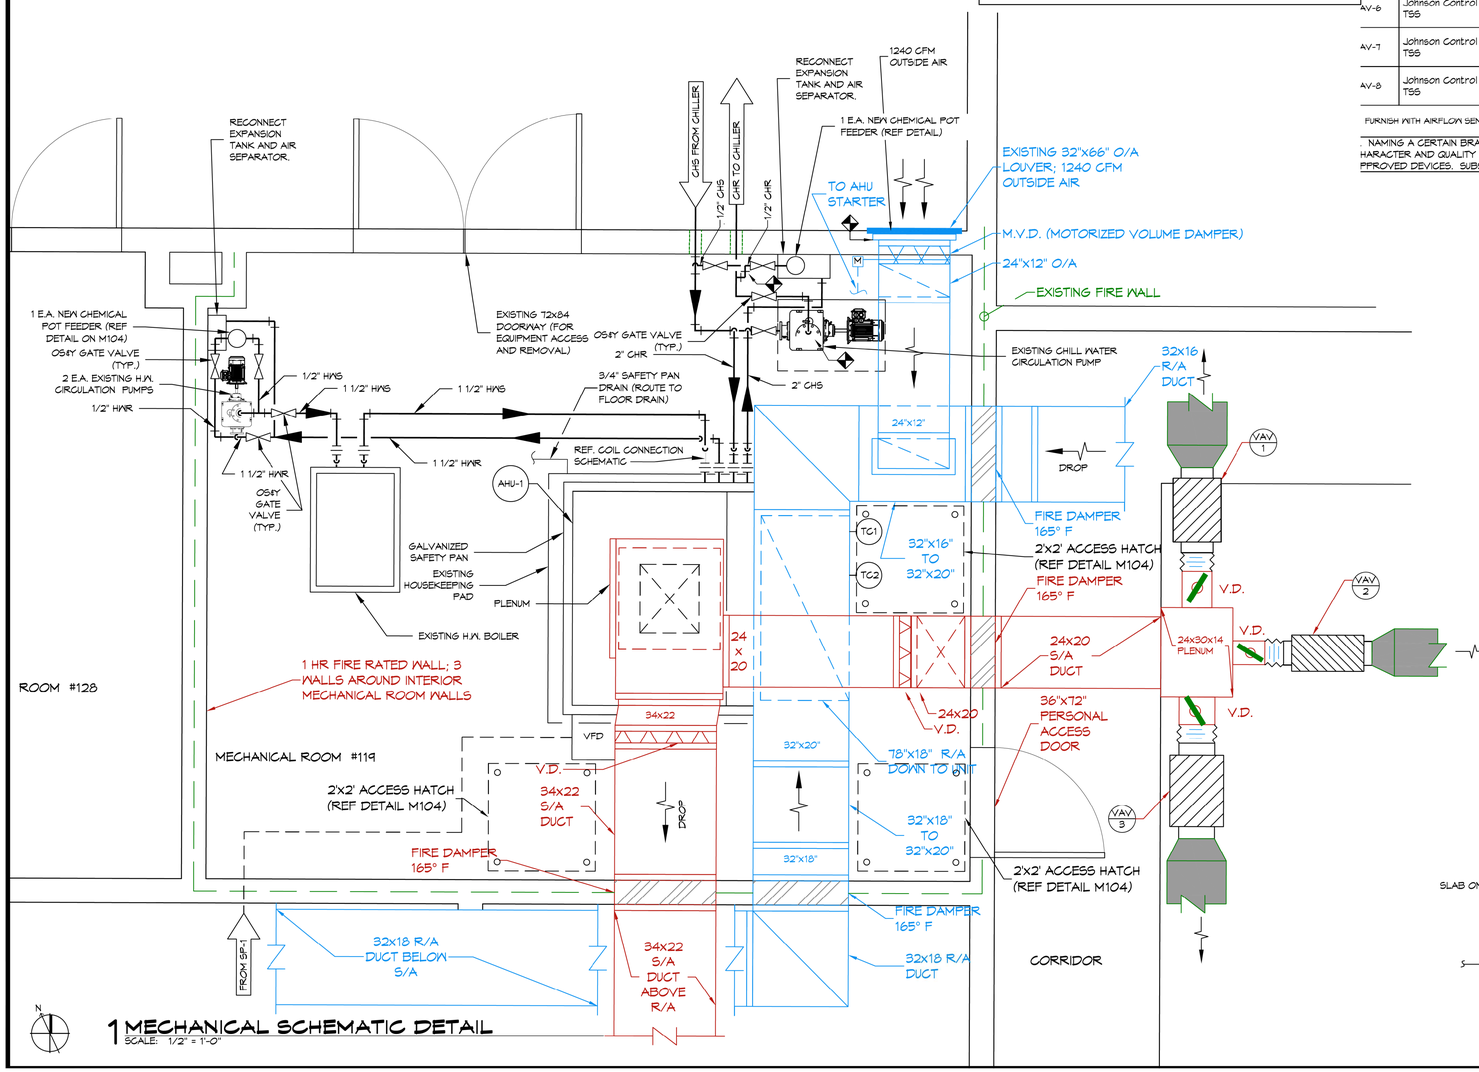

1 MECHANICAL SCHEMATIC DETAIL
SCALE: 1/2" = 1'-0"

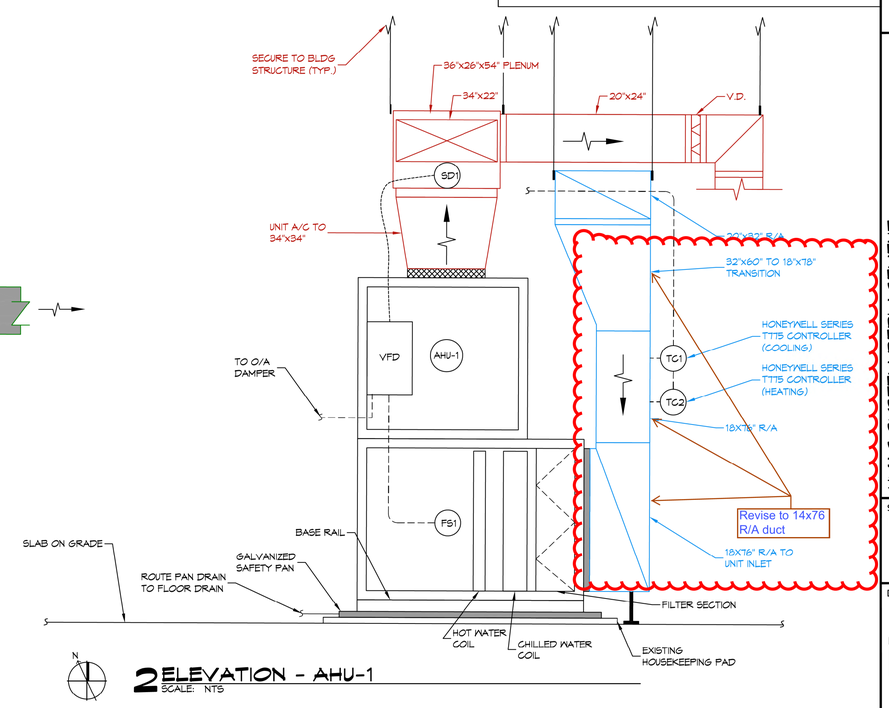

2 ELEVATION - AHU-1
SCALE: NTS

DAMMON ENGINEERING, INC.
LOUISIANA & MISSISSIPPI
www.dammonengineering.com
info@dammonengineering.com
PH: 985-845-3821
Chief Engineer: Brian Mistich, PE
554 Old Spanish Trail
Slidell, LA 70458

REVISIONS

#	DESCRIPTION	DATE

SEAL:

STATE OF LOUISIANA — BRIAN A. MISTICH, License No. 30187, 4/21/2021, PROFESSIONAL ENGINEER

HVAC SYSTEM REPLACEMENT
PROJECT NO.: 01-107-06B-11, F.0100380T

STATE POLICE TROOP L HEADQUARTERS

2600 N CAUSEWAY BLVD, MANDEVILLE, LA 70471
STATE ID: 500814 SITE CODE: 1-52-004

JOB No:	23-72	DATE:	7/25/2019
DRAWN BY:	BLP	CHECKED BY:	PD

The data shown on any plans, drawings, specifications, reports, and supplements prepared for the use of the Dammon Engineering, Inc. (DEI) client is the property of DEI. The client is the only party to whom DEI shall release such data and documents upon payment in full for all services rendered by DEI. The client agrees that such data and documents will not be used for any purpose other than those for which the data were created and developed without written consent of DEI. The client agrees that any other party who receives such data or documents from the client shall be informed of the preceding restrictions.

SHEET TITLE:
MECHANICAL DETAILS

DRAWING NUMBER:
M102C

SHEET No: 7 of 10

FILE NAME: J:\- Government\1373 - Troop L State Police HVAC Renovation\Drawings\Current Drawings\M102 - Mechanical AHU & Controls Plan.dwg PLOT DATE & TIME: Friday, August 30, 2019 9:23:24 PM