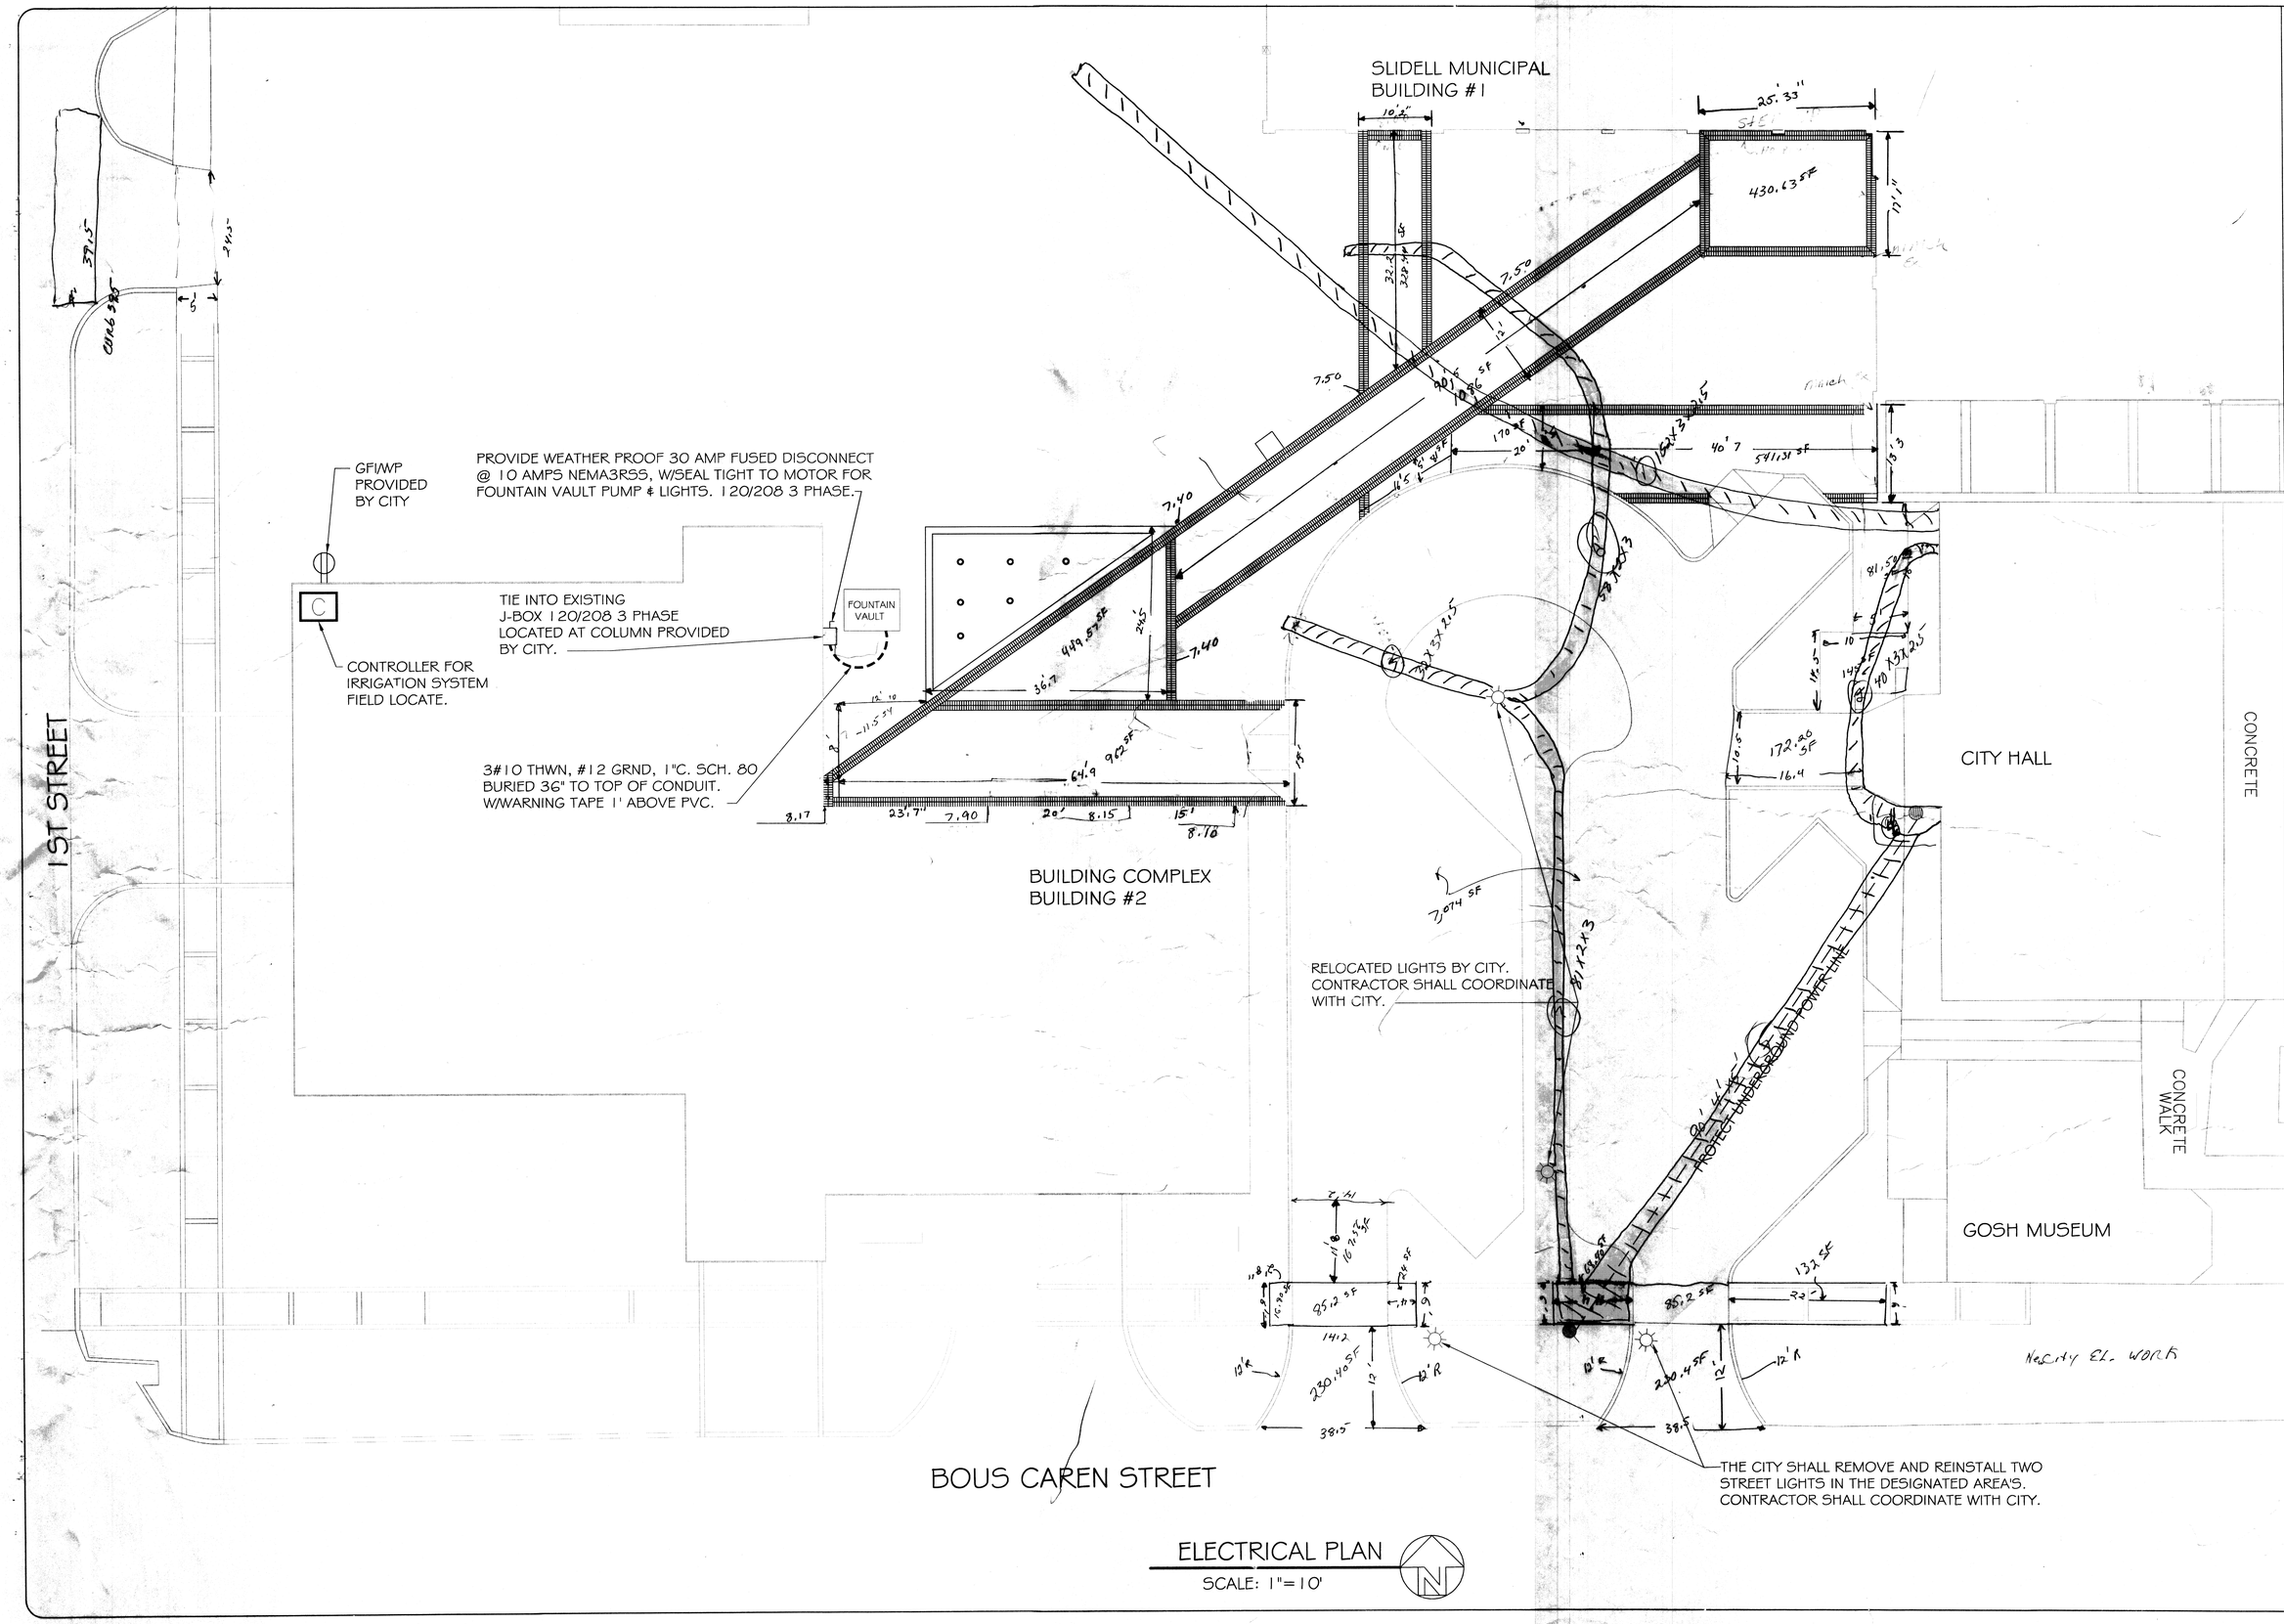

ELECTRICAL PLAN

SCALE: 1"=10'

DAMMON ENGINEERING, INC.
Architects & Engineers

dammoneng@bellsouth.net
PHONE: 985-649-5832
FAX: 985-641-5950

CHIEF ENGINEER: EMMETT DAMMON, P.E.
CHIEF ARCHITECT: KEVIN KINCHEN
554 OLD SPANISH TRAIL
SLIDELL, LA 70458

The above drawings and specifications, designs and ideas herein are the property of Dammon Engineering and remain the property of Dammon Engineering and no copies in connection w/ any work or projects other than those for which they are specifically prepared are permitted without written consent of Dammon Engineering. Visual contact with these drawings or specifications shall constitute conclusive evidence of acceptance of these restrictions.

CITY HALL PARKING LOT & COURT YARD

BOUS CAREN STREET
SLIDELL, LA

JOB No:	2172	DATE:	08-16-13
DRAWN BY:	CKD	CHECKED BY:	CKD

REVISIONS

#	DESCRIPTION	DATE