

CHANGE ORDER FORM

CITY OF SLIDELL, LOUISIANA

Change Order No.: 1

Date: 1-24-14

Contract Recordation Date: _____

Instrument No.: _____

Name of Project: City Hall Parking Lot and Courtyard

Project No.: 600-129

Engineer: DAMMON ENGINEERING, INC.

Contractor: SAUCIER CONSTRUCTION CO., INC.

It is hereby mutually agreed that when this change order has been signed by the contracting parties the following described changes in the work required by the contract shall be executed by the contractor without changing the terms of the contract except as herein stipulated and agreed.

Description of Changes: SEE ATTACH SHEET

Justification for Changes: Redesign DRAINAGE, add curb, Pond


Contractor's Proposal for the Above Described Change:

I/We hereby agree to the modifications of the contract as described above and furnish all materials and labor and perform all work in connection therewith in accordance with the requirements for similar work in existing contract except as otherwise stipulated herein, for the following consideration:

Name of Project: City Hall Parking Lot and Courtyard

Contractor: SAUCIER CONSTRUCTION CO. INC.

[Signature]
Contractor's Signature

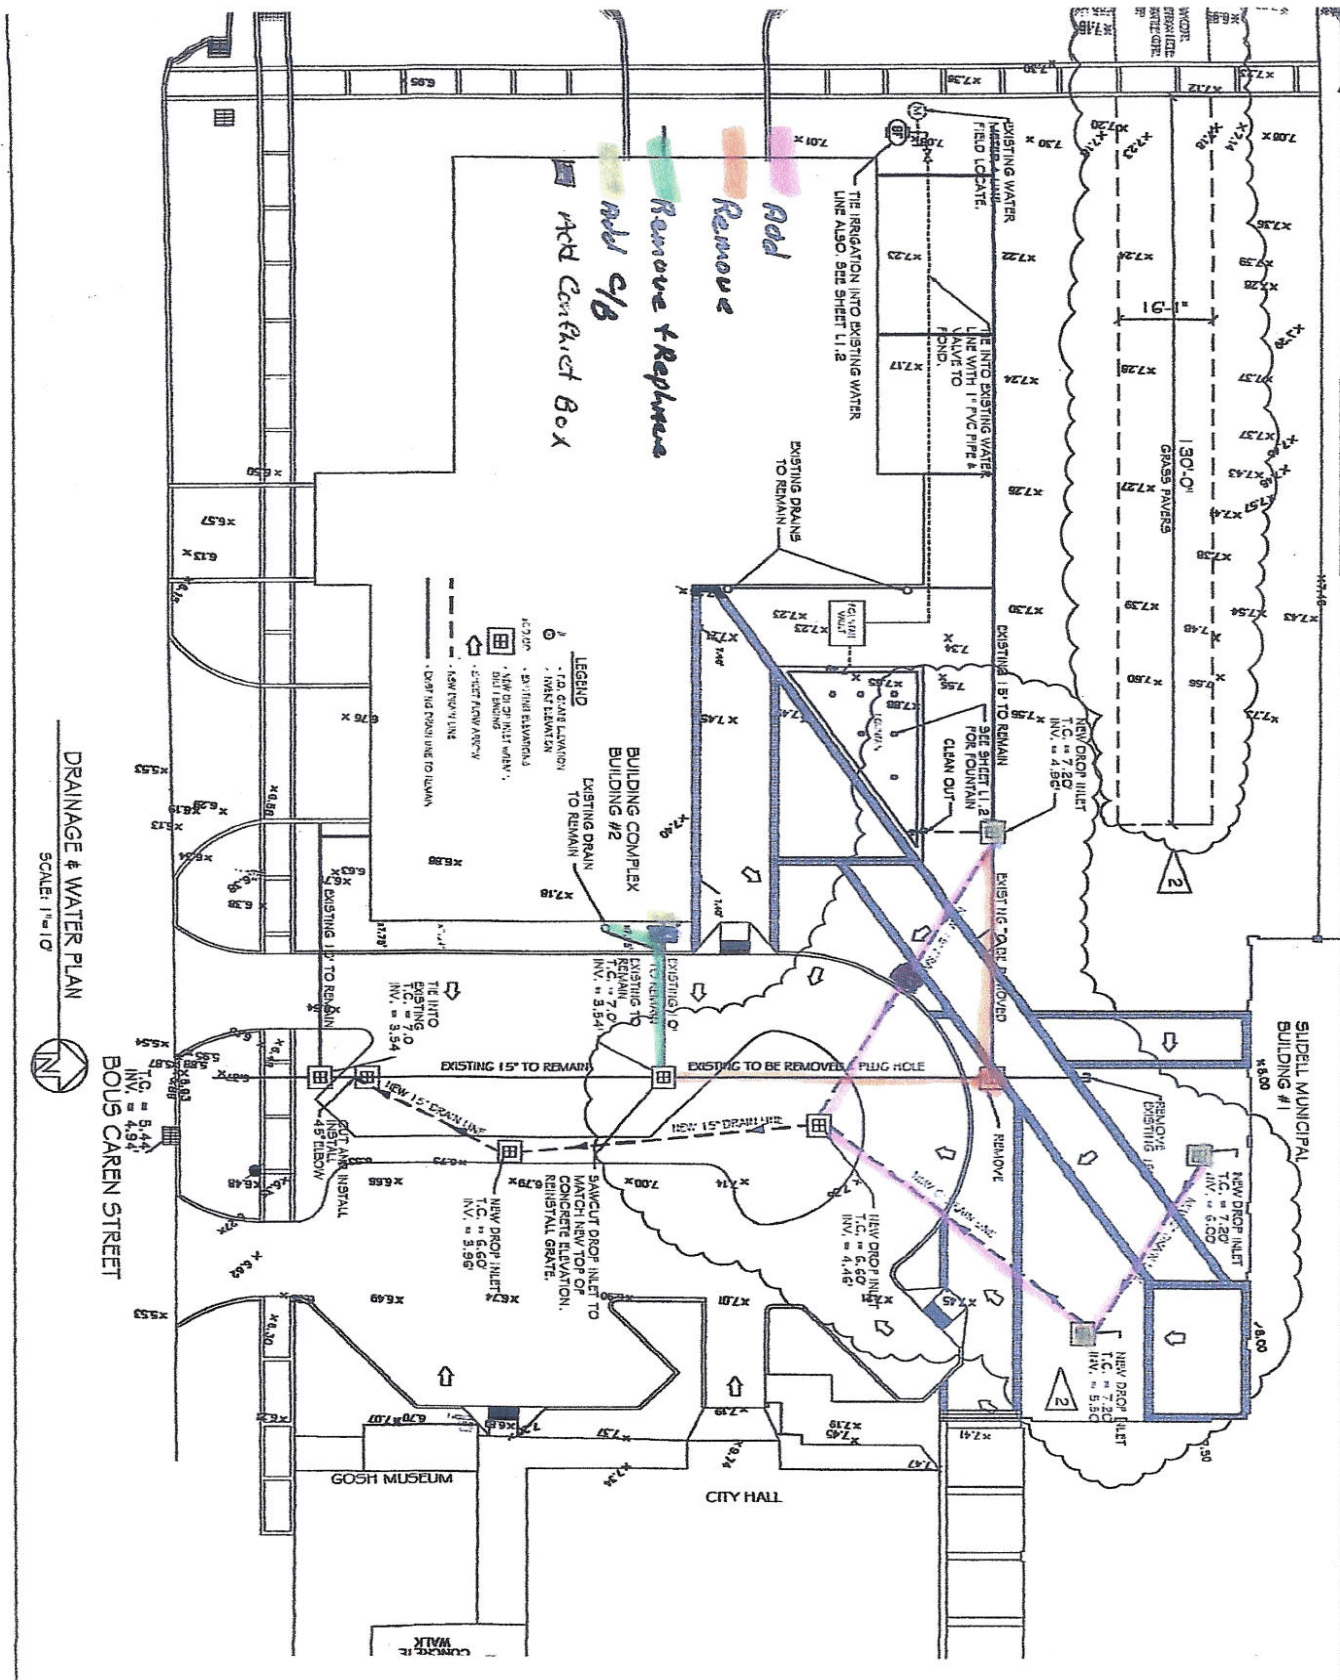

DRAINAGE & WATER PLAN
SCALE: 1"=10'



BOUS CAREN STREET

C2

DRAINAGE & WATER PLAN
SHEET NO. 3 OF 11

NO.	DESCRIPTION	DATE
1	CONCEPT	
2	DESIGN WATER MAINS & SANITARY MAINS	12-05-13
3	REVISED PAPER SIZE	

CITY HALL PARKING LOT & COURTYARD

DATE: 03-16-13

PROJECT NO: 2172

CHECKED BY: CJD







CHANGE WORK ORDER

City of Slidell Parking Lot & Courtyard
Slidell, LA

RE: Fountain addition

ATTN: Chuck Dammon

Contractor : Saucier Const. Co. Inc.
39159 Y Bar Y Rd.
Pearl River, LA 70452

1. The Owner authorizes and the Contractor agrees to make the following work changes to the Fountain.

Build the fountain pool for City Hall Parking Lot and Courtyard as modified at meeting. The pool will have 2 skimmers, 2 return lines, 5 bubbler fountains with 3 LED lights each. The pool interior will be plastered with white plaster. The interior waterline to be faced with pool tile and all top surfaces covered with coordinating brick coping. A fountain wall approximately 12' long and 2' high faced with tile and including 4 ea. 12" x 12" "Logo" tiles and a 24" waterfall as per drawing. Each pair of "Logo" tiles will have one LED light to illuminate the wall. Overflow and water level control to be in the remaining corner. Outside vertical surface to be Stucco, color to be chosen.


The fountain equipment to consist of an upgrade to one energy efficient pump, Cartridge filter, Auto Chlorinator and Dual Timer (one for lights, one for pump), 1 control valve for each bubbler and the waterfall (6ea.), all to be installed in the "water sprinkler" room in the adjacent building.

Electric service to the equipment area to be supplied by the City of Slidell.

Total cost for the upgrade is: \$5300.00

Dated: 1/24/2014

City of Slidell

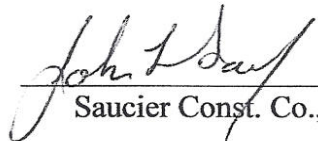 1-24-14


Saucier Const. Co., Inc.

New Orleans Pool & Patio
438 Robert Street; Slidell, LA 70458
985-646-0242 504-245-0402 poolstore@bellsouth.net
www.neworleanspoolandpatio.com

ARTISTIC CONCEPTION



City of Slidell, City Hall Fountain

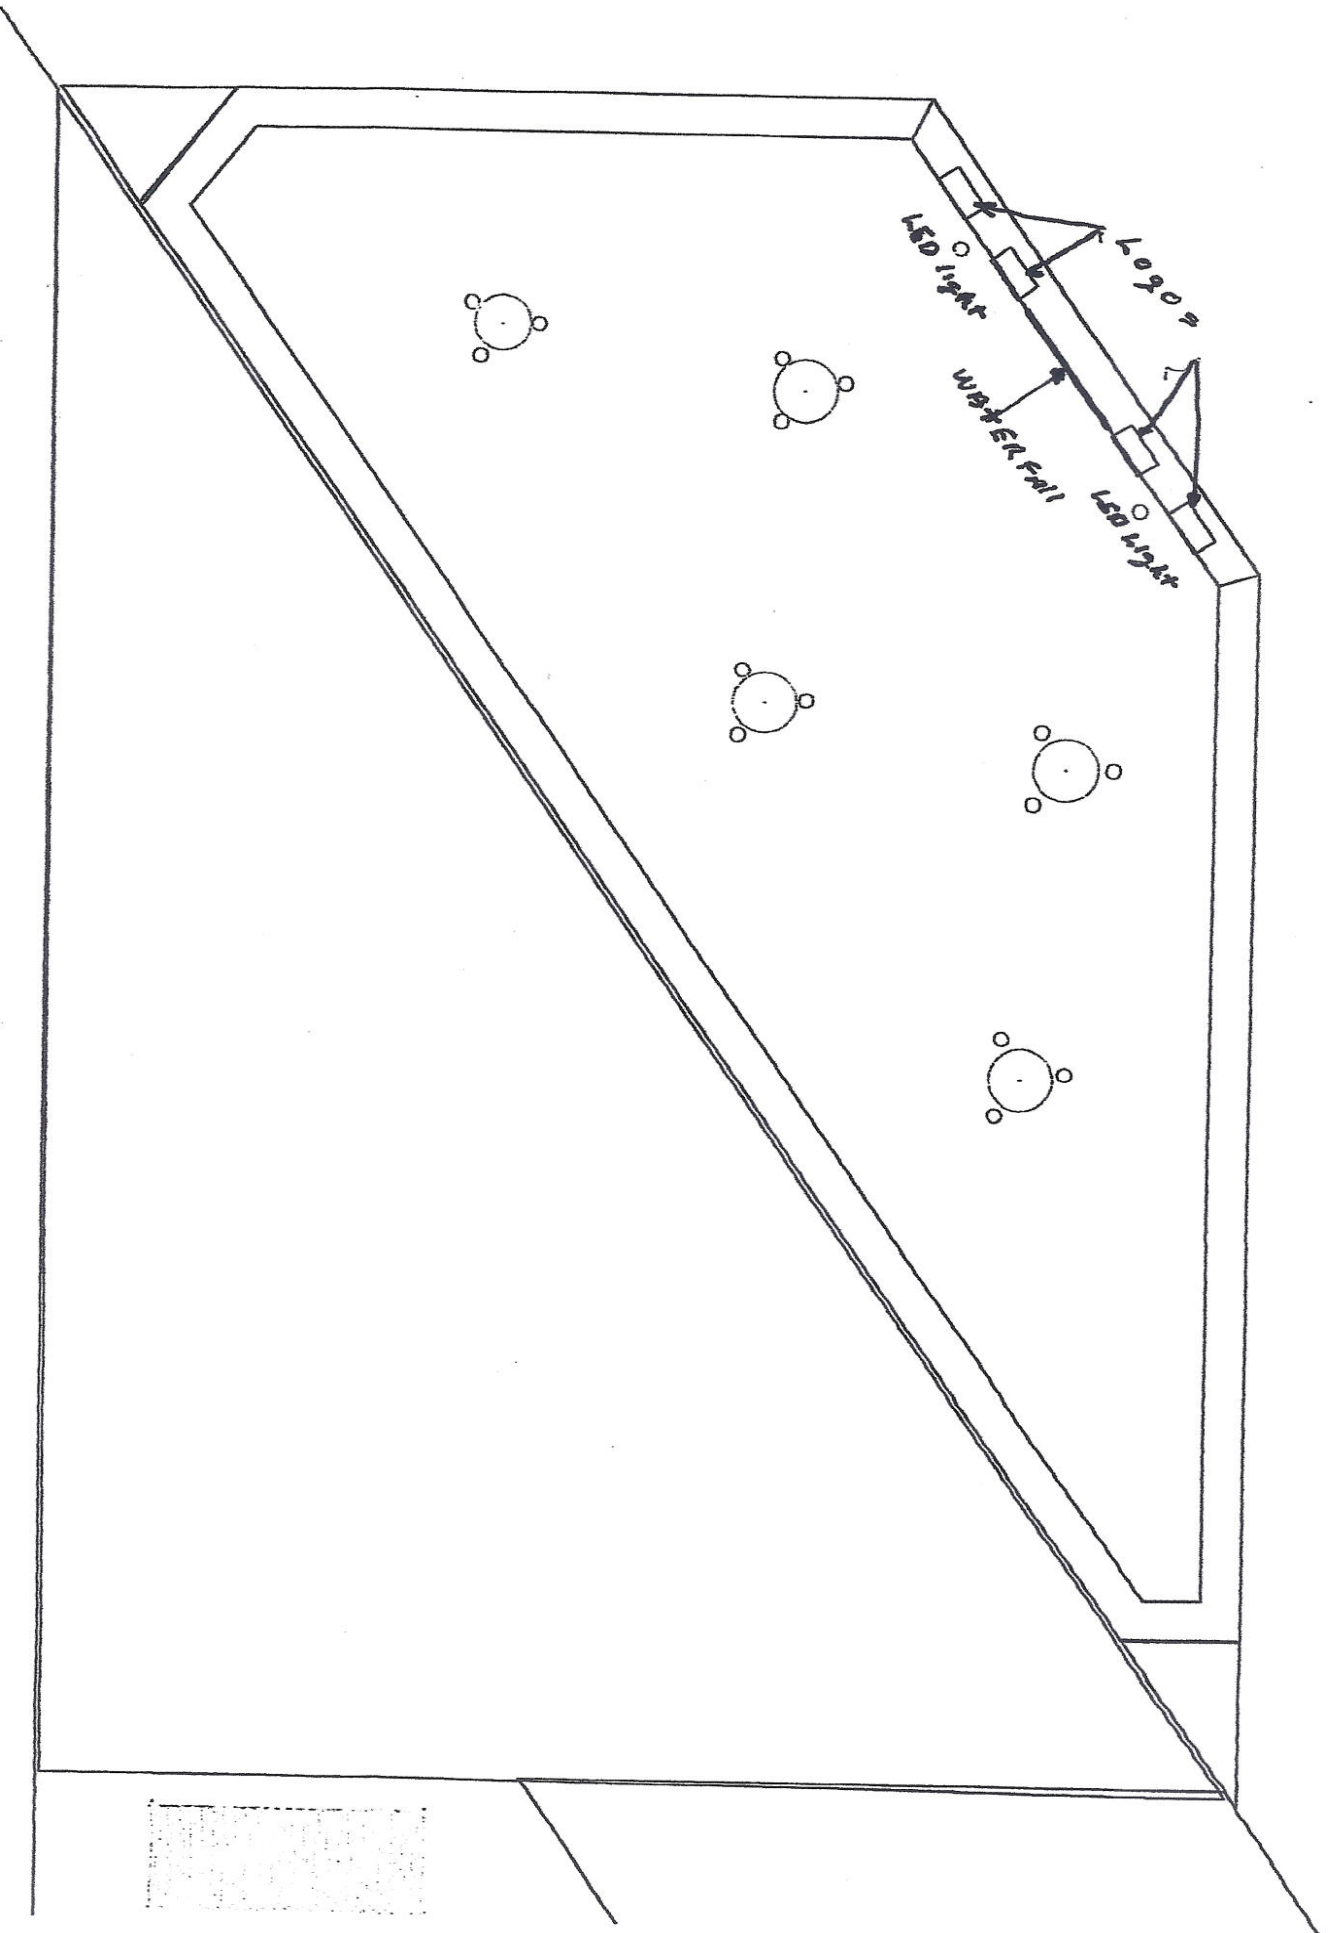

Change Order No. 1

Name of Project: City Hall Parking Lot and Courtyard

Architect/ Engineer: DAMMON ENGINEERING, INC.

Architect/ Engineer's Signature

RECOMMENDED BY: City of Slidell, Engineering Department

BY: _____

DATE: _____

APPROVED BY:

BY: _____
Freddy Drennan, Mayor

DATE: _____

STATEMENT OF CONTRACT AMOUNT:

	COST	TIME (DAYS)
ORIGINAL CONTRACT AMOUNT	\$ <u>243,963⁰⁰</u>	<u>90</u>
PREVIOUS ADDITION	\$ <u>- 0 -</u>	<u>- 0 -</u>
TOTAL	\$ <u>243,963⁰⁰</u>	<u>90</u>
PREVIOUS DEDUCTIONS	\$ <u>- 0 -</u>	<u>- 0 -</u>
NET PRIOR TO CHANGE	\$ <u>243,963⁰⁰</u>	<u>90</u>
AMOUNT OF CHANGE (ADD)	\$ <u>11,457⁵⁰</u>	<u>17</u>
CONTRACT AMOUNT TO DATE	\$ <u>255,420⁵⁰</u>	<u>107</u>