


INVERT #4610

L-1/2" X 2" X 3/8"
3/8" X 3-1/2"
NELSON STUD
2 EACH SIDE

TOP OF GRATE (T.O.G.)

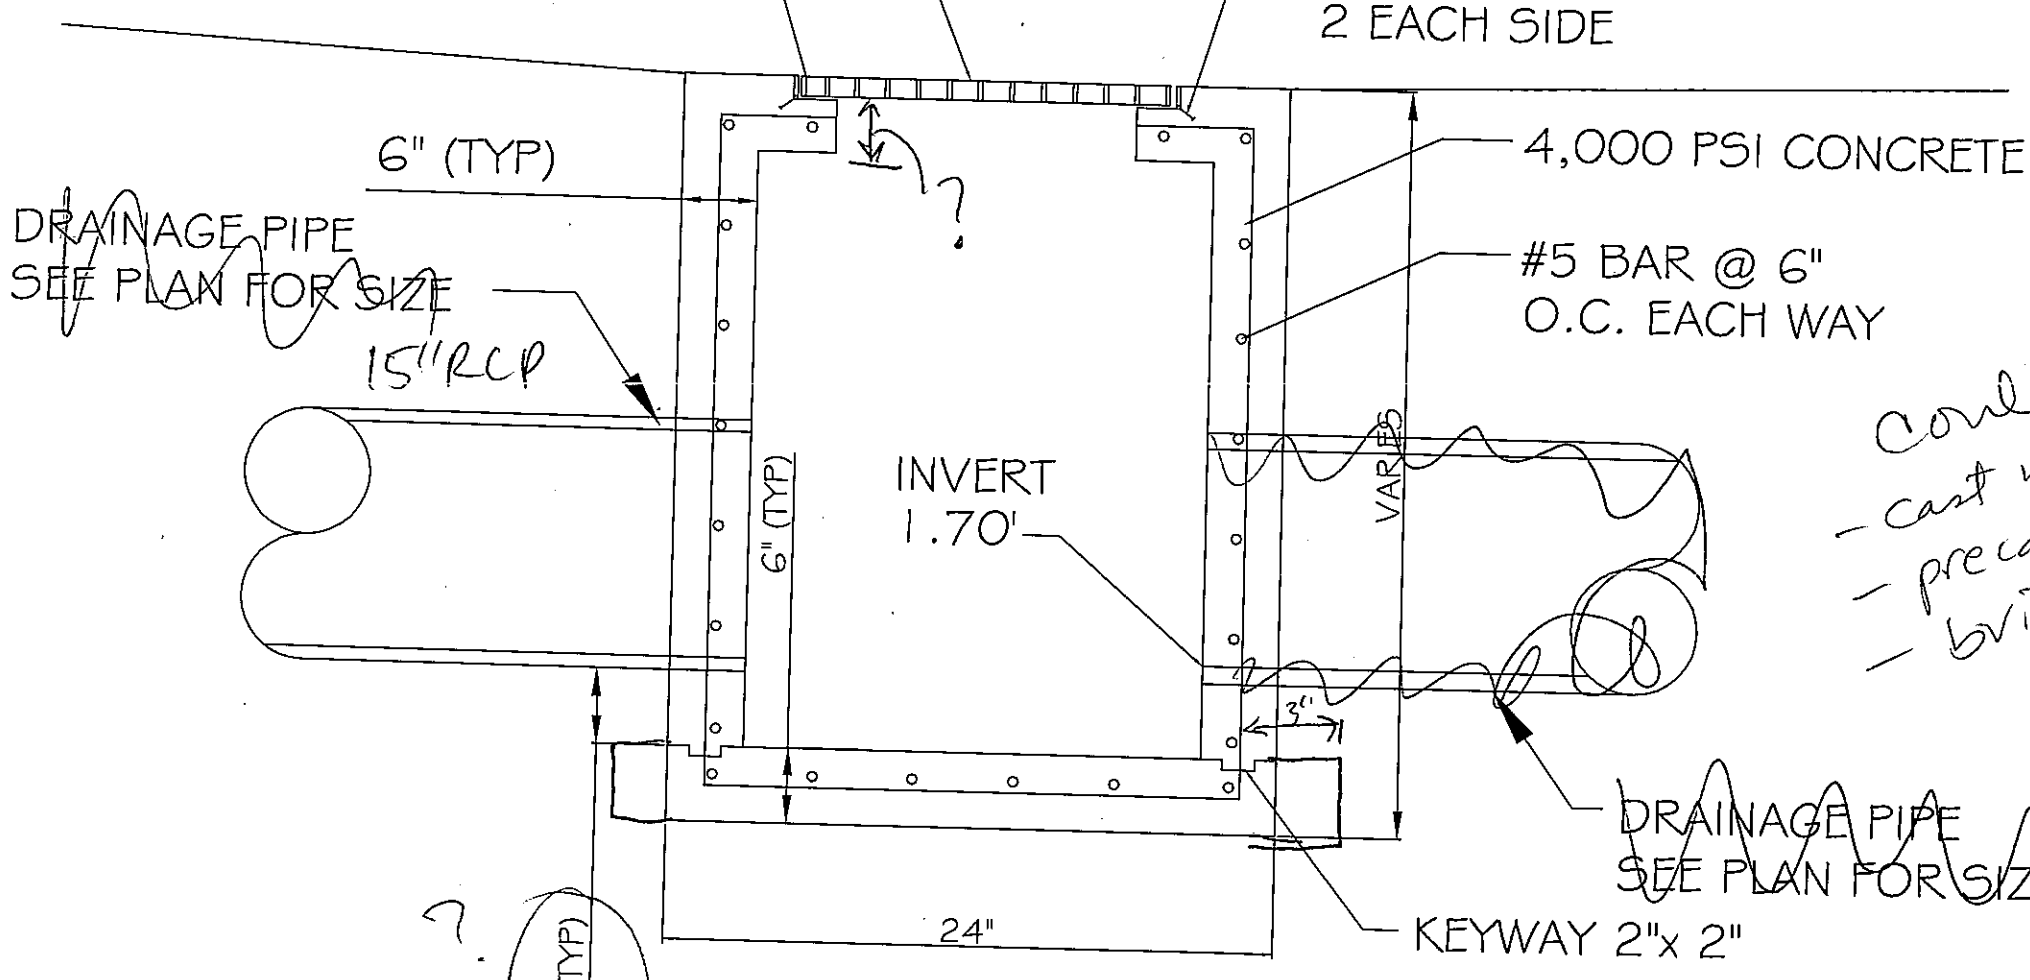

could be
- cast in place
- precast
- bricked

TYPICAL DROP INLET SECTION "A-A"

N.T.S.