
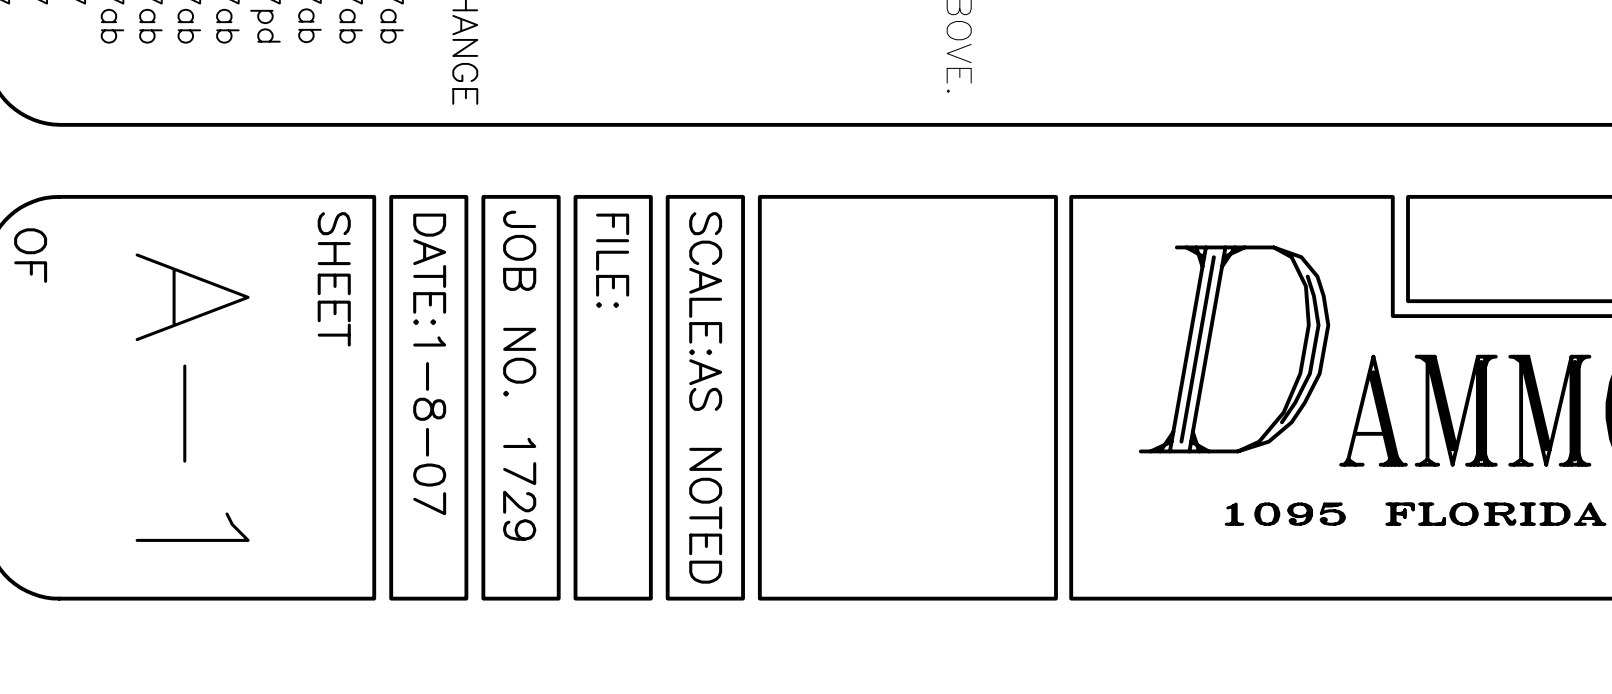
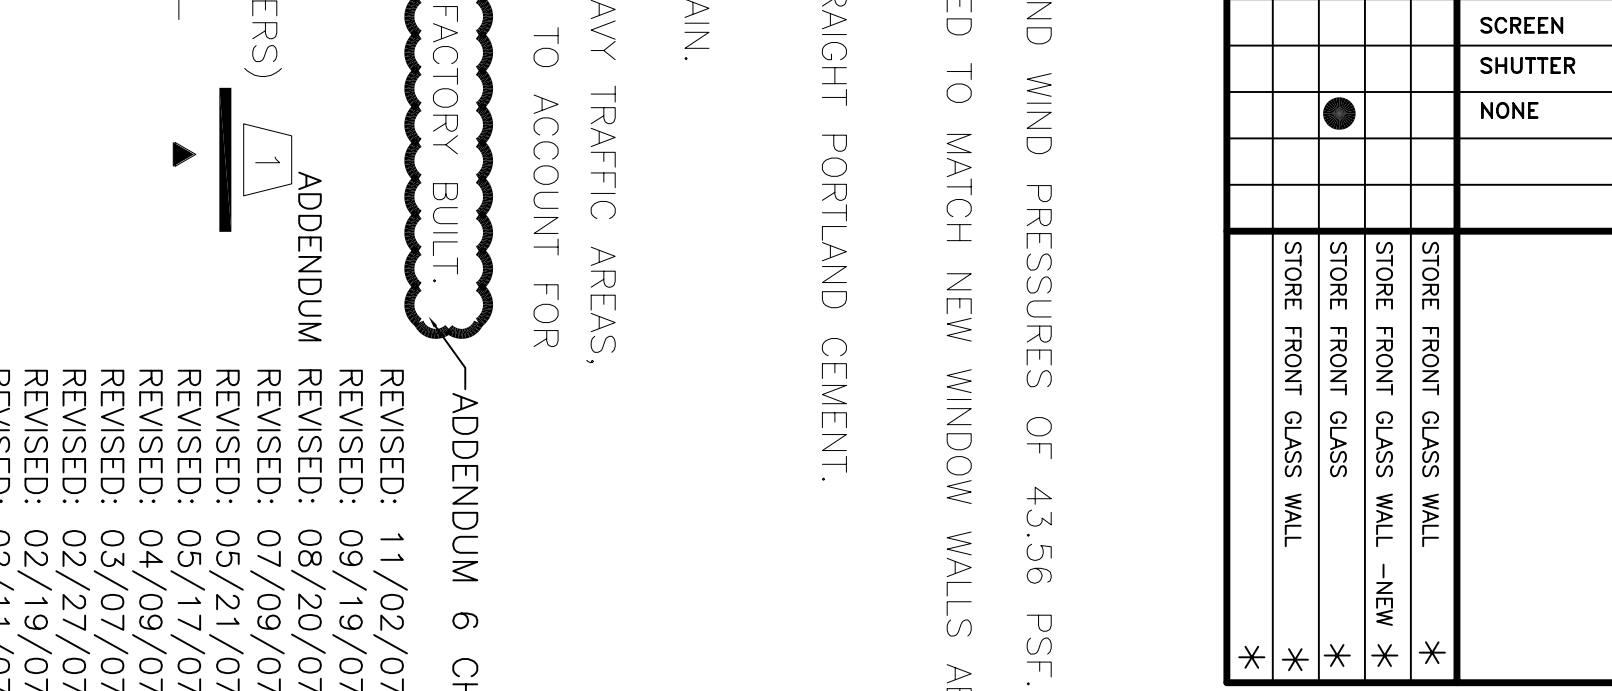
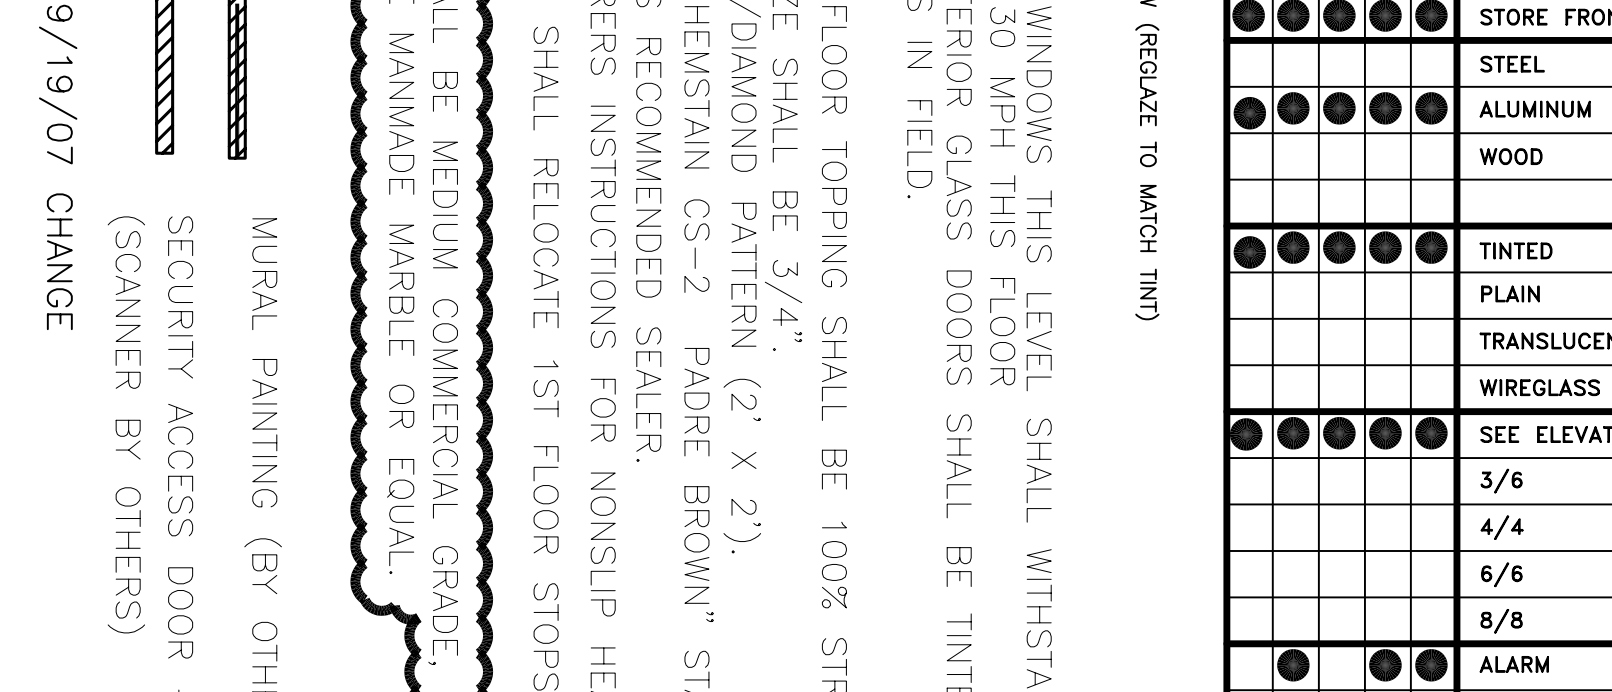
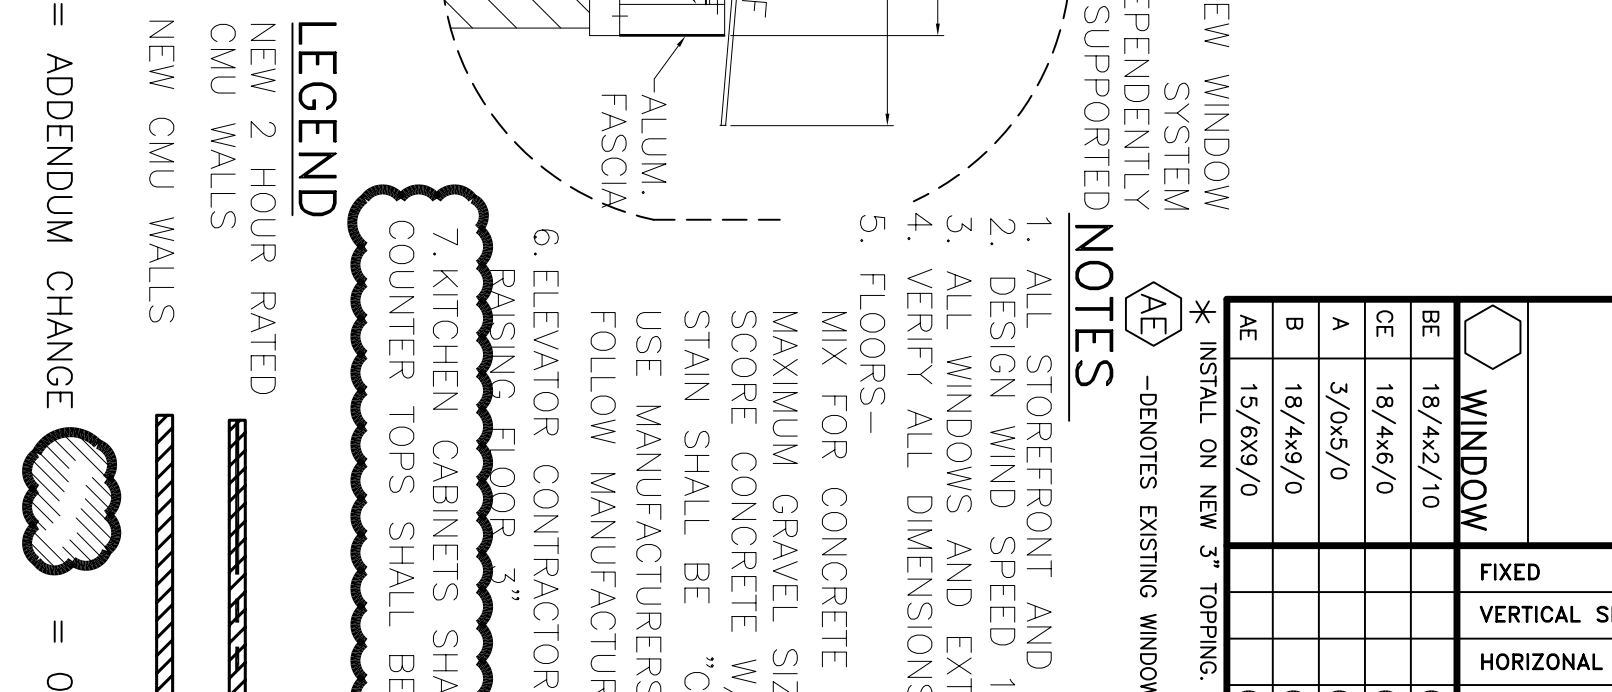
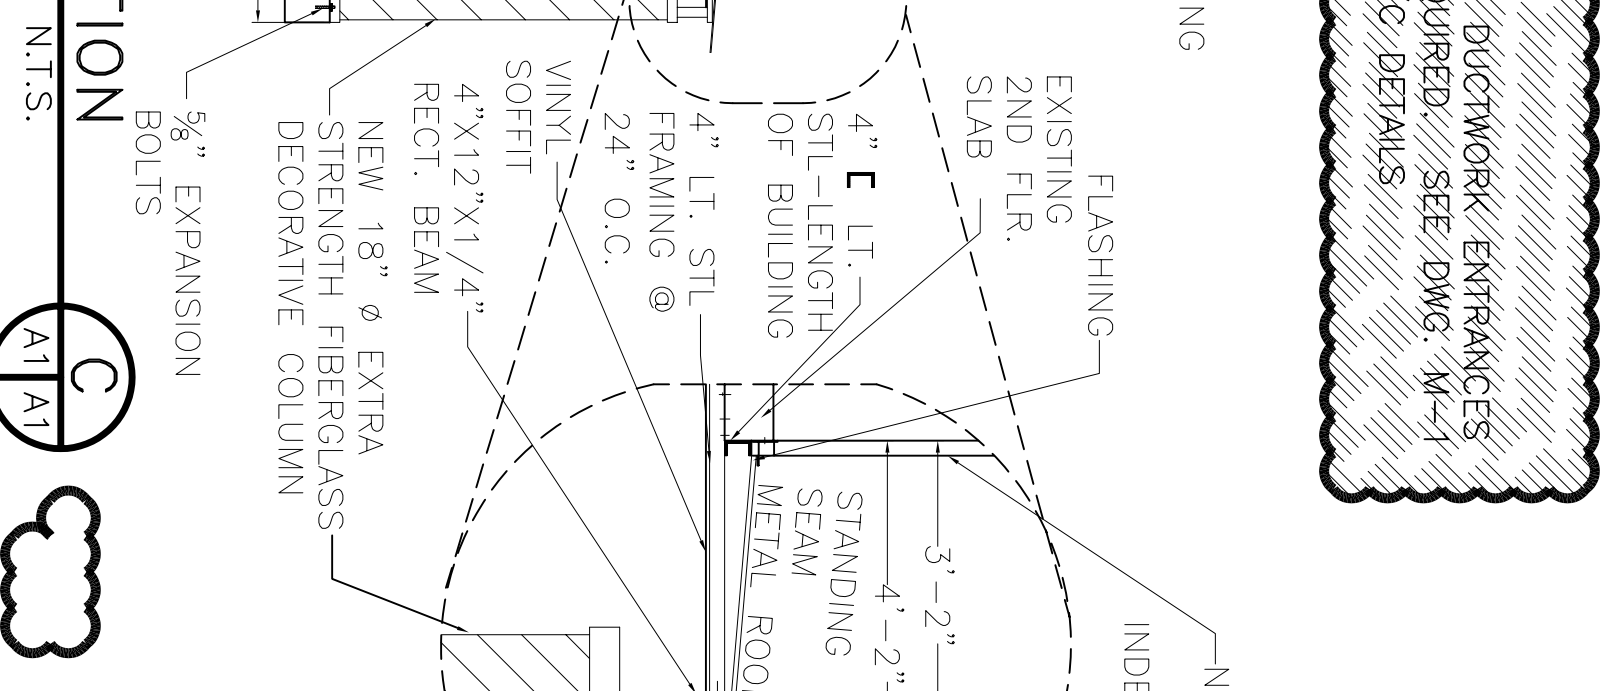
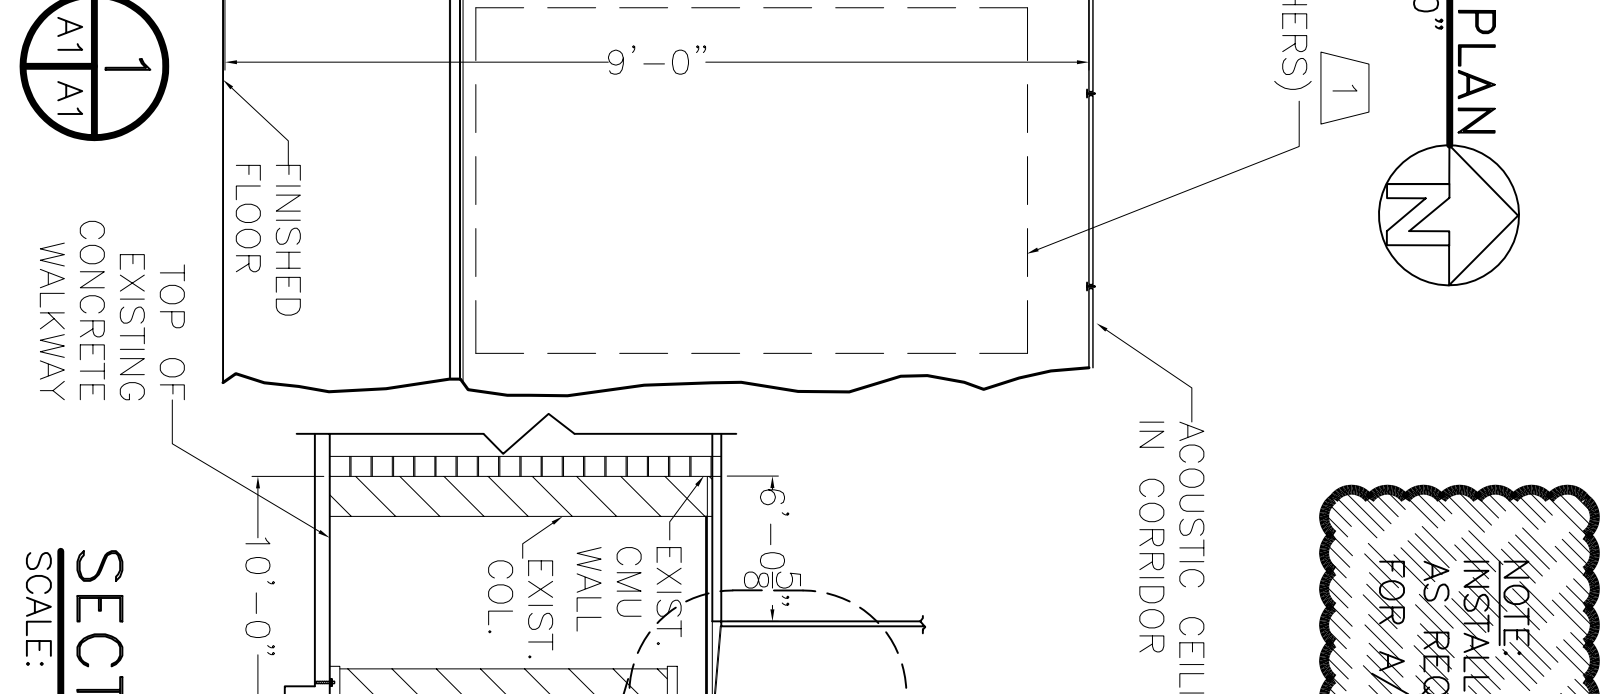
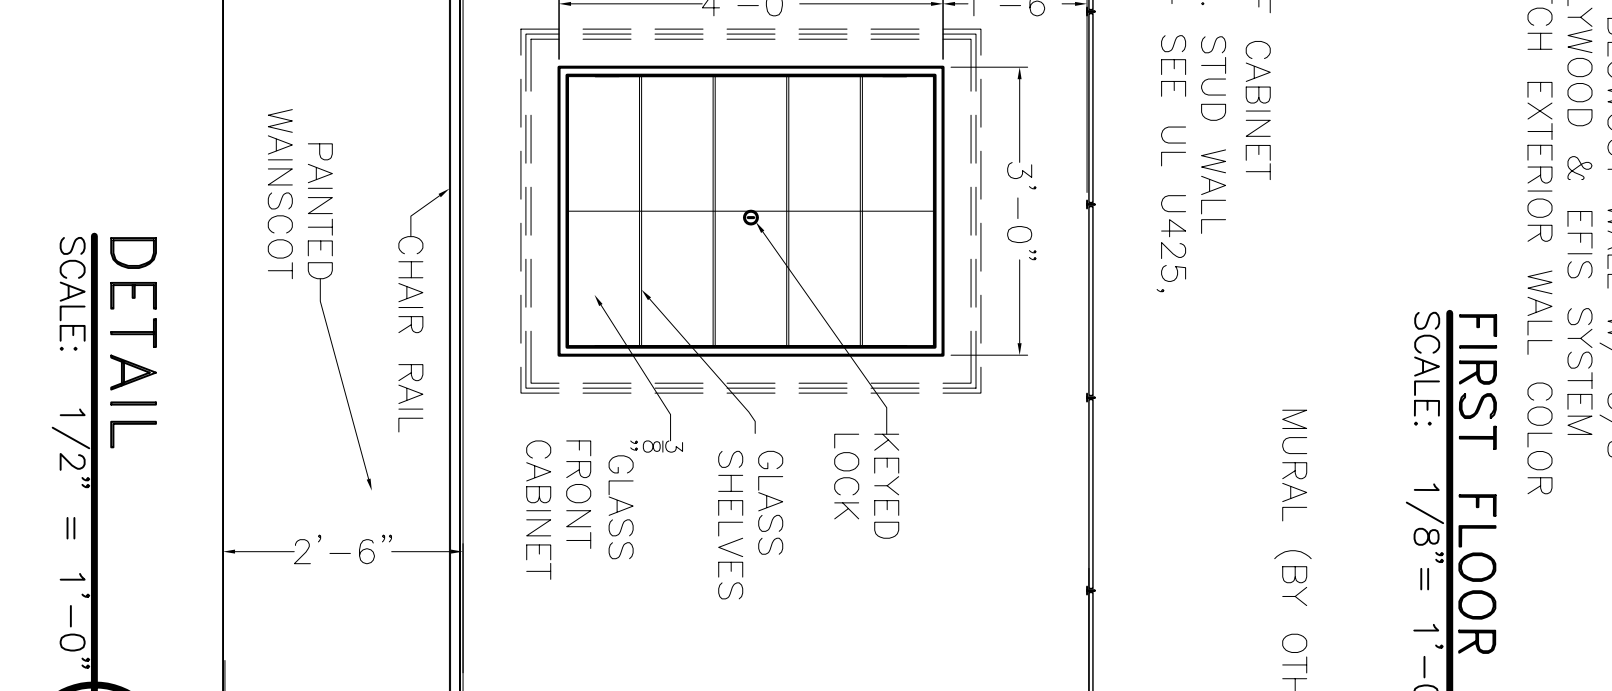
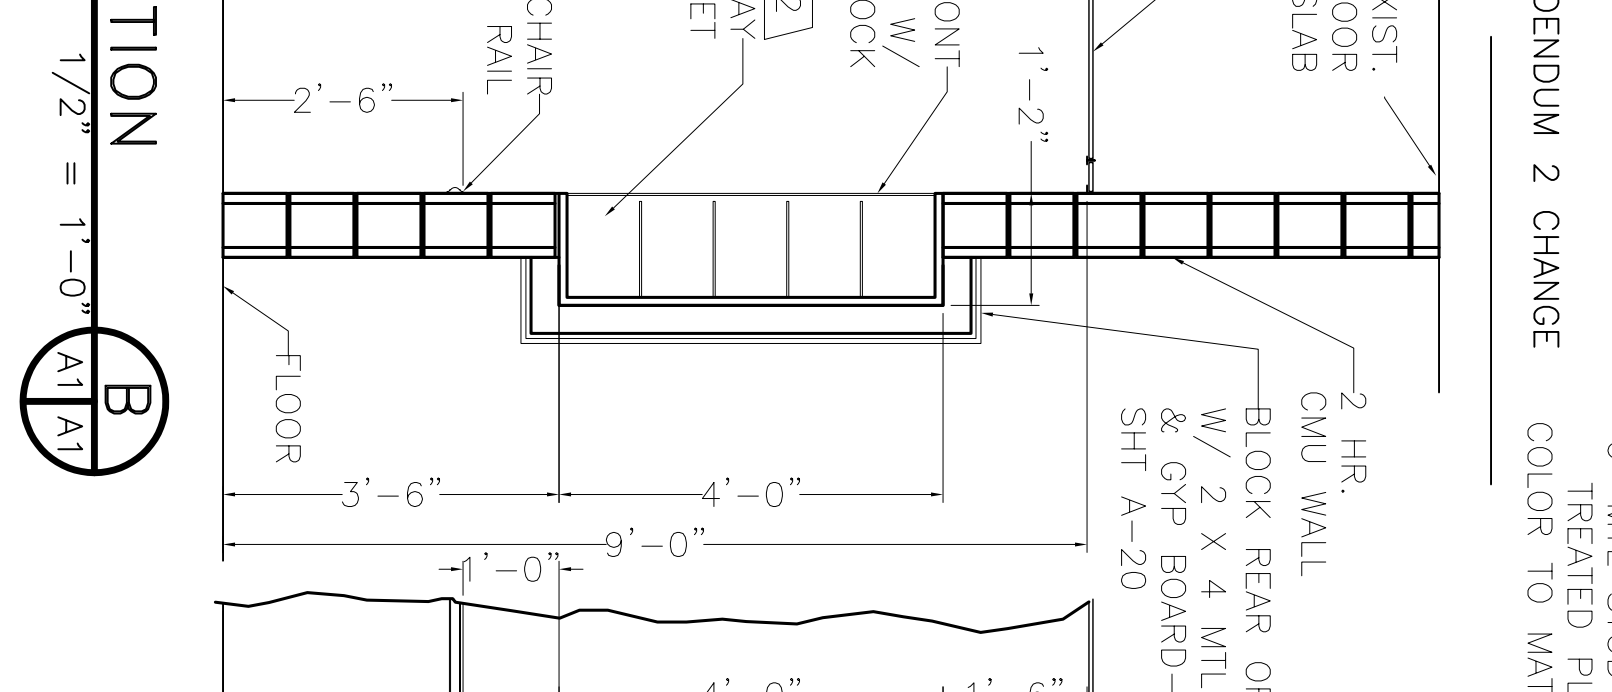
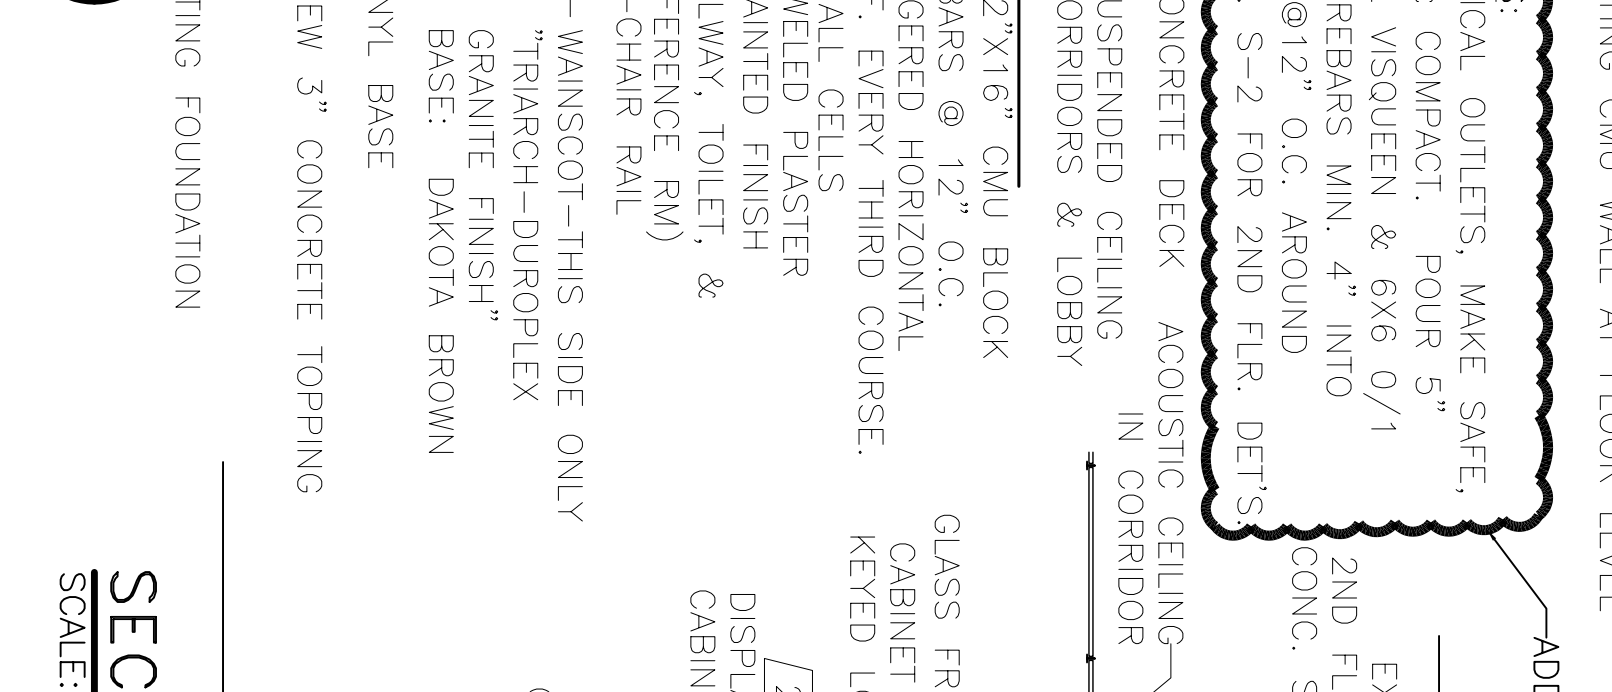
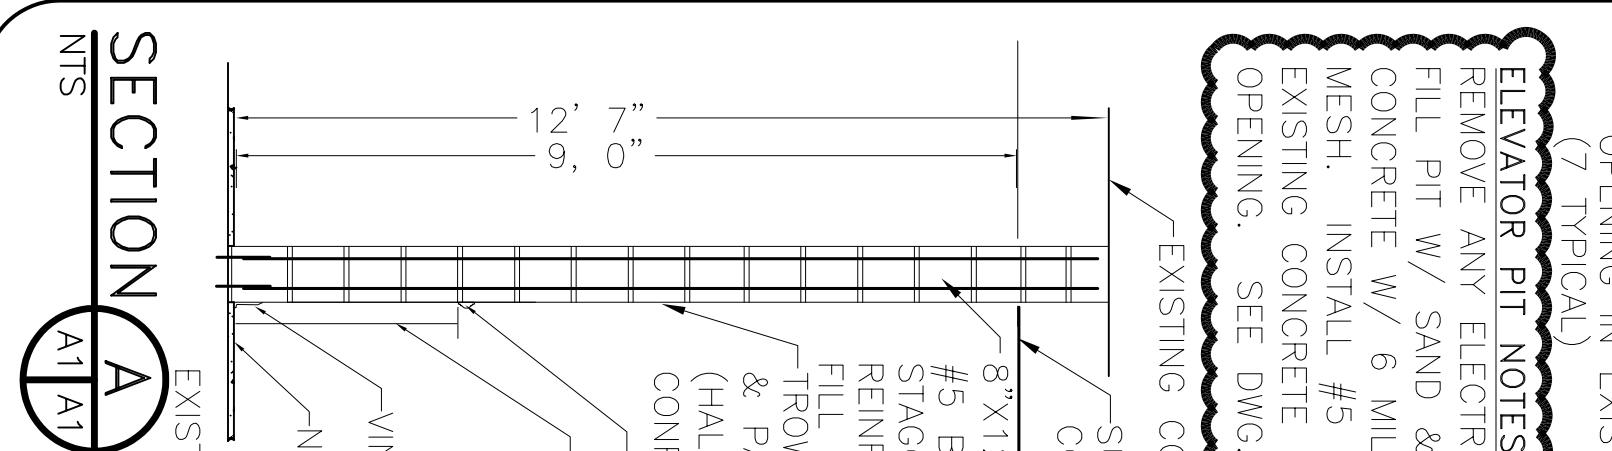
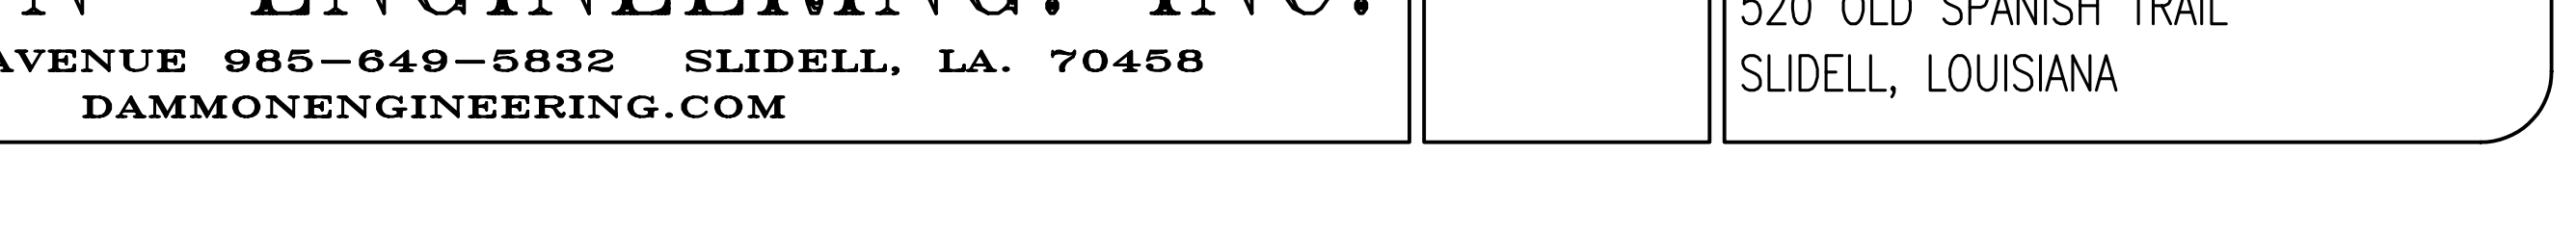
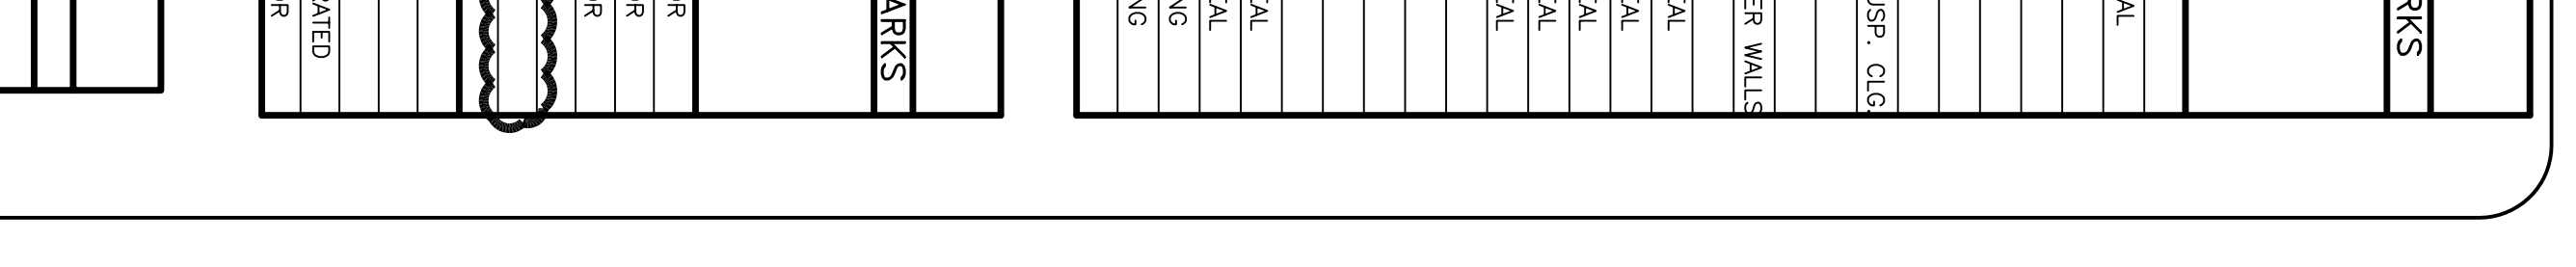
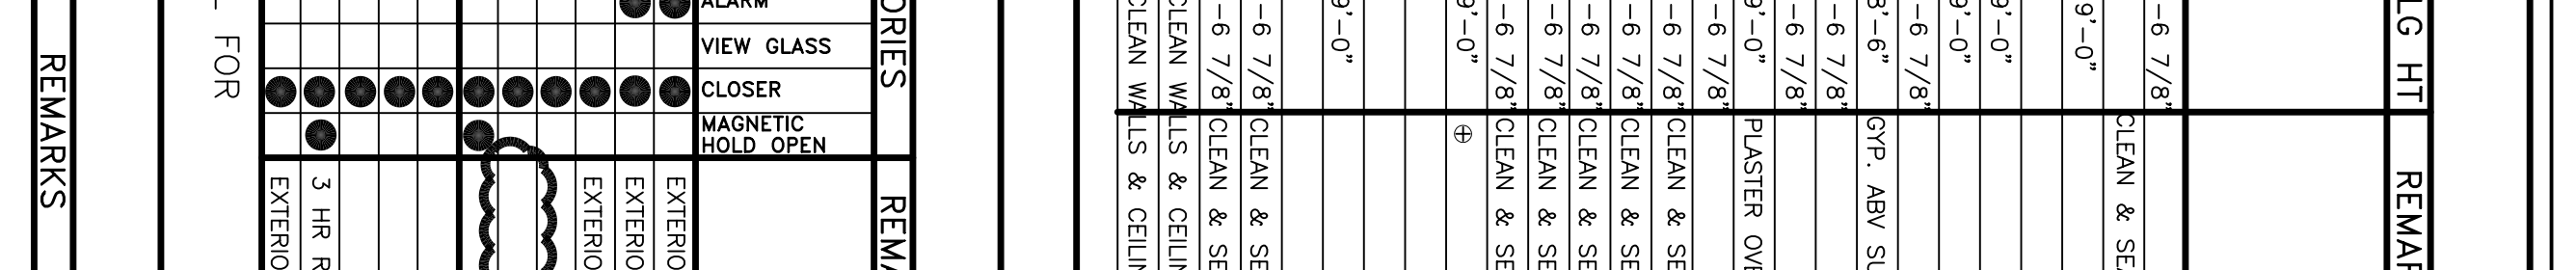
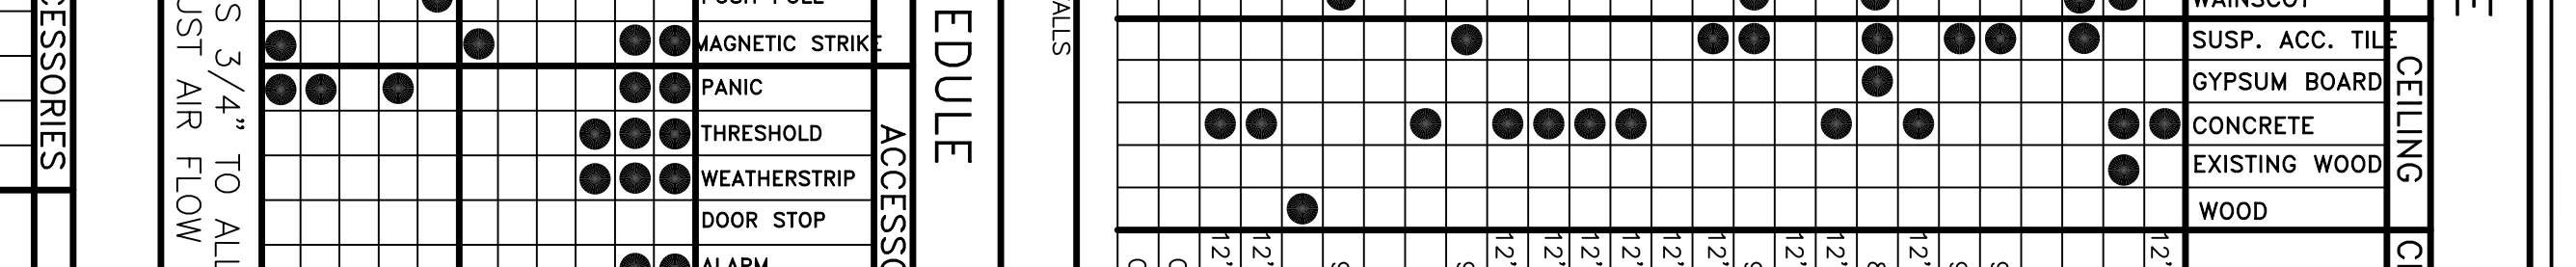
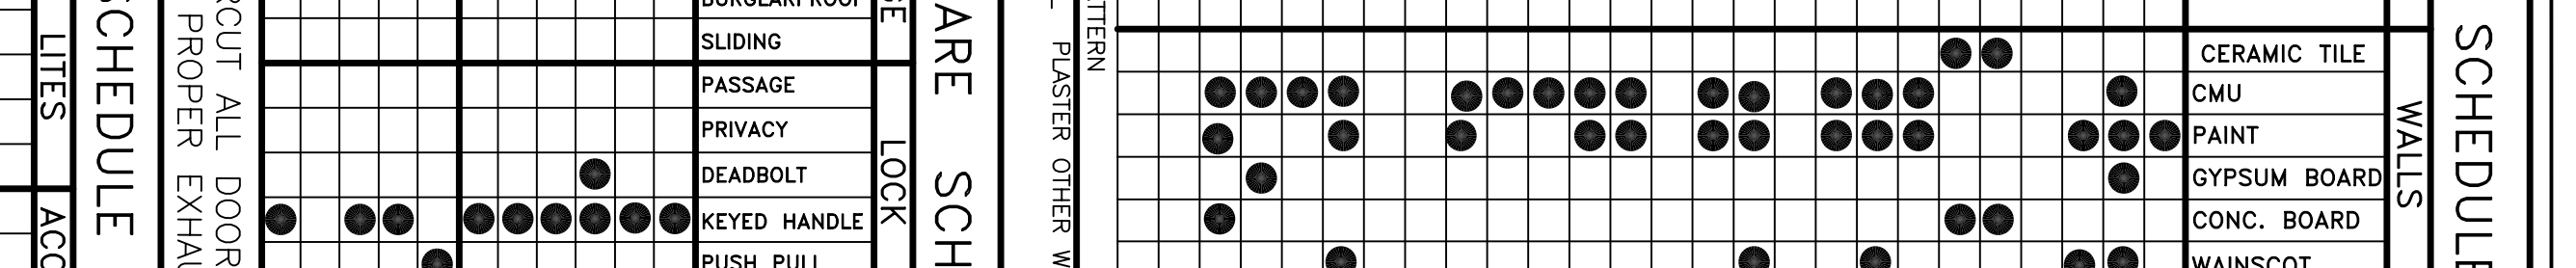
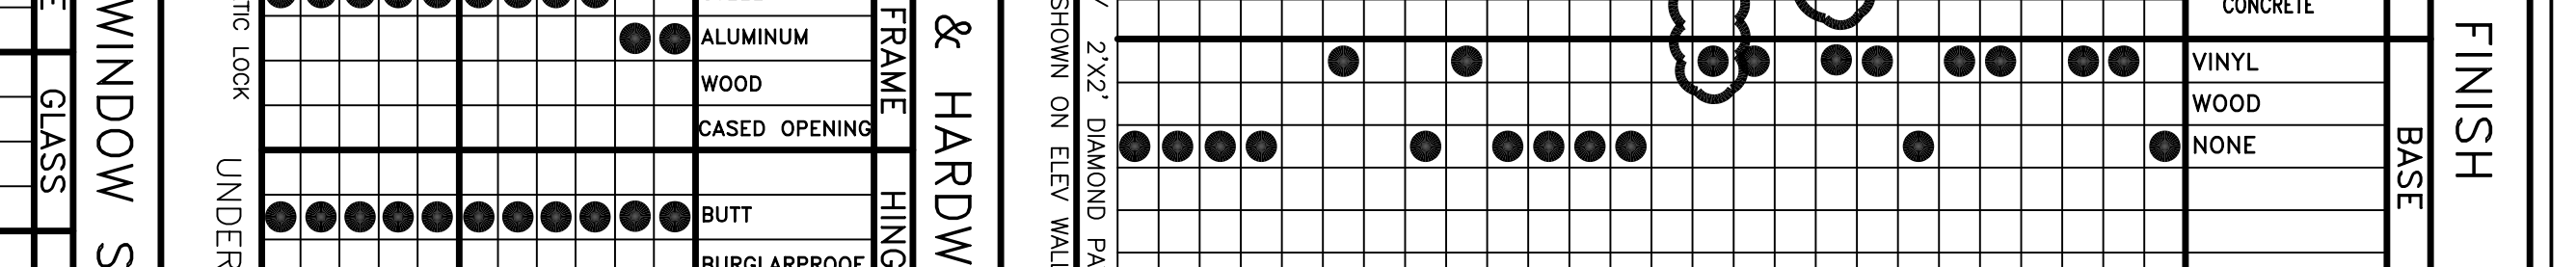
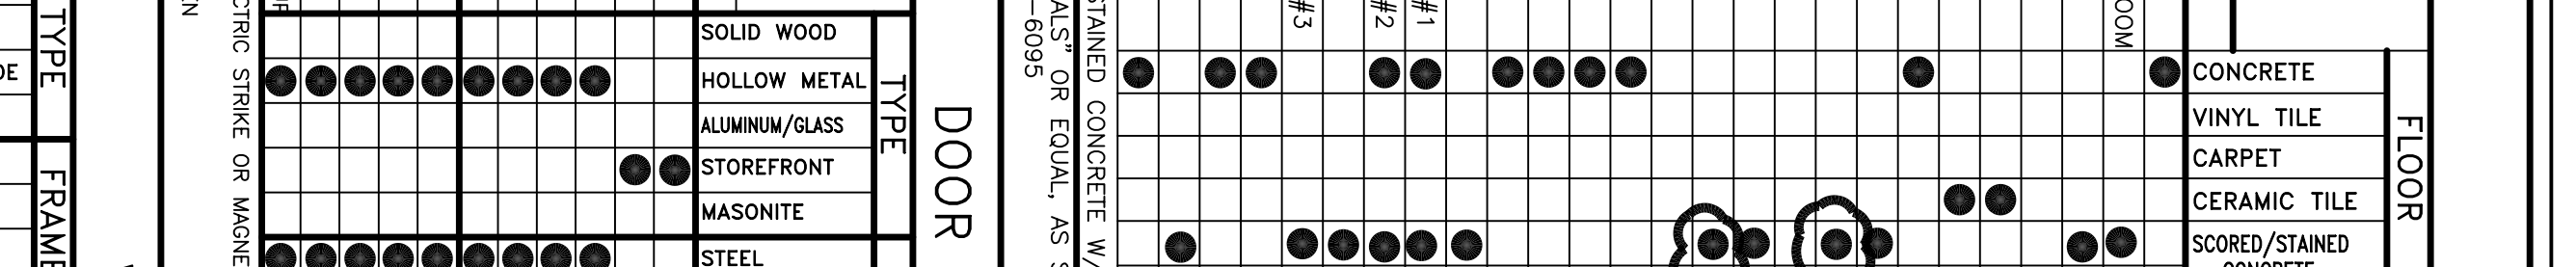
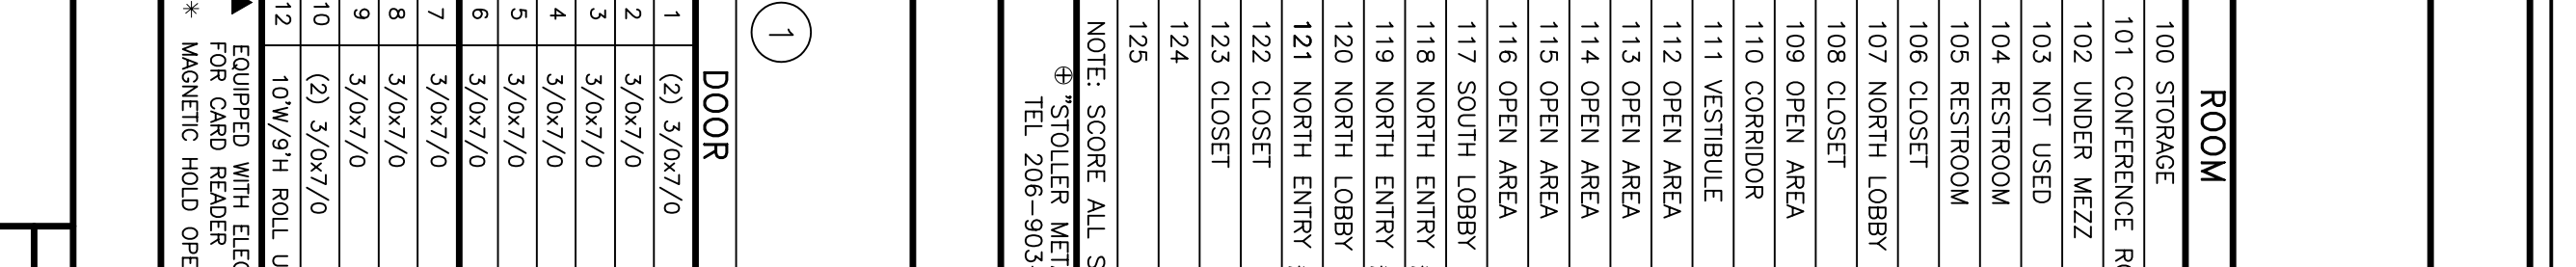


NOTE: ALL DIMENSIONS ARE ± AND SHALL BE FIELD VERIFIED.

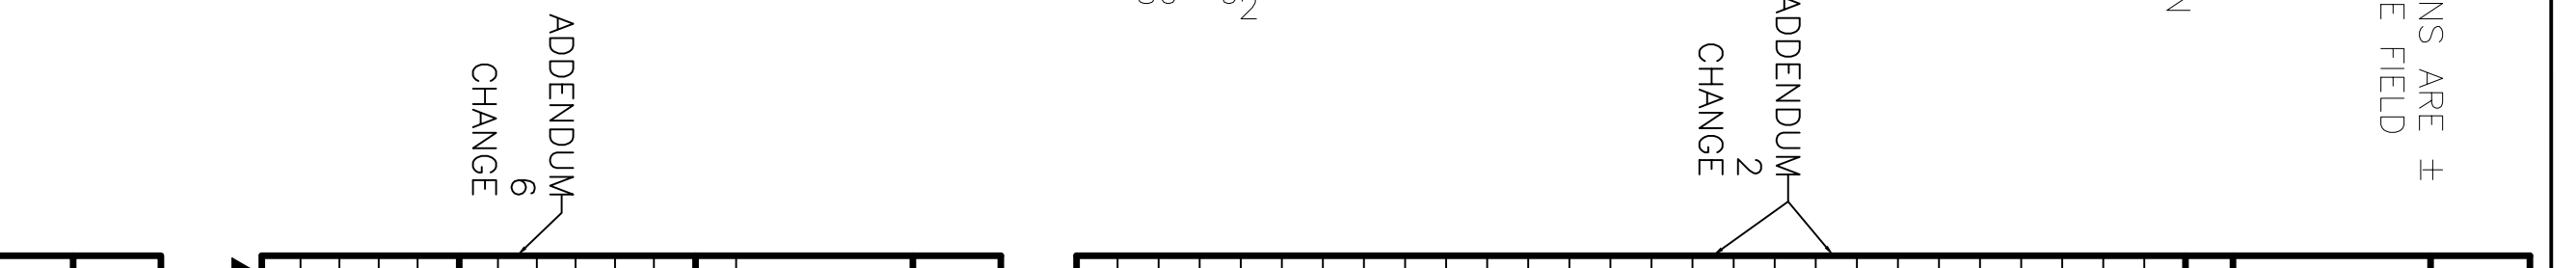

**LEGEND**

- NEW 2 HOUR RATED CMU WALLS
- NEW CMU WALLS
- MURAL PAINTING (BY OTHERS)
- SECURITY ACCESS DOOR - (SCANNER BY OTHERS)
- ADDENDUM CHANGE
- CHANGE

**WINDOW SCHEDULE**


**DOOR & HARDWARE SCHEDULE**

ID	TYPE	FRAME	HINGE	LOCK	ACCESSORIES	REMARKS

**FINISH SCHEDULE**

ROOM	FLOOR	BASE	WALLS	CEILING	CLG HT	REMARKS

**NOTES**

- ALL STOREFRONT AND WINDOWS THIS LEVEL SHALL WITHSTAND WIND PRESSURES OF 43.56 PSF.
- DESIGN WIND SPEED 130 MPH THIS FLOOR
- ALL WINDOWS AND EXTERIOR GLASS DOORS SHALL BE TINTED TO MATCH NEW WINDOW WALLS ABOVE.
- VERIFY ALL DIMENSIONS IN FIELD.
- FLOORS - MIX FOR CONCRETE FLOOR TOPPING SHALL BE 100% STRAIGHT PORTLAND CEMENT. MAXIMUM GRAVEL SIZE SHALL BE 3/4". SCORE CONCRETE W/DIAMOND PATTERN (2' X 2'). STAIN SHALL BE 'CHEMSTAIN CS-2 PARE BROWN' STAIN. FOLLOW MANUFACTURERS RECOMMENDED SEALER.
- ELEVATOR CONTRACTOR SHALL RELOCATE 1ST FLOOR STOPS TO ACCOUNT FOR RAISING FLOOR.
- KITCHEN CABINETS SHALL BE MEDIUM COMMERCIAL GRADE FACTORY BUILT. COUNTER TOPS SHALL BE MANMADE MARBLE OR EQUAL.

**REVISIONS**

NO.	DATE	DESCRIPTION
1	02/11/07	REVISION: 02/11/07
2	02/27/07	REVISION: 02/27/07
3	03/07/07	REVISION: 03/07/07
4	04/09/07	REVISION: 04/09/07
5	05/21/07	REVISION: 05/21/07
6	07/09/07	REVISION: 07/09/07
7	08/20/07	REVISION: 08/20/07
8	09/19/07	REVISION: 09/19/07
9	11/02/07	REVISION: 11/02/07

**CONTRACT SET - 10/10/07**

RENOVATE OFFICE BUILDING

# DAMMON ENGINEERING, INC.

1095 FLORIDA AVENUE 985-649-5832 SLIDELL, LA. 70458  
DAMMONENGINEERING.COM

**1ST FLOOR RENOVATE PLAN**

ST. TAMMANY PARISH ADMIN. COMPLEX  
520 OLD SPANISH TRAIL  
SLIDELL, LOUISIANA

**SHEET**

A-1

DATE: 1-8-07

JOB NO. 1729

SCALE: AS NOTED