

FIFTH FLOOR PLAN
 SCALE: 1/8" = 1'-0"

FINISH SCHEDULE

ROOM	FLOOR	BASE	WALLS	Ceilings	CLG HT	REMARKS
500	CONCRETE	VINYL TILE	CONCRETE	GYPSUM BOARD	8'-6"	CARPET & PAD
510	CARPET	CARPET	PAINTED WOOD		9'-0"	
511	CARPET	CARPET	PAINTED WOOD		9'-0"	
512	CARPET	CARPET	PAINTED WOOD		9'-0"	
513	CARPET	CARPET	PAINTED WOOD		9'-0"	
514	CARPET	CARPET	PAINTED WOOD		9'-0"	

NOTE: KITCHEN CABINETS SHALL BE MEDIUM COMMERCIAL GRADE, FACTORY BUILT. COUNTER TOPS SHALL BE MANMADE MARBLE OR EQUAL.

*PEEL & STICK CUSHION BACK CARPET
 CARPET SHALL HAVE CUSHION BACK
 ROOMS 500,501,507,508
 UNDERCUT ALL DOORS 3/4" TO ALL FOR
 PROPER EXHAUST AIR FLOW

NOTE: INSTALL DOORWORK, ENTRANCES AS REQUIRED. SEE DWG M-5 FOR A/E DETAILS

DOOR & HARDWARE SCHEDULE

NO.	TYPE	FRAME	HINGE	LOOK	ACCESSORIES	REMARKS










DOORS SHOWN WITH ▲ SHALL BE EQUIPPED WITH ELECTRIC STRIKE FOR CARD READER

WINDOW SCHEDULE

NO.	TYPE	FRAME	GLASS	LITES	ACCESSORIES	REMARKS

* FINAL SIZES TO BE DETERMINED BY VENDOR FROM FIELD MEASUREMENTS [TYP. ALL FLOORS]

▲ = ADDENDUM 4 CHANGE
 ☁ = 09/19/07 CHANGE

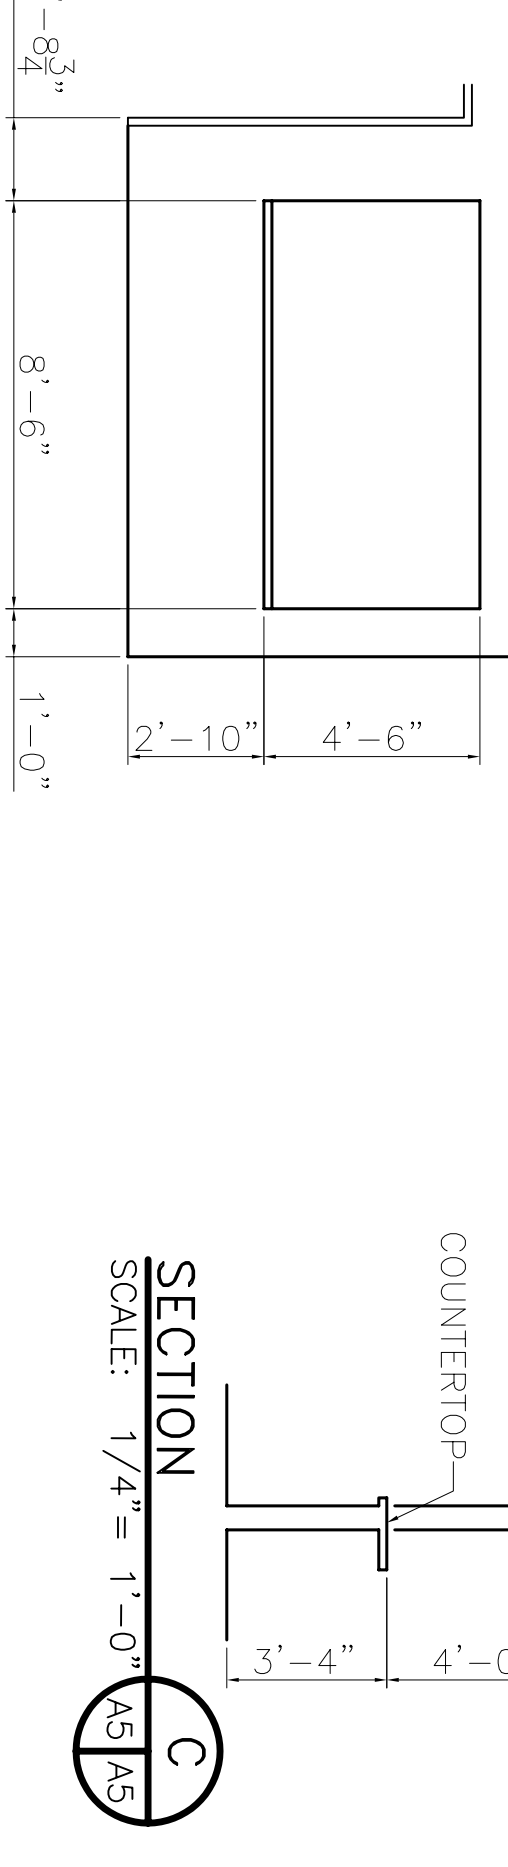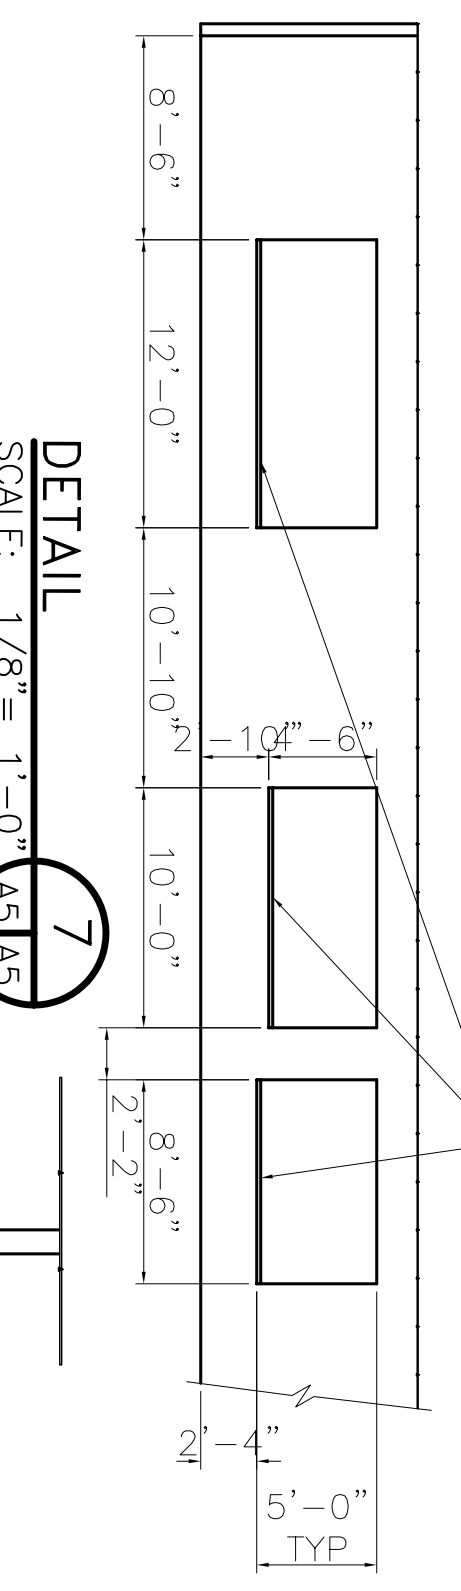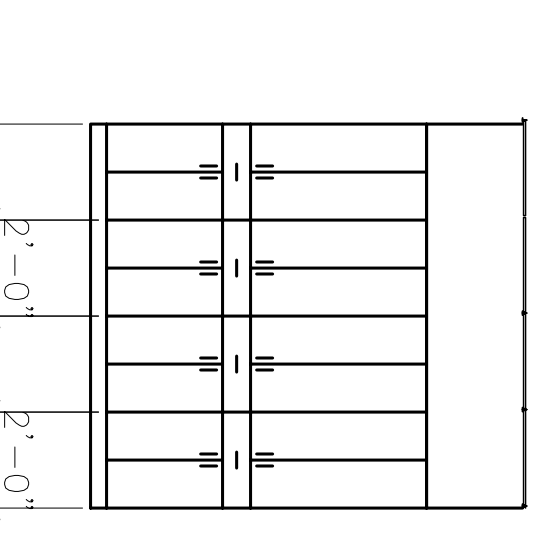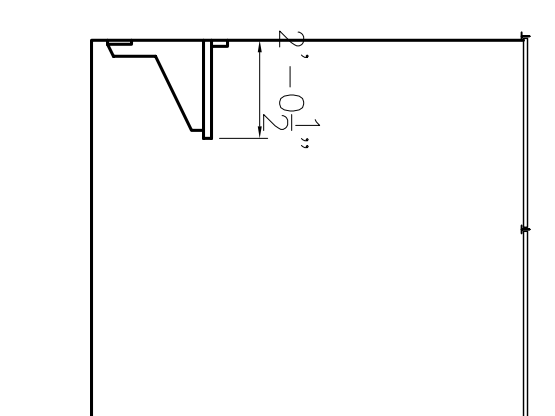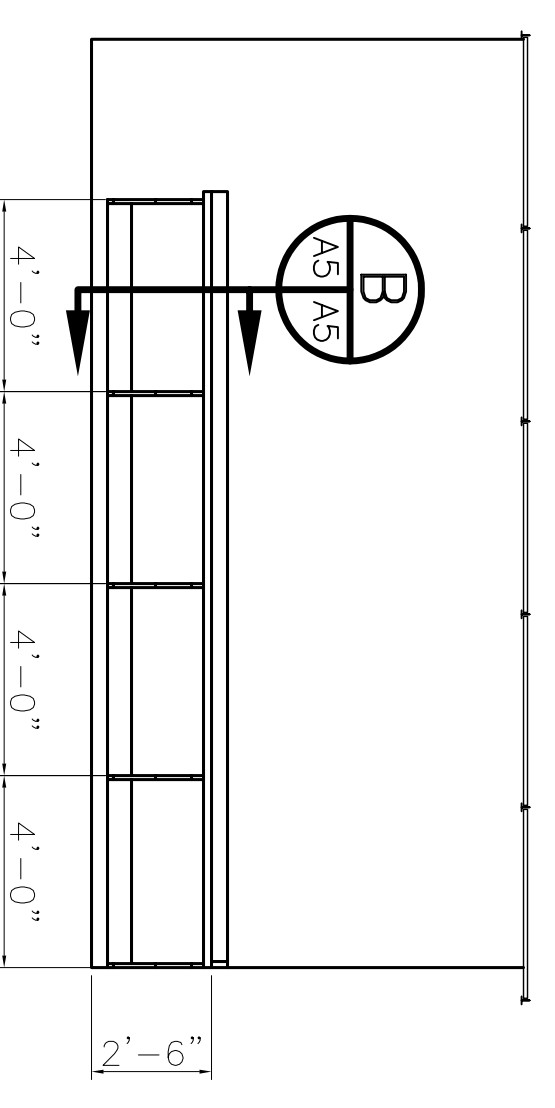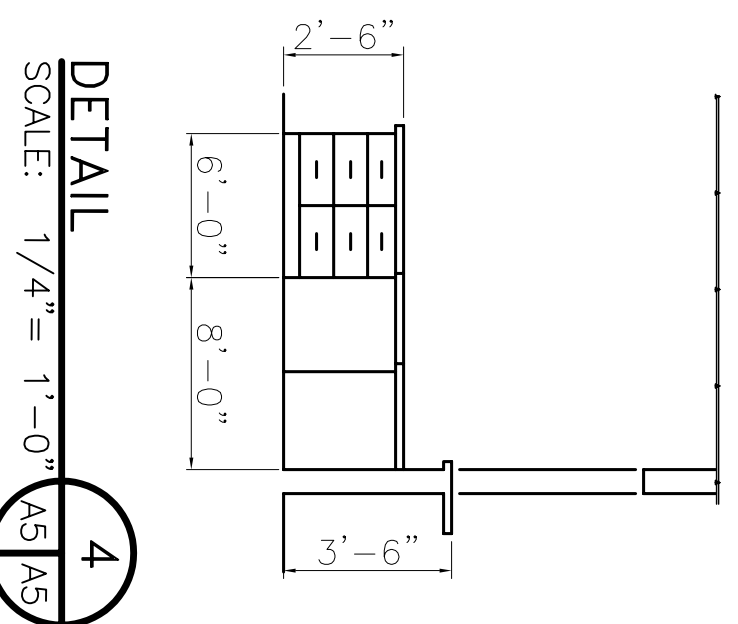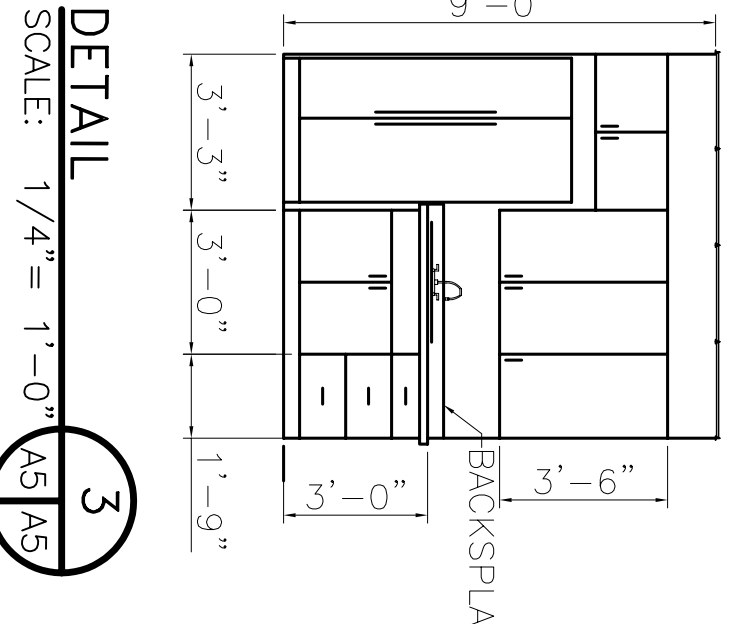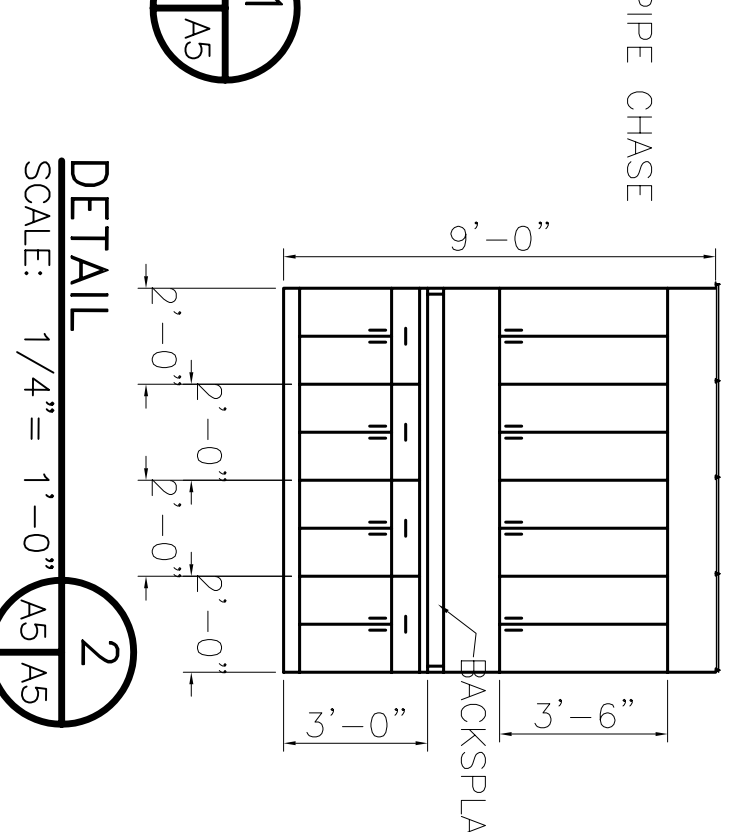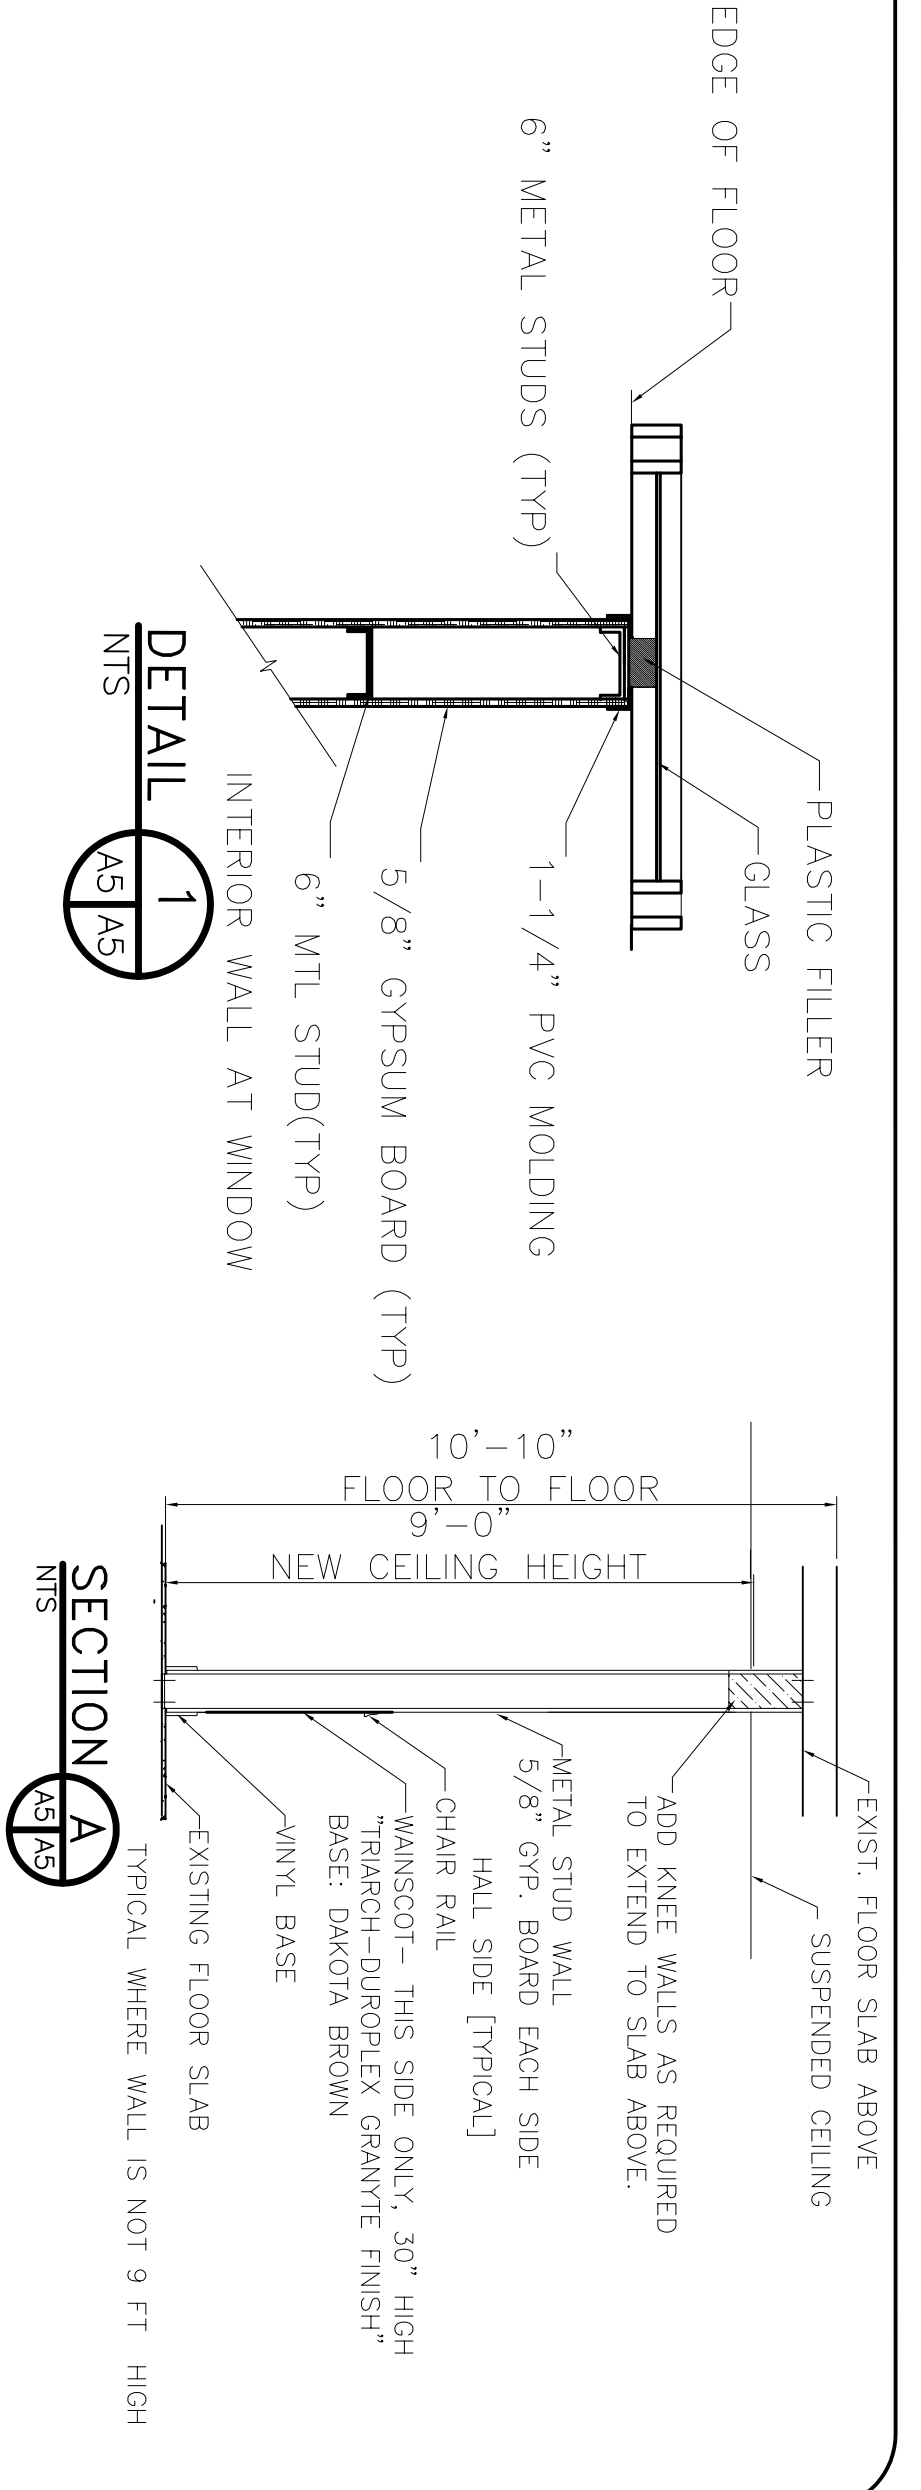

REVISIONS:
 REVISED: 03/18/09cd
 REVISED: 11/05/07ab
 REVISED: 10/10/07ab
 REVISED: 09/19/07ab
 REVISED: 08/20/07ab
 REVISED: 05/17/07ab
 REVISED: 02/19/07
 REVISED: 01/23/07

CONTRACT SET- 10/10/07