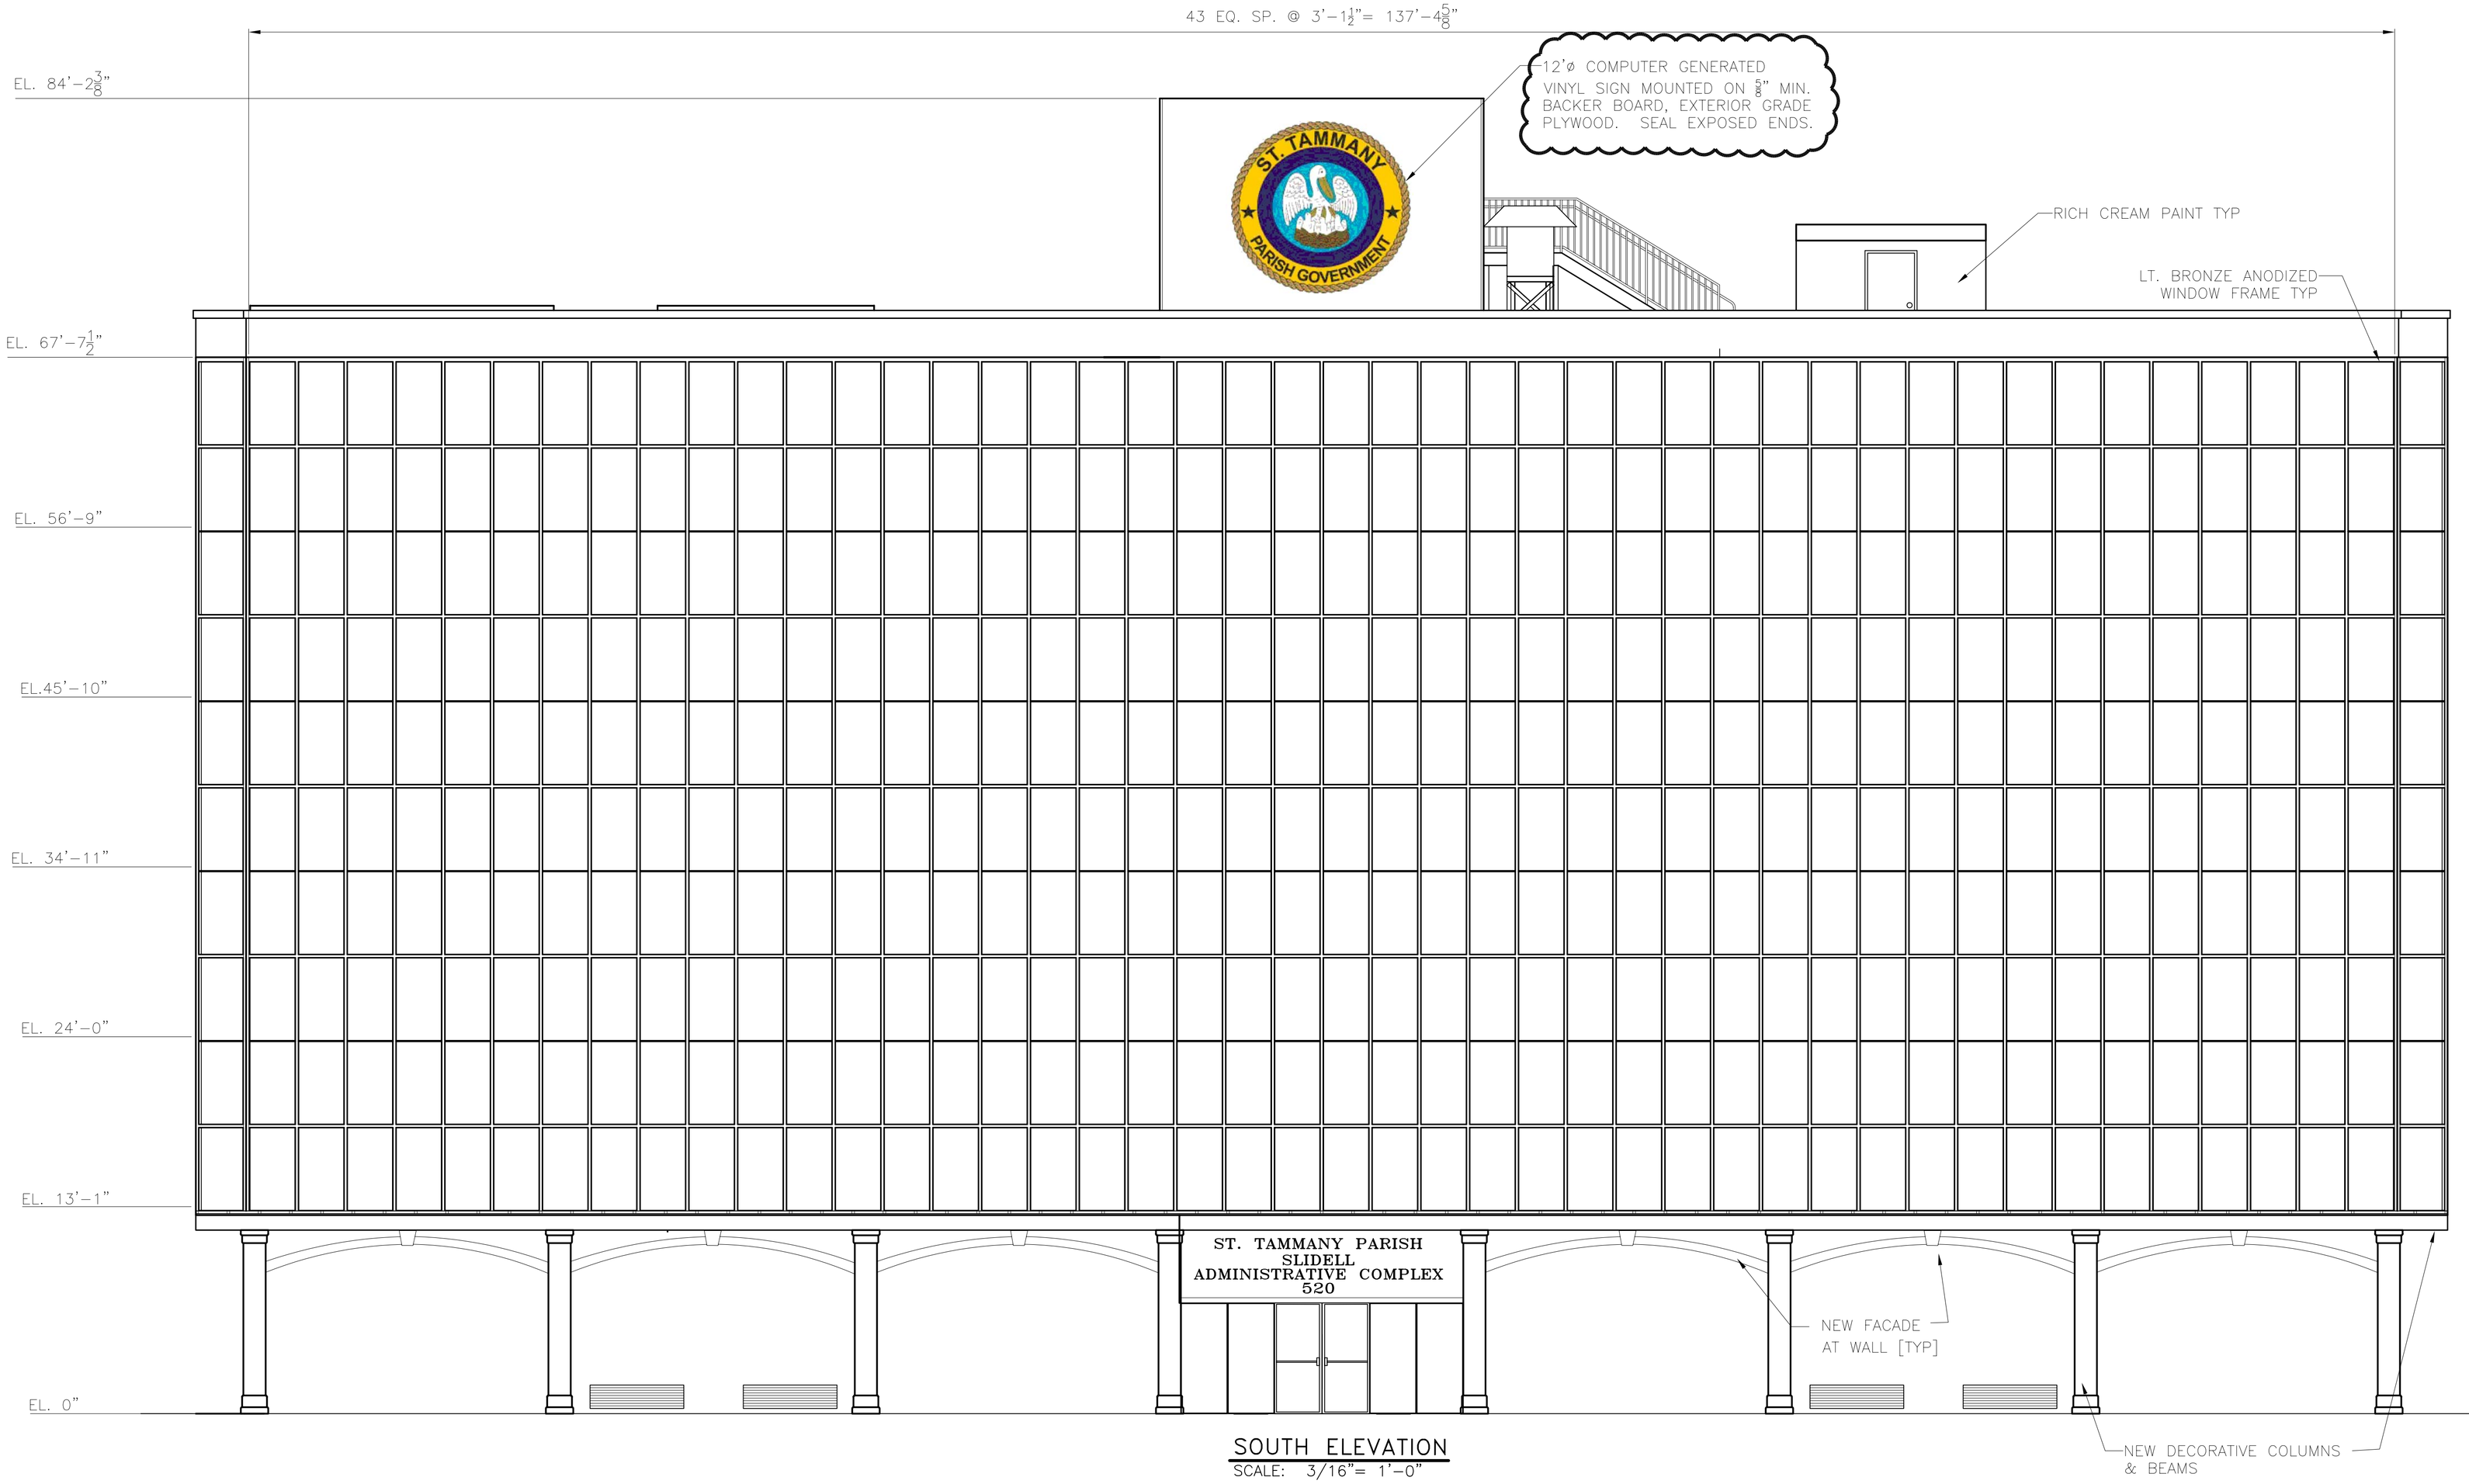

SOUTH ELEVATION
SCALE: 3/16"= 1'-0"

= ADDENDUM 2 CHANGE

REVISED: 05/17/07ab
REVISED: 05/07/07ab
REVISED: 03/07/07ab
REVISED: 02/19/07

CONTRACT SET- 10/10/07

SOUTH ELEVATION

ST. TAMMANY PARISH ADMIN. COMPLEX
520 OLD SPANISH TRAIL
SLIDELL, LOUISIANA

RENOVATE OFFICE BUILDING

DAMMON ENGINEERING. INC.
1095 FLORIDA AVENUE 985-649-5832 SLIDELL, LA. 70458
DAMMONENGINEERING.COM

SCALE:AS NOTED
FILE:
JOB NO. 1729
DATE:1-8-07
SHEET A-8
OF