
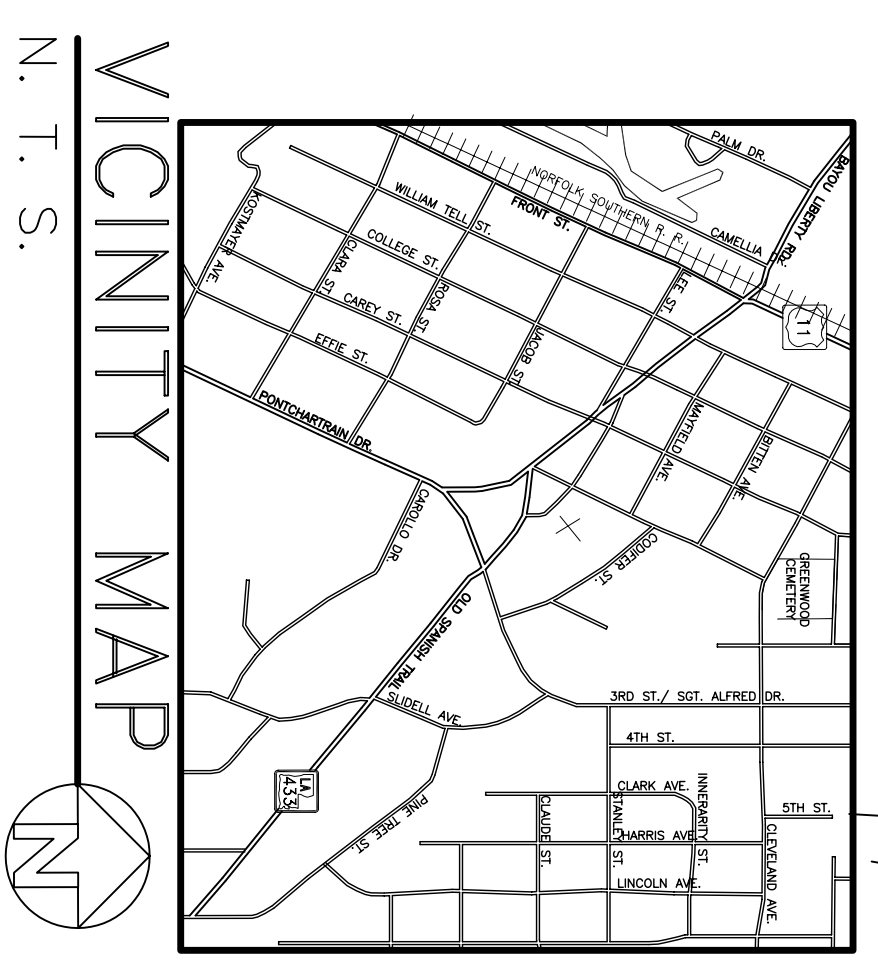


SGT ALFRED DRIVE

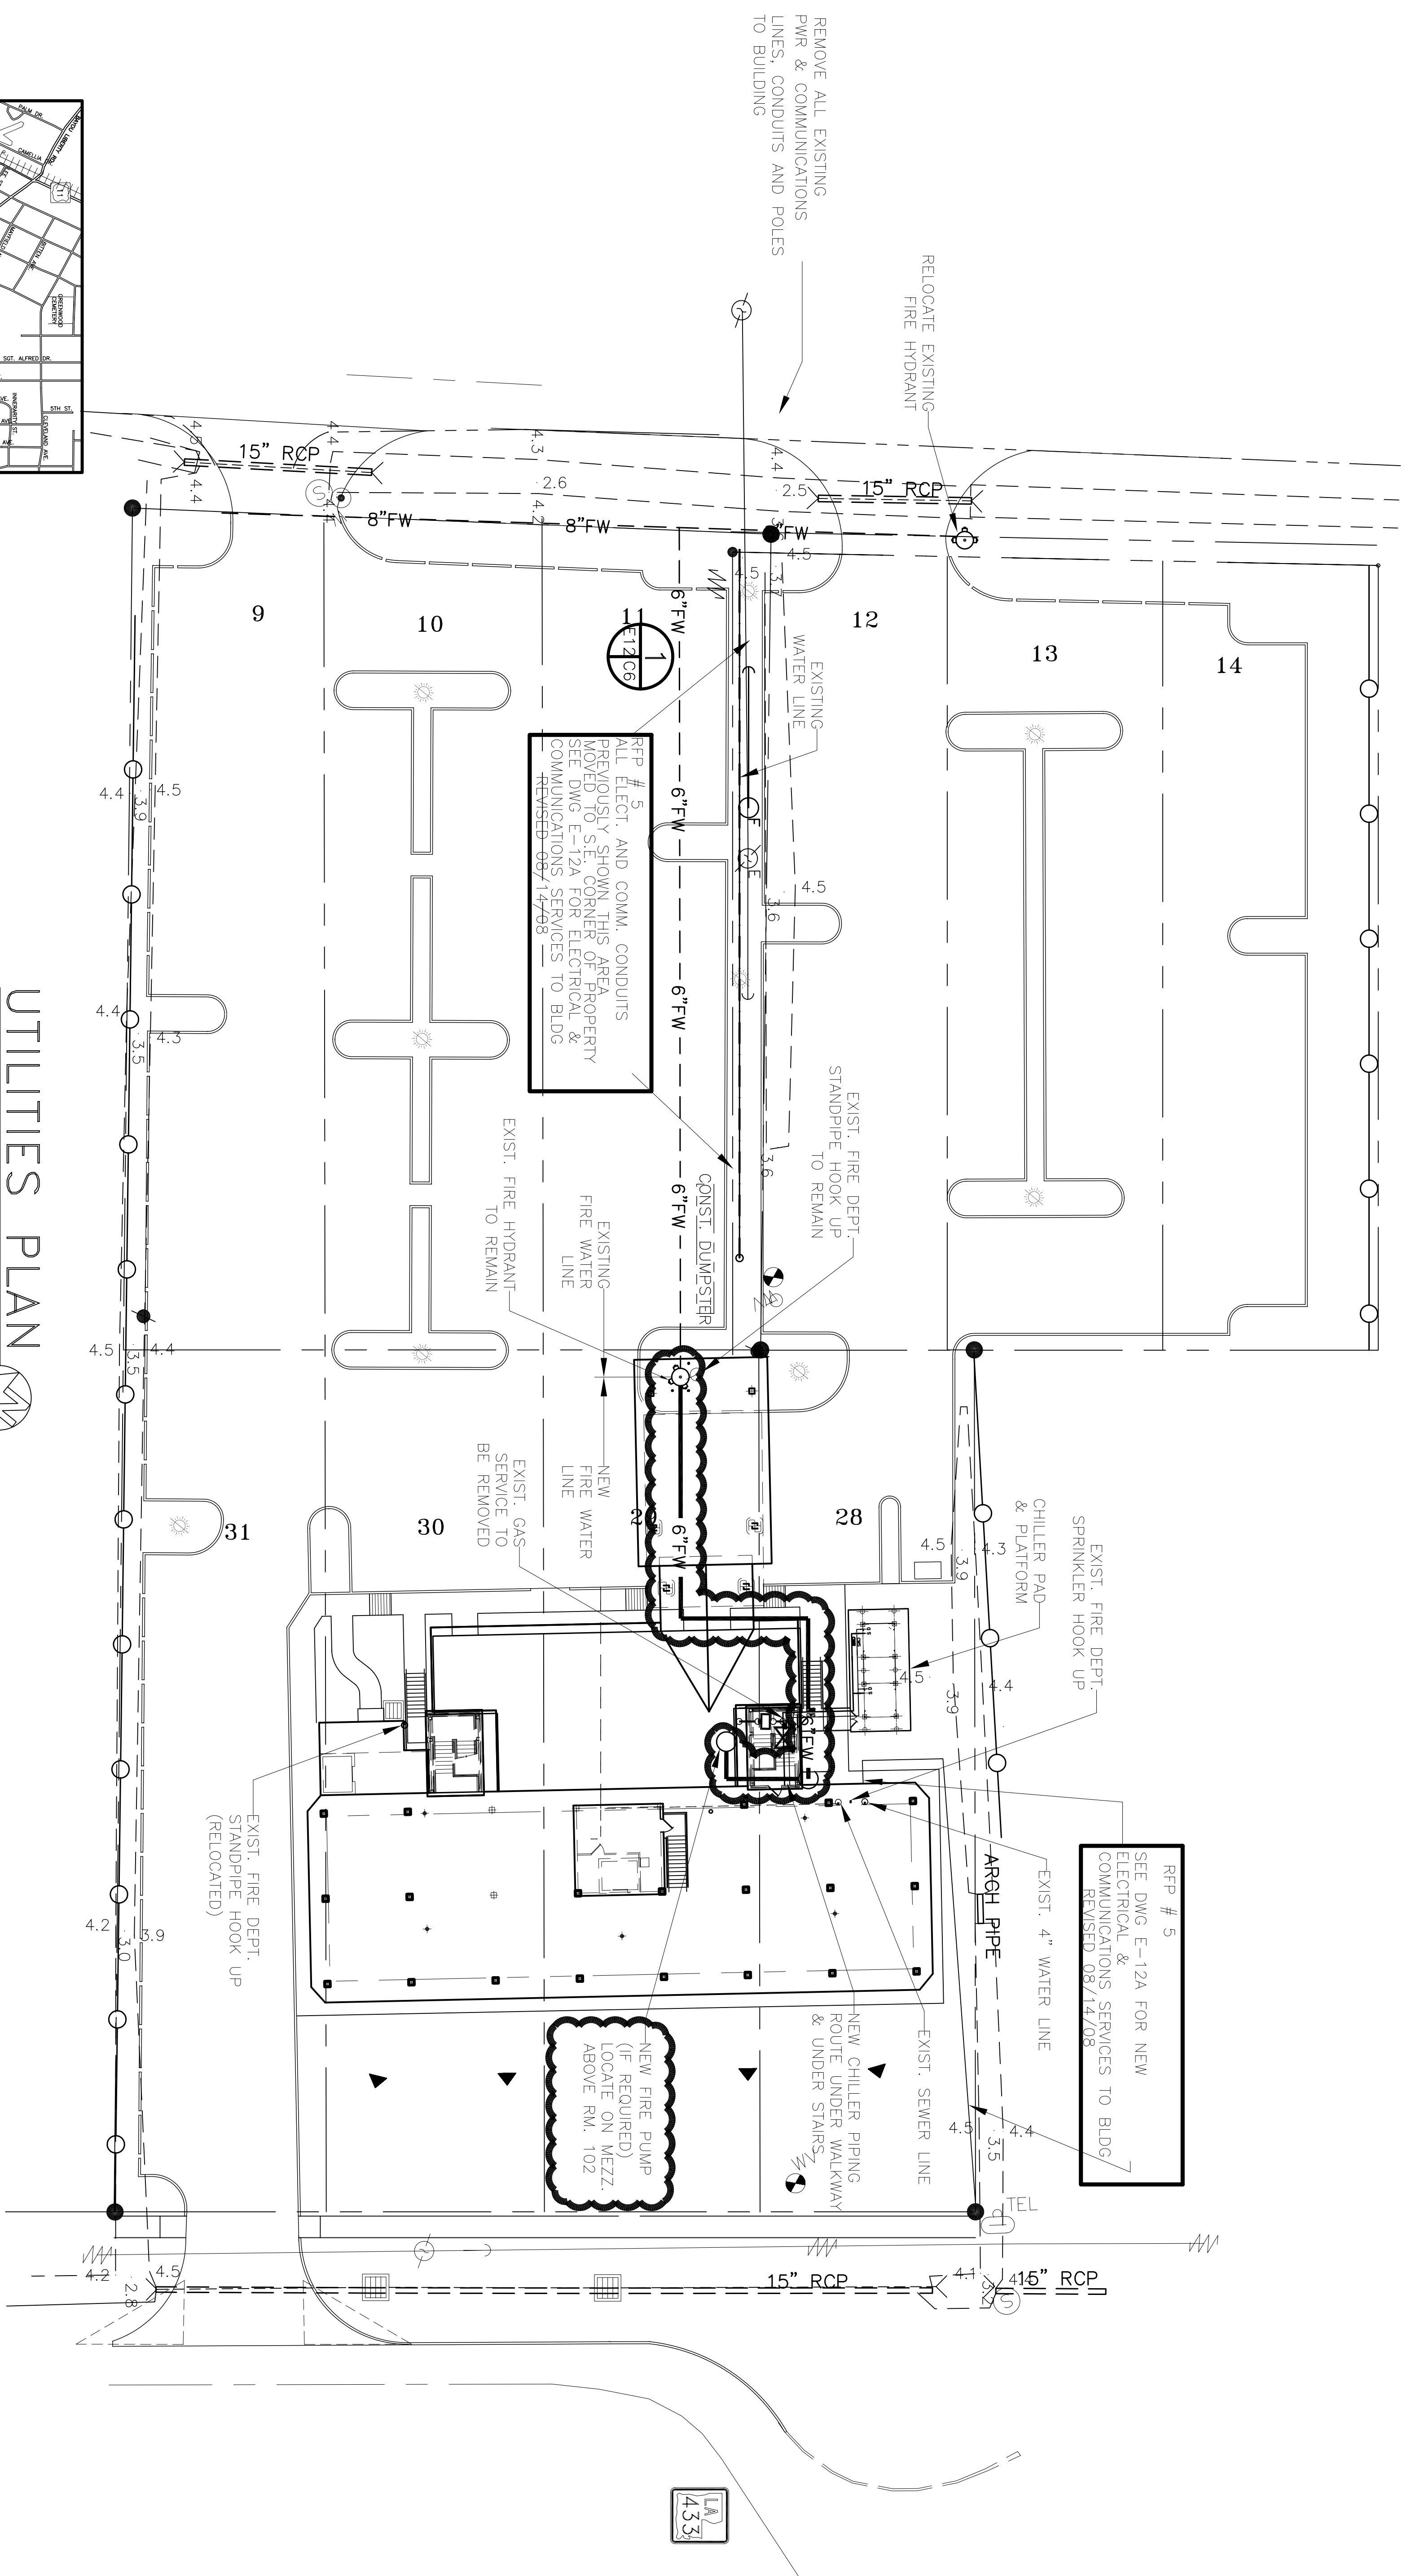


UTILITIES PLAN
SCALE: 1"=20'-0"

RFP # 5
SEE DWG E-12A FOR NEW ELECTRICAL & COMMUNICATIONS SERVICES TO BLDG
REVISED 08/14/08

RFP # 5
ALL ELECT. AND COMM. CONDUITS PREVIOUSLY SHOWN THIS AREA MOVED TO S.E. CORNER OF PROPERTY SEE DWG E-12A FOR ELECTRICAL & COMMUNICATIONS SERVICES TO BLDG
REVISED 08/14/08

NEW FIRE PUMP (IF REQUIRED) LOCATE ON MEZZ ABOVE RM. 102

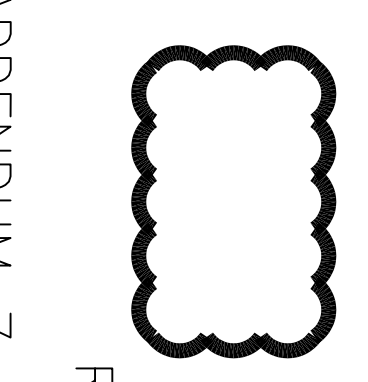

REVISED: 08-14-08 ED
REVISED: 03-07-07ab
REVISED: 08-20-07ab
REVISED: 03-07-07ab

CONTRACT SET- 10/10/07

UTILITIES PLAN
ST. TAMMANY PARISH ADMIN COMPLEX
520 OLD SPANISH TRAIL
SLIDELL, LOUISIANA

RENOVATE OFFICE BUILDING
DAMMON ENGINEERING, INC.
1095 FLORIDA AVENUE 985-649-5832 SLIDELL, LA. 70458
DAMMONENGINEERING.COM

SCALE: 1"=20'
FILE:
JOB NO. 1729
DATE: 1-8-07
SHEET
C-6A
OF