


PANEL: PL-6 LOCATION: TOWERS BLD 6TH FLOOR MECHANICAL ROOM FEEDER SOURCE: MDP 1 CKT 6										VOLTAGE: 277/440V, 200A, 3PH, 4W TYPE: SURFACE MOUNT WITH EQ. GRND. BAR, W/ MAIN BRKR SQUARE D TYPE OO LOAD CENTER W/MAIN BRK									
CKT. NO.	LOAD DESCRIPTION	BREAKER	LOAD (VA)	AMP	POLE	LOCATION	CKT. NO.	LOAD DESCRIPTION	BREAKER	LOAD (VA)	AMP	POLE	LOCATION	CKT. NO.					

PANEL: PL-7 LOCATION: TOWERS BLD PENTHOUSE FEEDER SOURCE: P66 CKT 9										VOLTAGE: 240/120V, 125A, 1Ø, 3W TYPE: SURFACE MOUNT WITH EQ. GRND. BAR, W/ MAIN BRKR SQUARE D TYPE OO LOAD CENTER									
CKT. NO.	LOAD DESCRIPTION	BREAKER	LOAD (VA)	AMP	POLE	LOCATION	CKT. NO.	LOAD DESCRIPTION	BREAKER	LOAD (VA)	AMP	POLE	LOCATION	CKT. NO.					


0000 INDICATES ITEMS CHANGED- 05/29/08
 102133 INDICATES ITEMS CHANGED- 02/26/08
 102133 INDICATES ITEMS CHANGED- 06/26/08

PANEL: PL-6 LOCATION: TOWERS BLD 6TH FLOOR MECHANICAL ROOM FEEDER SOURCE: PL-6 CKT 9										VOLTAGE: 240/120V, 125A, 1Ø, 3W TYPE: SURFACE MOUNT WITH EQ. GRND. BAR, W/ MAIN BRKR SQUARE D TYPE OO LOAD CENTER									
CKT. NO.	LOAD DESCRIPTION	BREAKER	LOAD (VA)	AMP	POLE	LOCATION	CKT. NO.	LOAD DESCRIPTION	BREAKER	LOAD (VA)	AMP	POLE	LOCATION	CKT. NO.					


NEW POWER PANELS

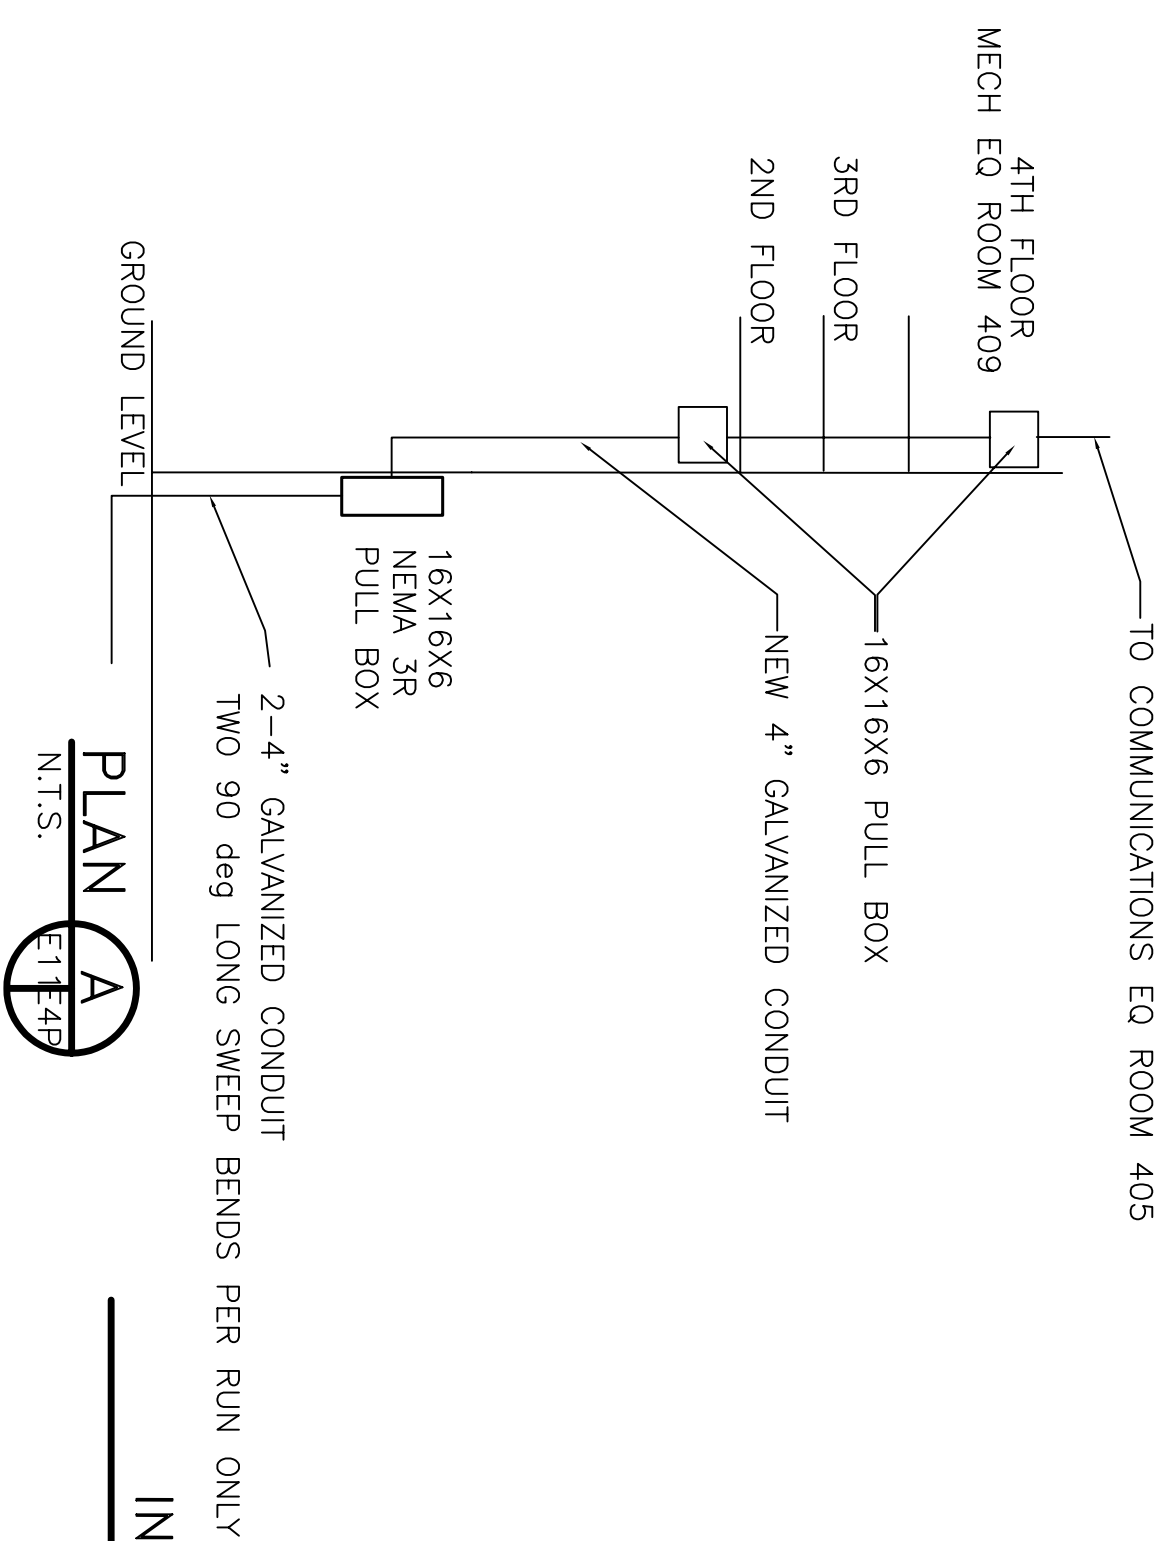

SECURITAS SYSTEM ONE LINE DIAGRAM

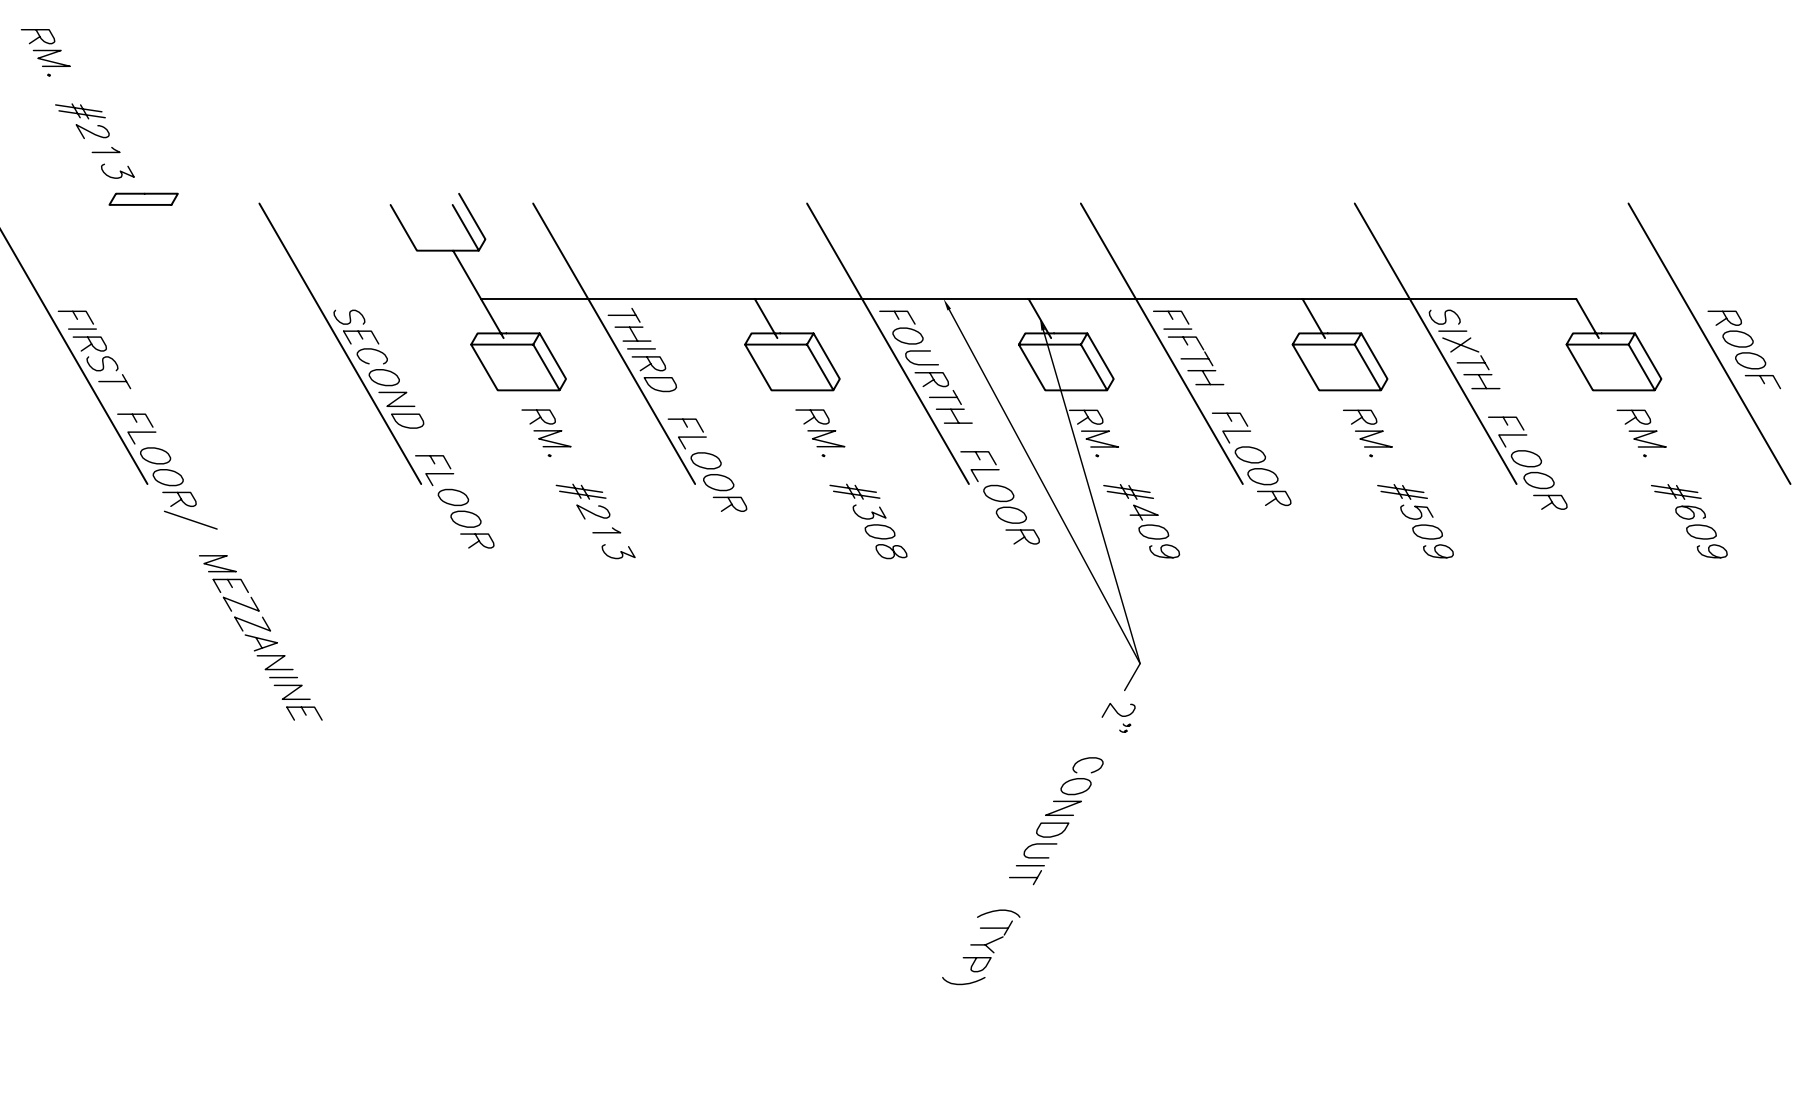

INTERDUCT ONE LINE DIAGRAM

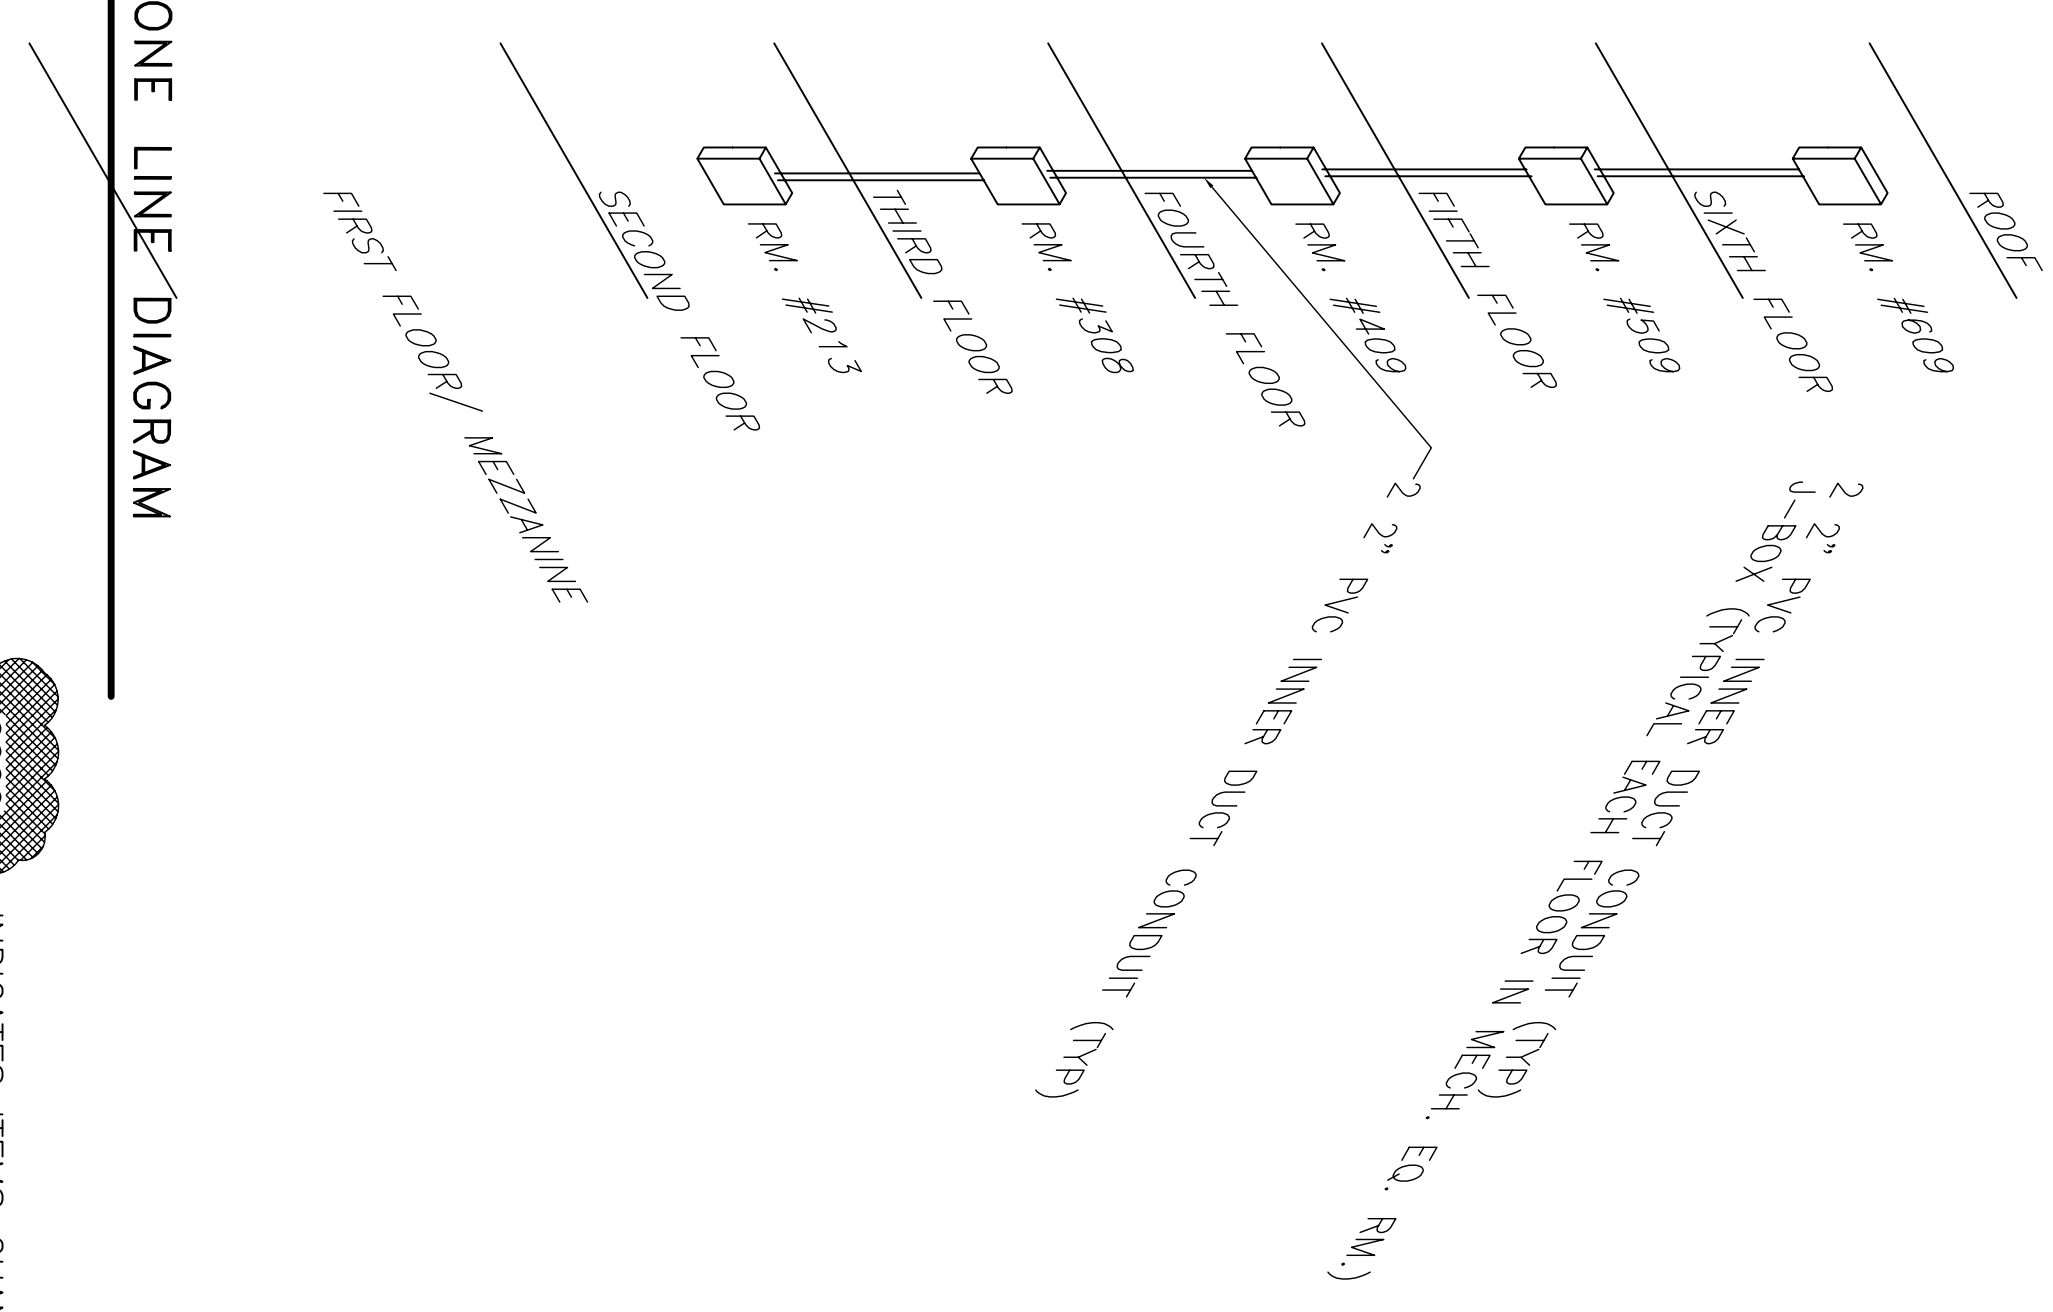

NEW POWER PANELS
 ST. TAMMANY PARISH ADMIN. COMPLEX
 520 OLD SPANISH TRAIL
 SLIDELL, LOUISIANA

DAMMON ENGINEERING. INC.
 1095 FLORIDA AVENUE 985-649-5832 SLIDELL, LA. 70458
 DAMMONENGINEERING.COM

SCALE: AS NOTED
 FILE:
 JOB NO.
 DATE: 1-8-07
 SHEET

E 11

RFP # 2 11-13-07

01/28/09 PER K41-0b
 09/29/08 db
 07/26/09db
 11/05/09db

NOTE:
 CONTRACTOR SHALL BALANCE ALL PANELS.