ACCESS CONTROL SINGLE DOOR WITH CARD READER, MAGNETIC LOCK, REX, JUNCTION BOX,DOOR CONTACT

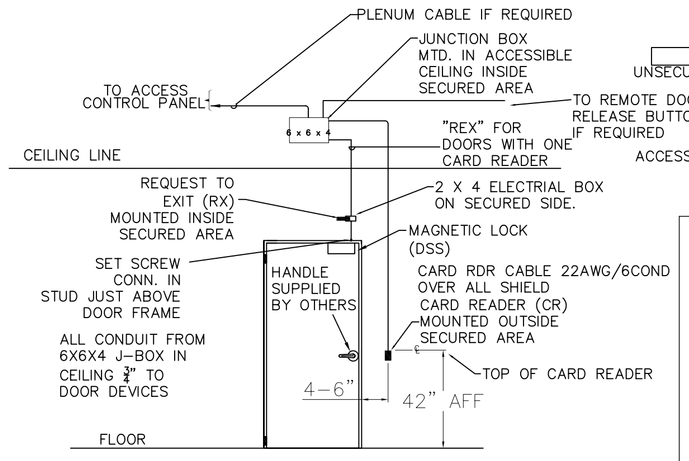

ALL CONDUIT IS 3/4 INCH EMT.

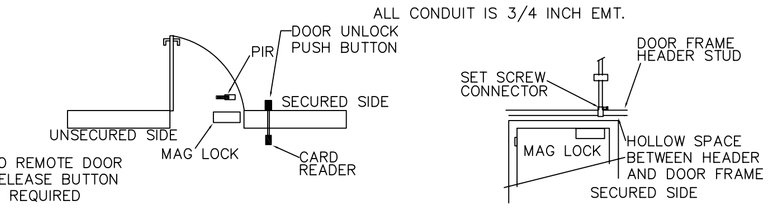

ACCESS CTRL CONDUIT LAYOUT SINGLE DOOR MAG.DWG

CONDUIT DOOR LAYOUT SINGLE DOOR MAG LOCK

ACCESS CONTROL DOUBLE DOOR WITH CARD READER, MAGNETIC LOCK, REX, JUNCTION BOX,DOOR CONTACT

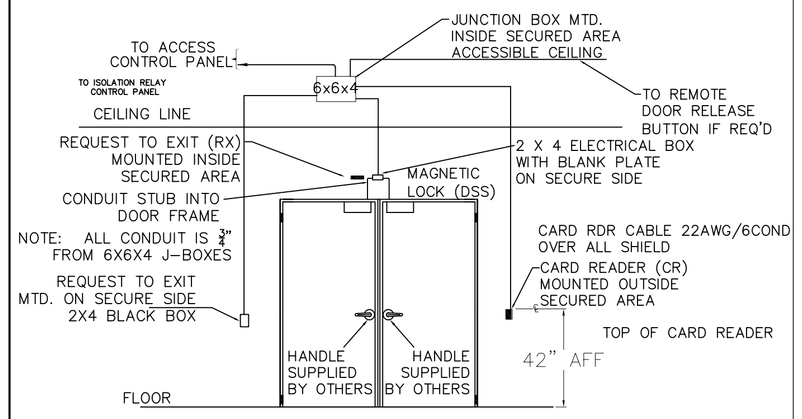

CONDUIT DOOR LAYOUT DOUBLE DOOR MAG LOCK

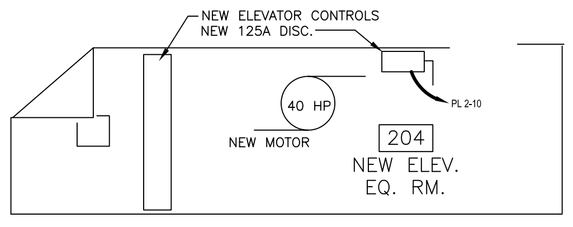

NEW WEST ELEVATOR M/C ROOM DETAIL

N. T. S.

LEGEND

- NEW DUPLEX RECEPTACLE
- EXHAUST FAN
- SECURITY ACCESS DOOR (SCANNER BY OTHERS)
- COMM @ DATA WALL PORT
- (U) COLUMN MOUNTED UTLILITY
- (PP) FUTURE TELEPHONE DATA & POWER PLOES BY OTHERS

NOTES

ALL NEW POWER PANELS ARE TO BE MOUNTED ON THE NORTH WALL OF THE MECHANICAL ROOMS

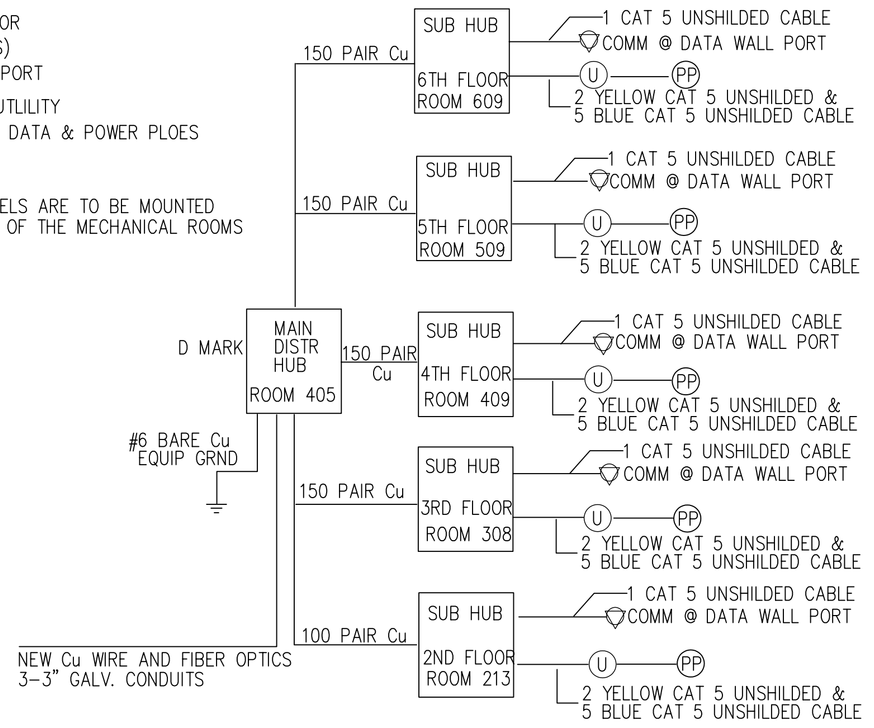

TYPICAL COMMUNICATIONS DATA & POWER ONE LINE DIAGRAM

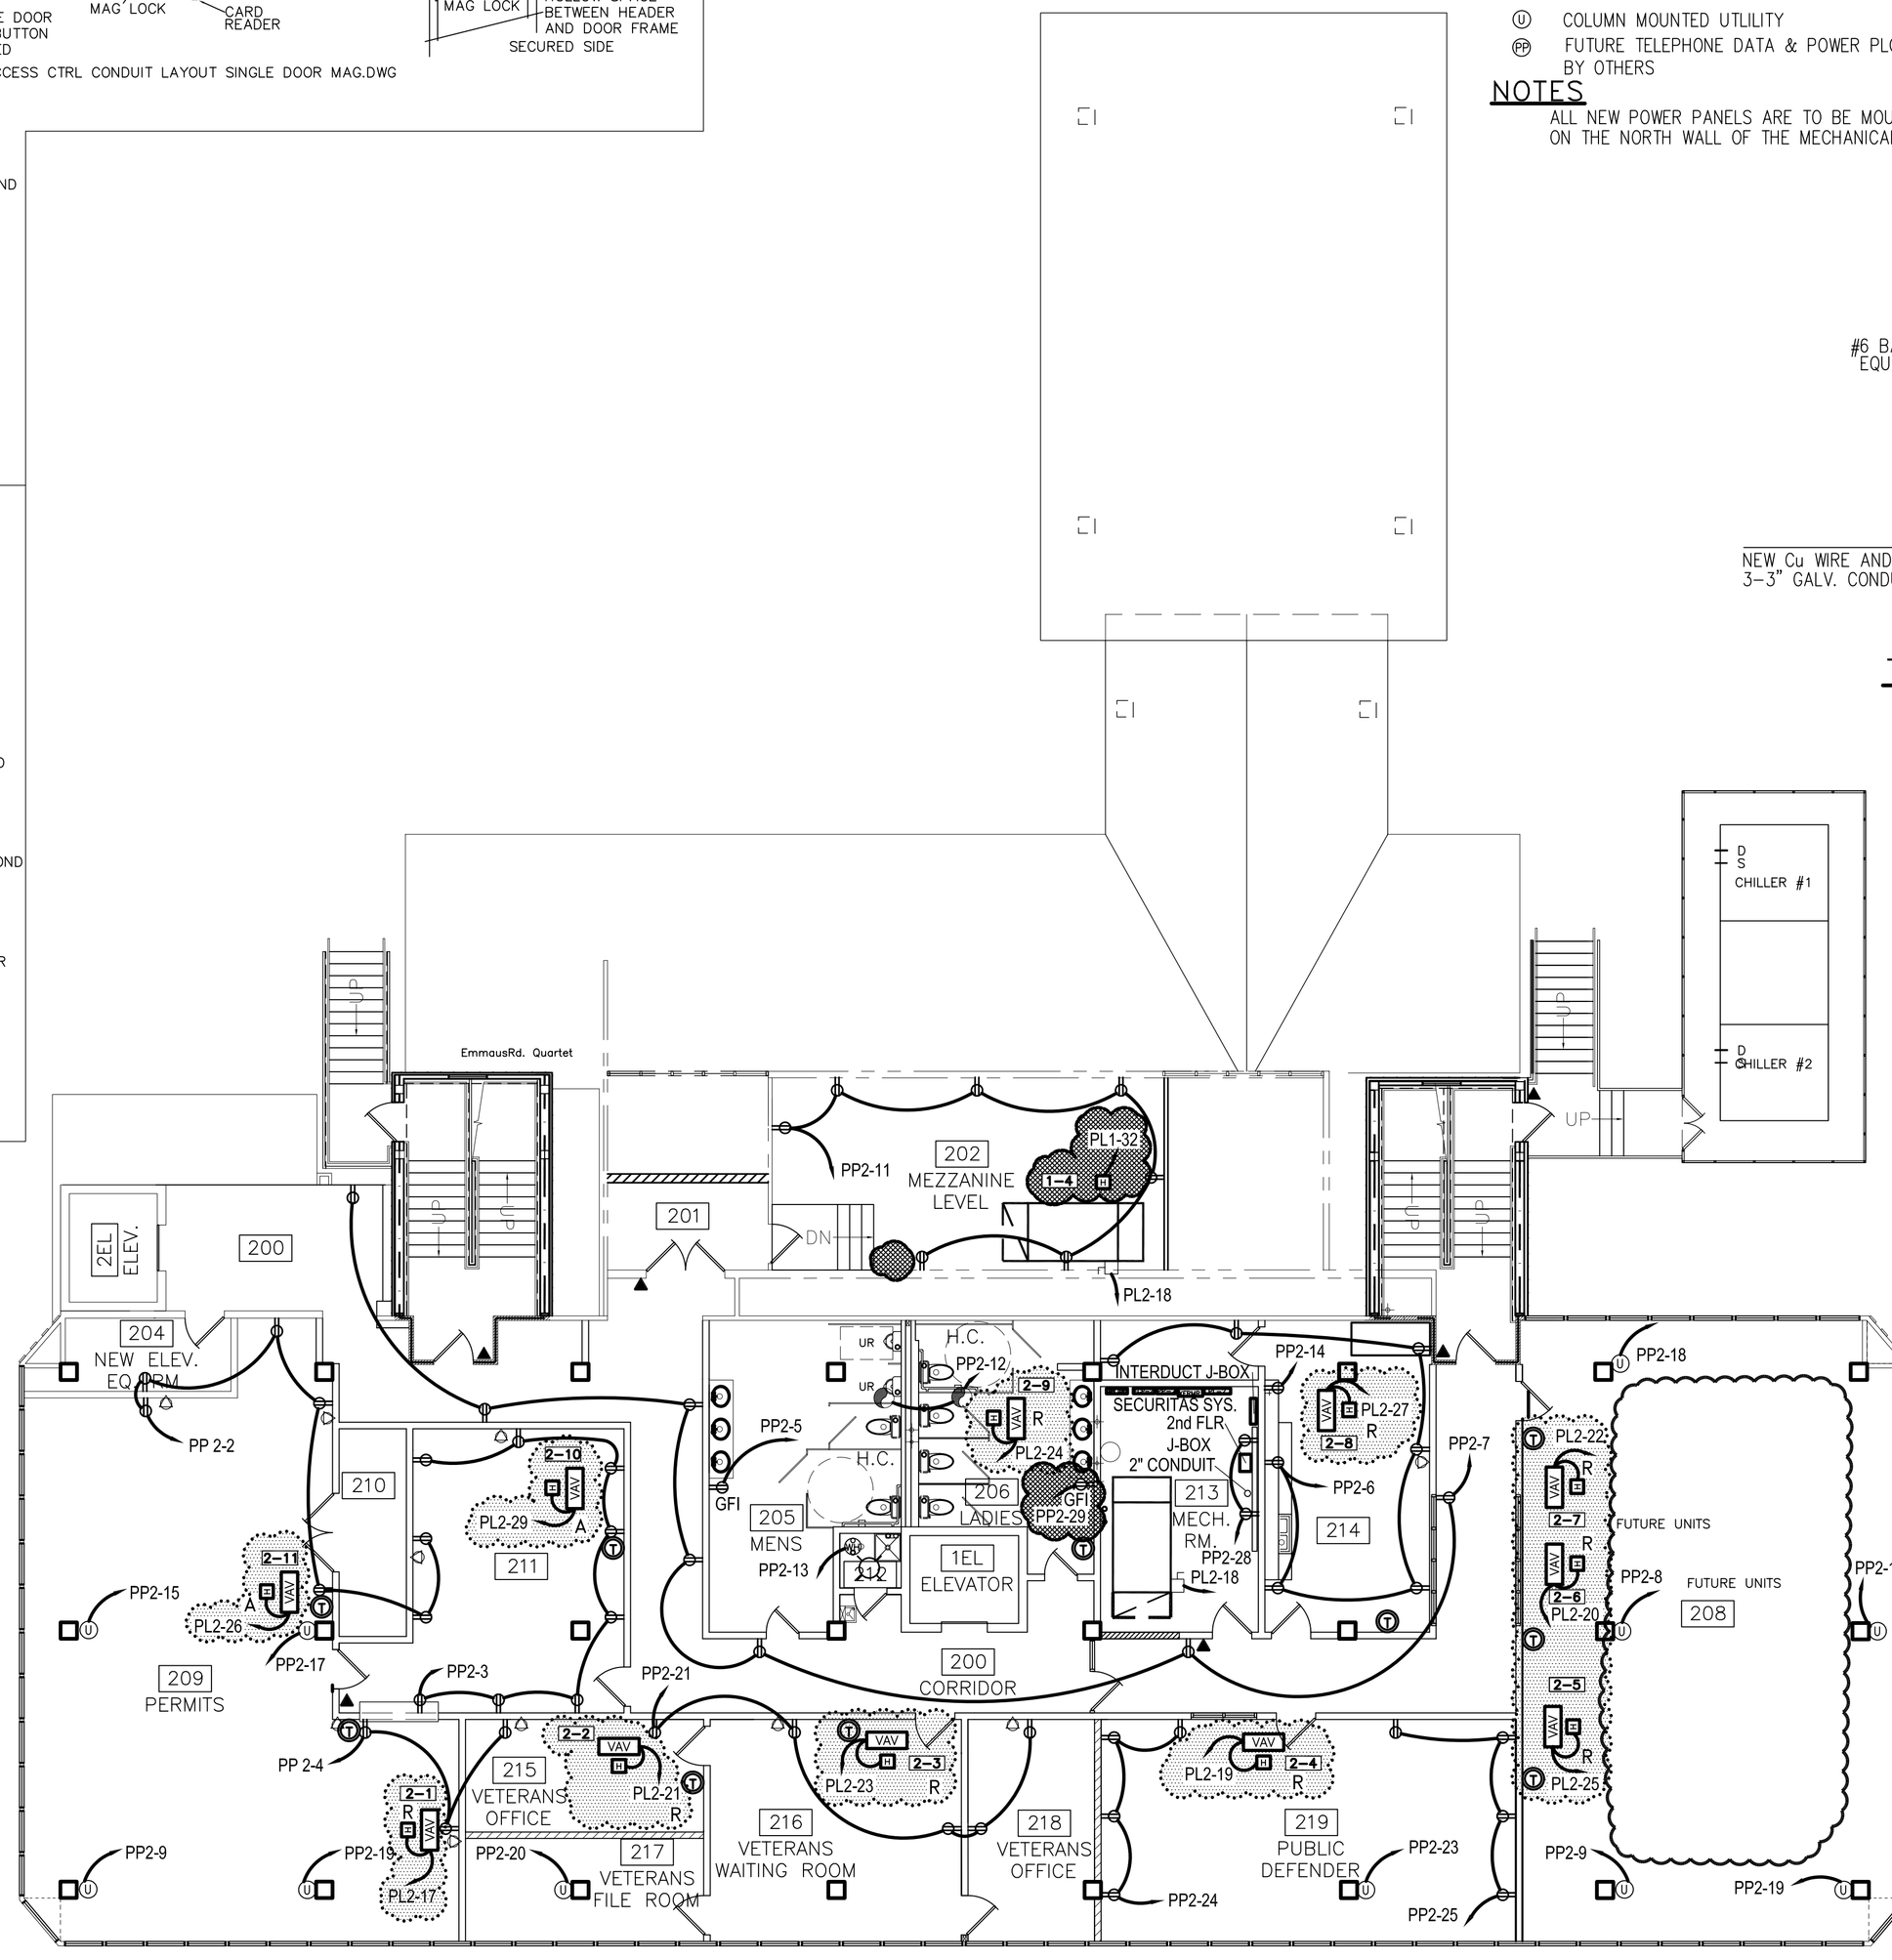

SECOND FLOOR POWER PLAN

SCALE: 1/8"= 1'-0"

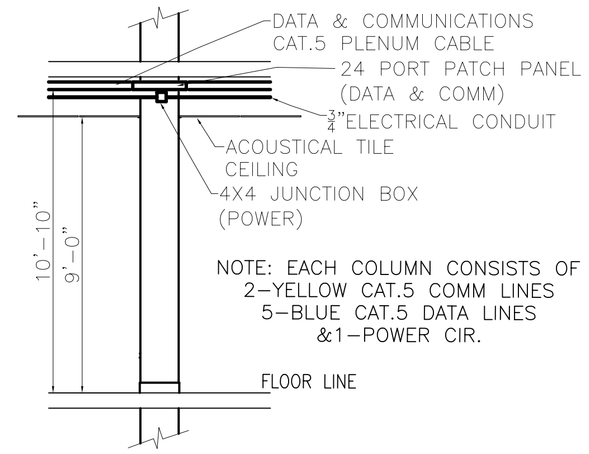

NOTE: EACH COLUMN CONSISTS OF 2-YELLOW CAT.5 COMM LINES 5-BLUE CAT.5 DATA LINES &1-POWER CIR.

COLUMN MOUNTED UTILITY DETAIL

SCALE: NTS

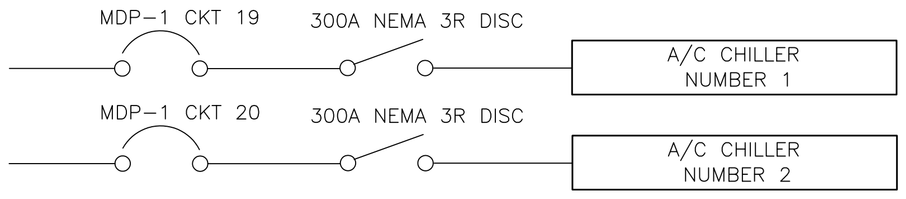

INDICATES ITEMS CHANGED- 02/26/08

PL1-16 -INDICATES ITEMS CHANGED- 06/27/08

0000 R -INDICATES ITEMS CHANGED- 05/29/08

R= RELOCATED

A= ADDED

STAR HVAC REVISED: 05/29/08 ab
HVAC REVISED: 02/26/08 ab
HVAC REVISED: 11/05/07 ab
REVISED: 03/07/07 ab
REVISED: 01/23/07

RFP #2 11-13-07

2ND FLOOR POWER PLAN

ST. TAMMANY PARISH ADMIN. COMPLEX
OLD SPANISH TRAIL
SLIDELL, LOUISIANA

RENOVATE OFFICE BUILDING

DAMMON ENGINEERING. INC.
1095 FLORIDA AVENUE 985-649-5832 SLIDELL, LA. 70458
DAMMONENGINEERING.COM

SCALE:AS NOTED

FILE:

JOB NO. 1729

DATE:1-8-07

SHEET E2P OF