



SGT. ALFRED DRIVE

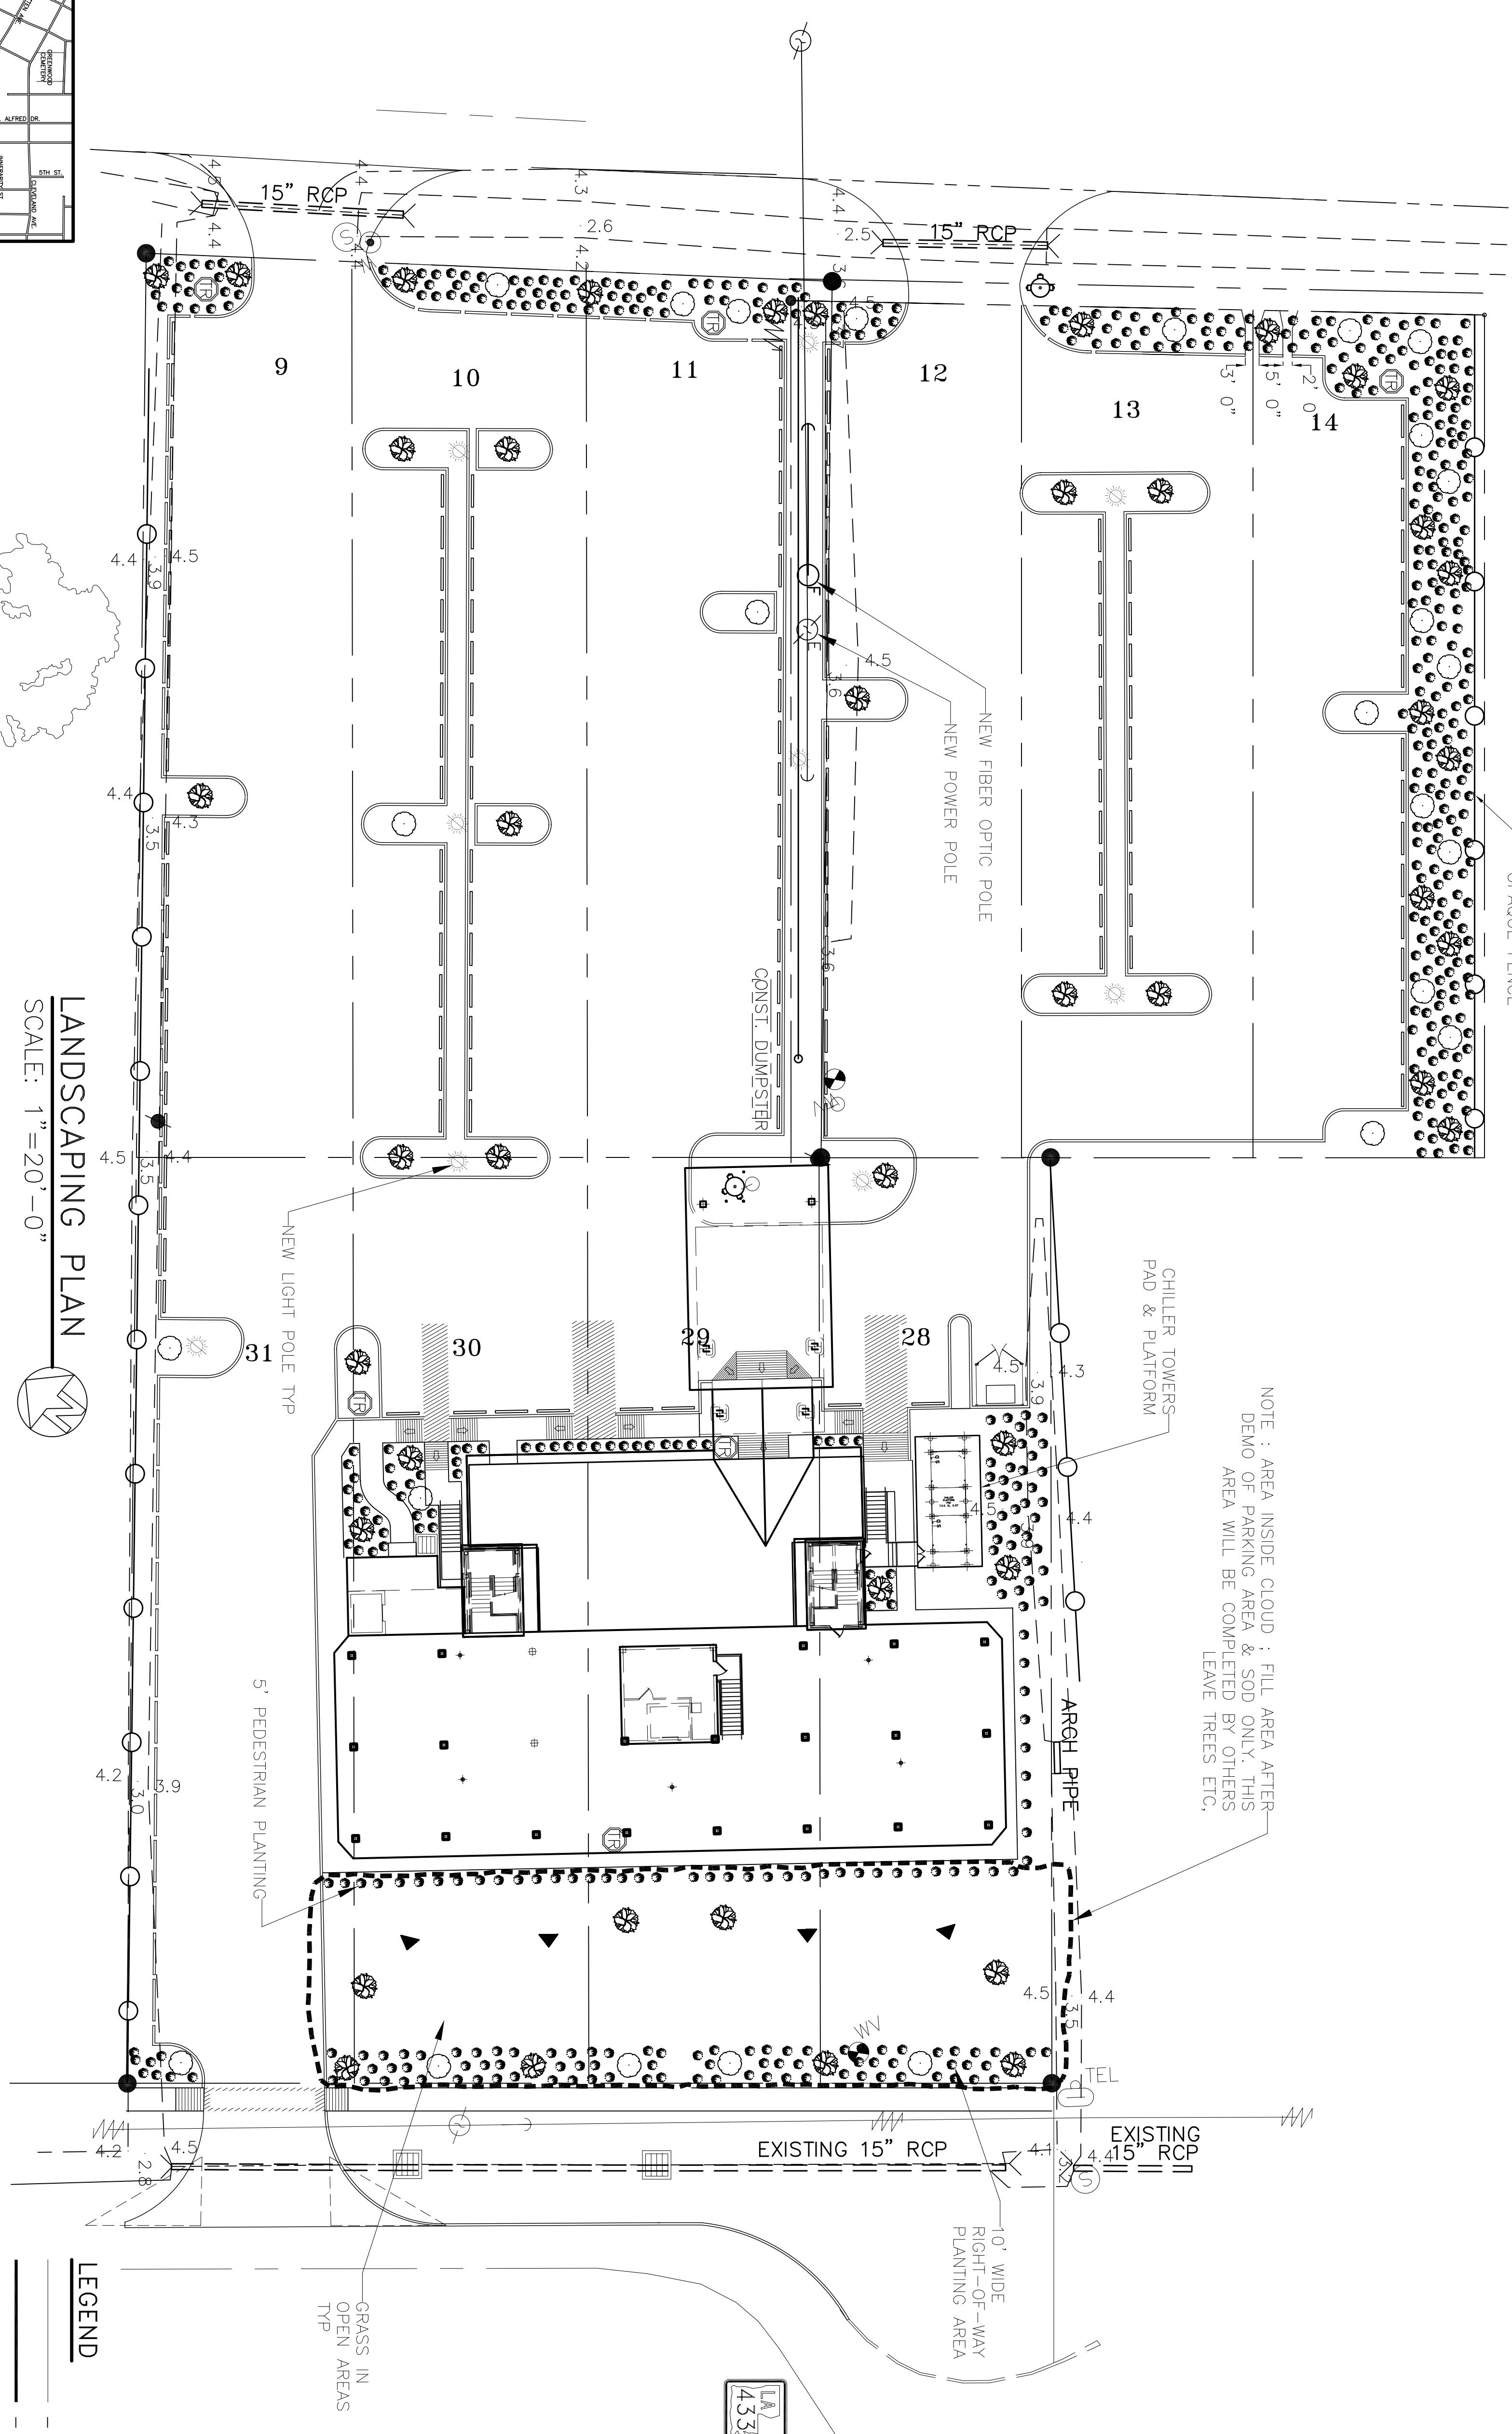


NOTE: AREA INSIDE CLOUD: FILL AREA AFTER DEMO OF PARKING AREA & SOD ONLY. THIS AREA WILL BE COMPLETED BY OTHERS LEAVE TREES ETC.


NOTE: PROVIDE SERVICES OF LAWN SPRINKLER CO. TO DESIGN & INSTALL LAWN SPRINKLER SYSTEM FOR ENTIRE SITE, EXCLUDING DITCH AREAS.

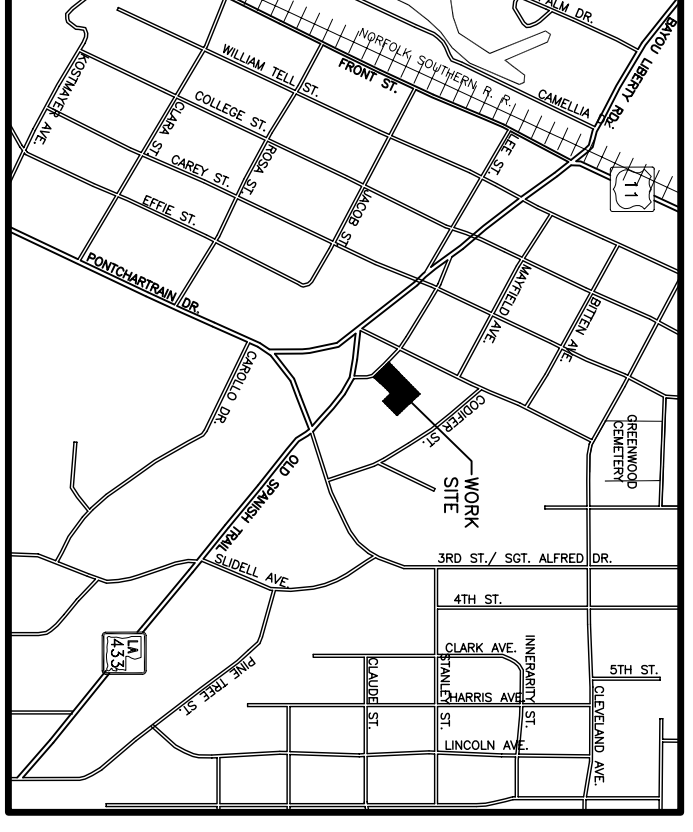


VICINITY MAP
N. T. S.

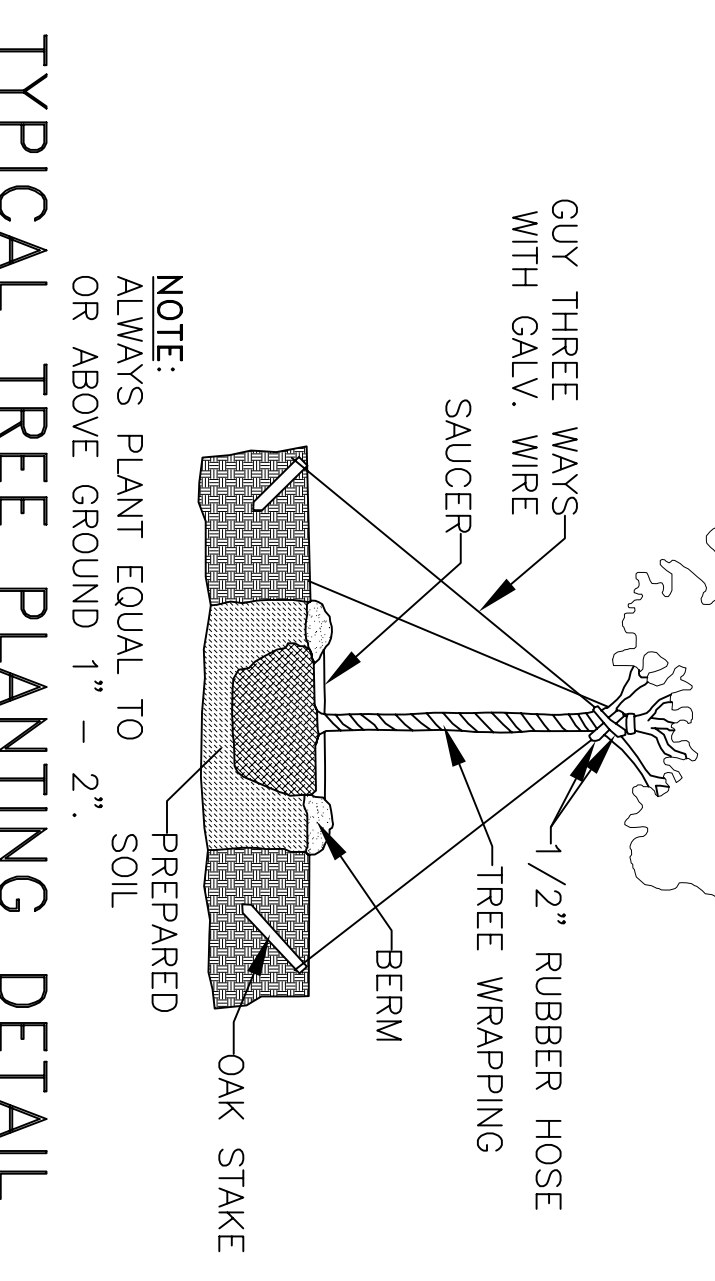

TYPICAL TREE PLANTING DETAIL
NOTE: ALWAYS PLANT EQUAL TO OR ABOVE GROUND 1" - 2" SOIL

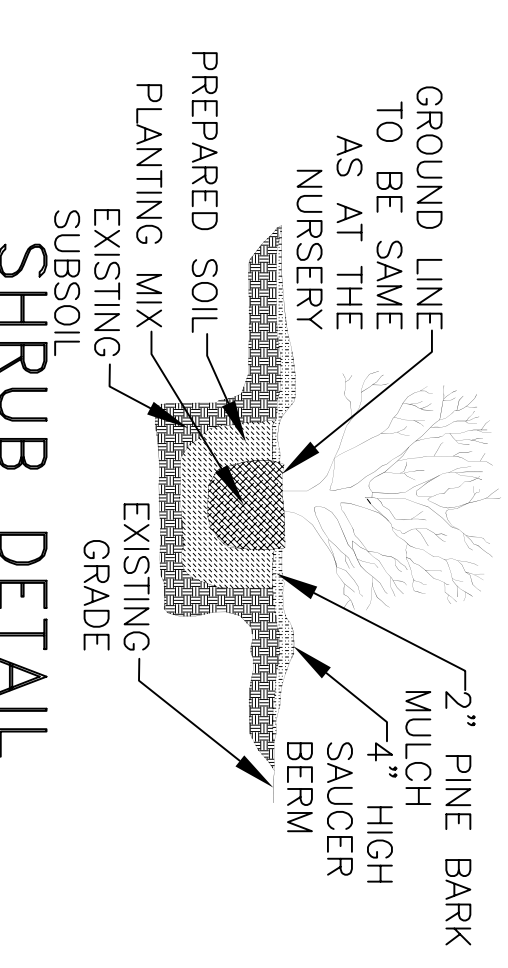

SHRUB DETAIL
NOTE: GROUND LINE TO BE SAME AS AT THE NURSERY

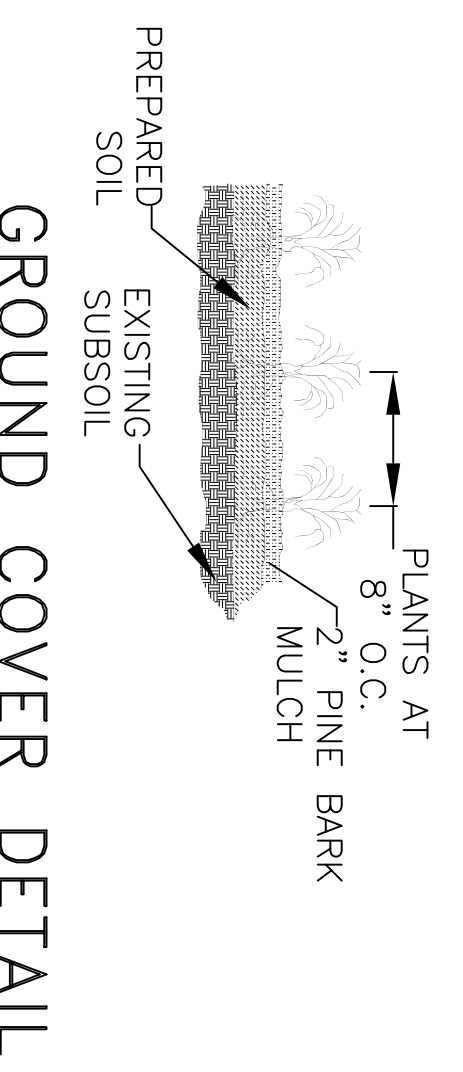

GROUND COVER DETAIL
NOTE: PREPARED SOIL EXISTING SUBSOIL

LANDSCAPING PLAN
SCALE: 1" = 20'-0"

LEGEND

- CENTERLINE OF ROAD
- PROPERTY LINE
- NEW BUILDING
- EXISTING FENCE LINE
- SFTBACK LINE
- GRAPE MYRTLE
- SHUMARD OAK
- LARGE CAMELLIA
- HORN BEAM
- SHRUB
- SEASONAL COLOR BED
- SHRUB BED

REVIEWED: 02/19/07

CONTRACT SET - 10/10/07

LANDSCAPING PLAN

ST. TAMMANY PARISH OFFICE BUILDING
520 OLD SPANISH TRAIL
SLIDELL, LOUISIANA

RENOVATE OFFICE BUILDING

DAMMON ENGINEERING, INC.

1095 FLORIDA AVENUE 985-649-5832 SLIDELL, LA. 70458
DAMMONENGINEERING.COM

SCALE: 1" = 20'

FILE:

JOB NO. 1729

DATE: 1-8-07

SHEET

1

OF