CONTRACT SET- 10/10/07

NOTE
CONTRACTOR TO PROVIDE SHOP DRAWINGS OF STAIRS AND STAIR TOWER STRUCTURE PRIOR TO CONSTRUCTION.

= ADDENDUM 7 CHANGE

ADDENDUM 7 REVISED: 08/20/07ab
REVISED: 03/07/07ab
REVISED: 02/26/07

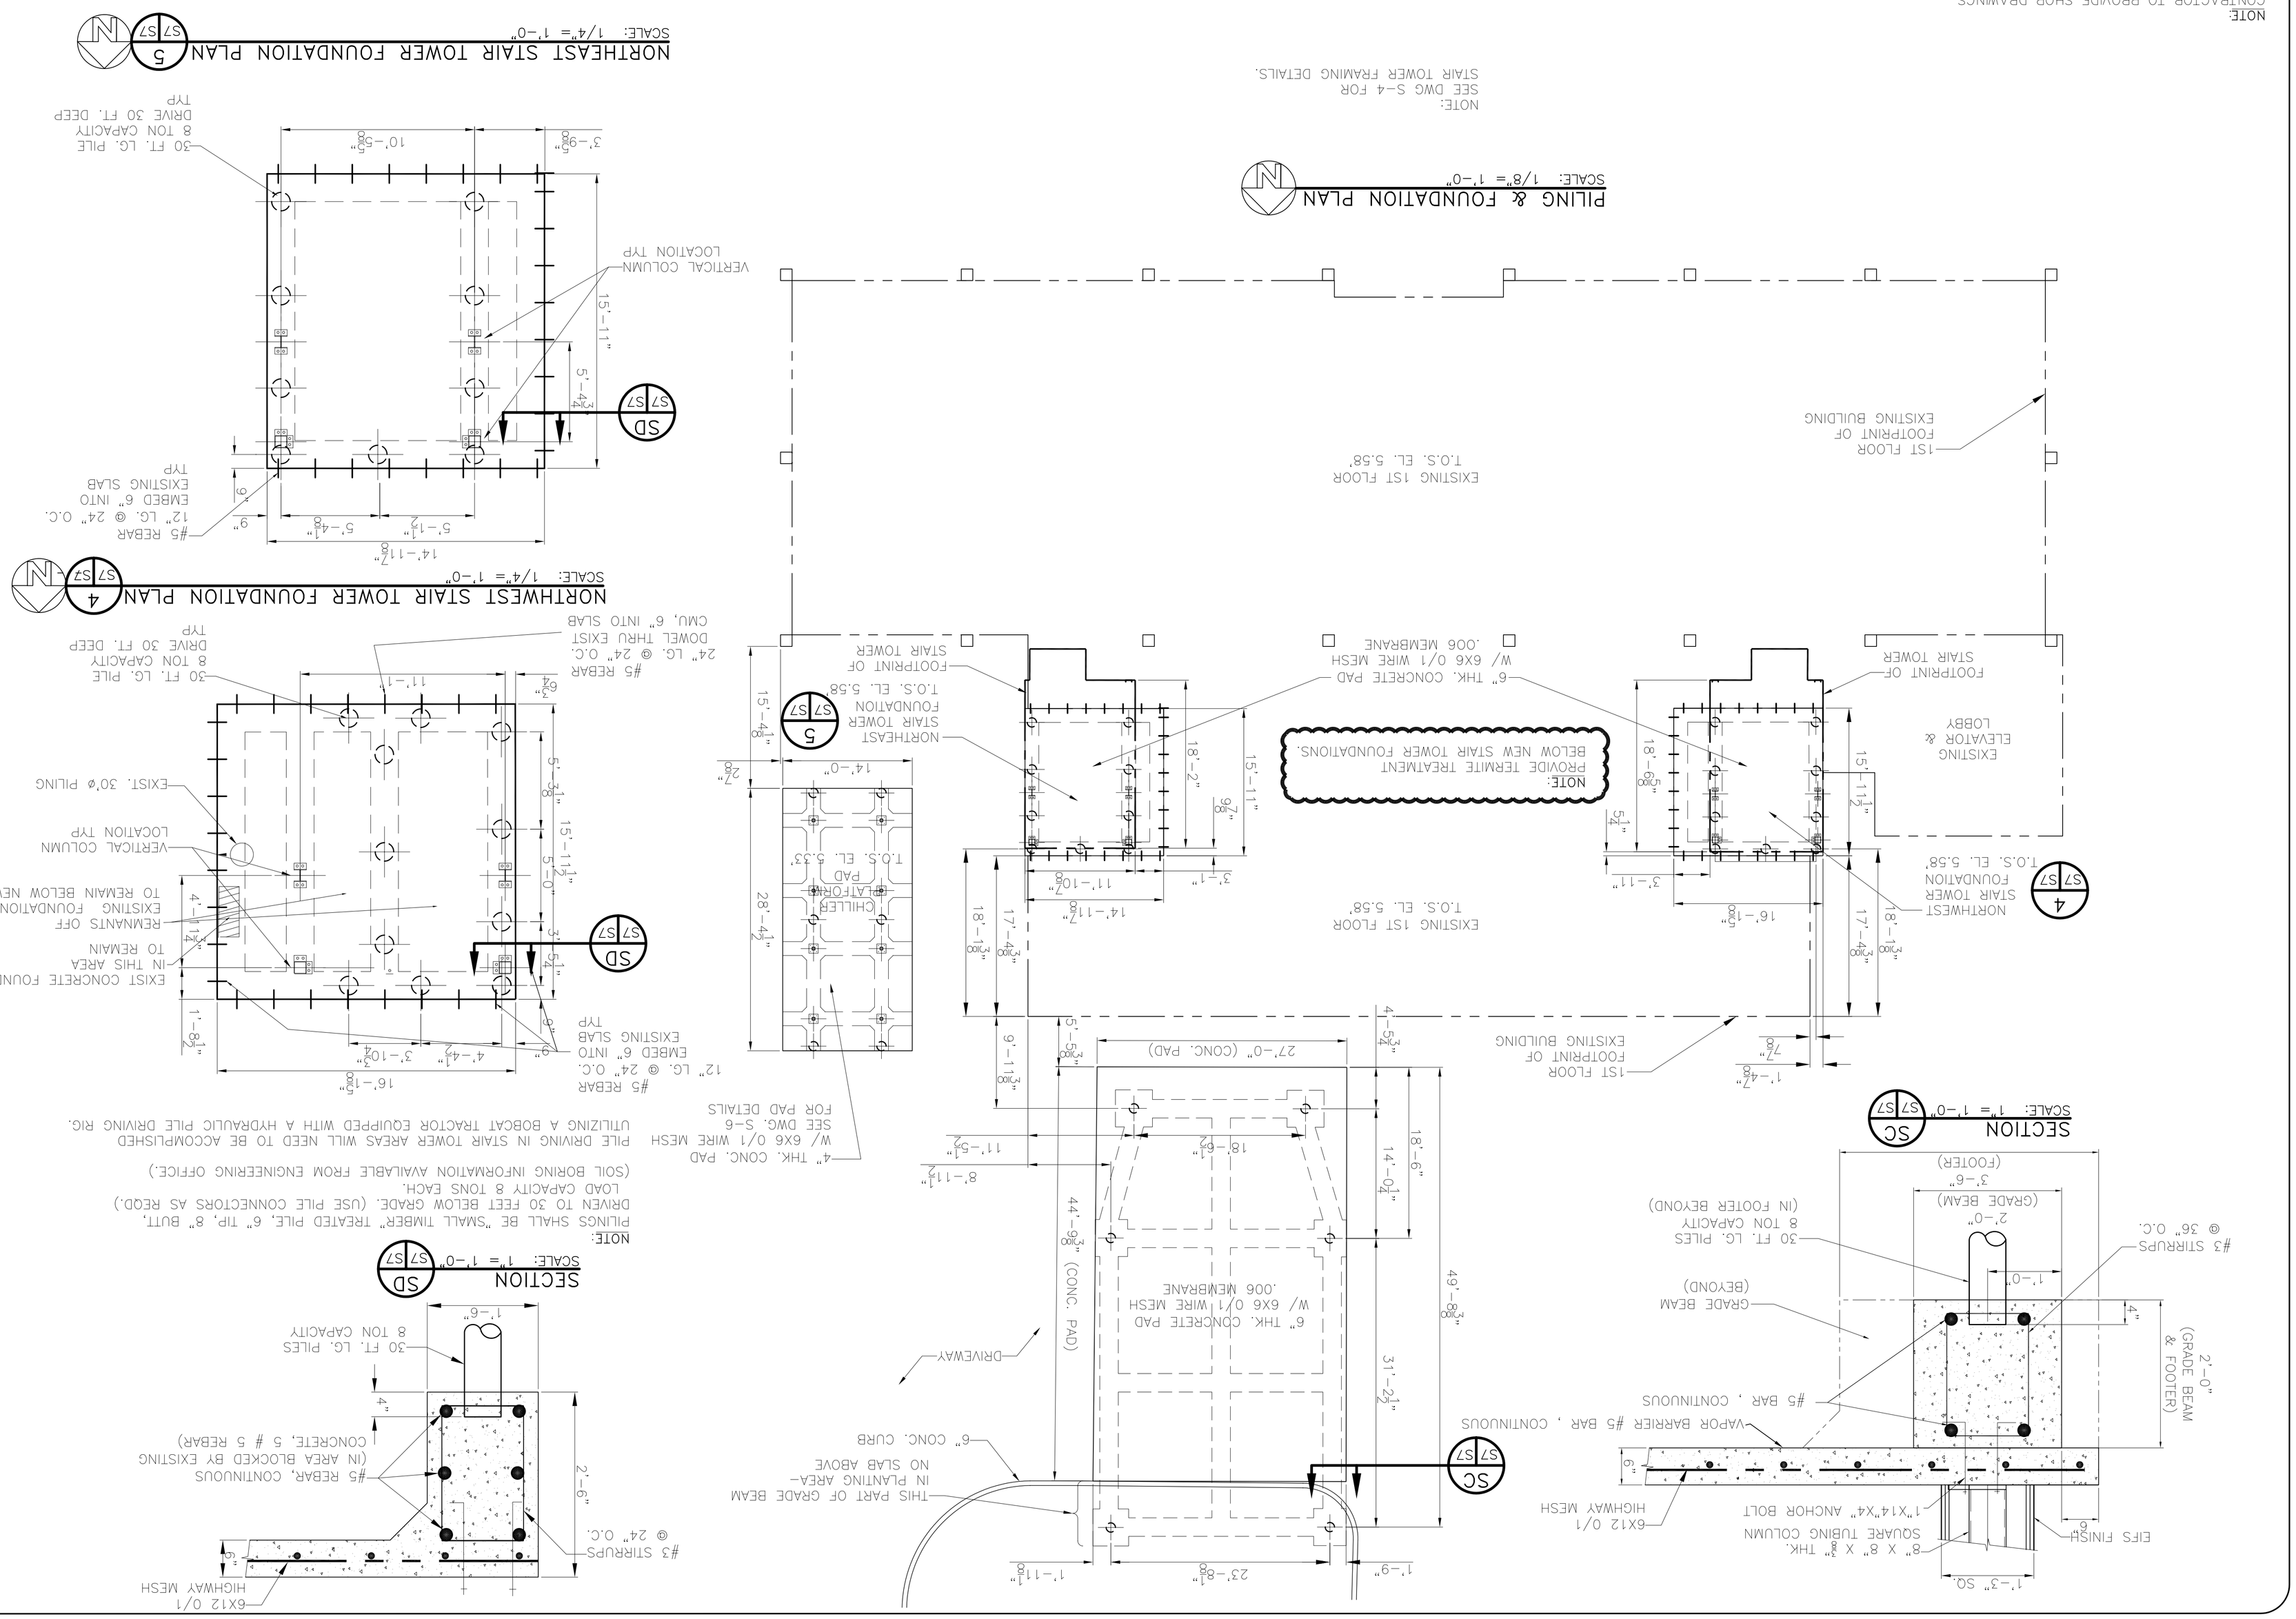

RENOVATE OFFICE BUILDING

DAMMON ENGINEERING, INC.
1095 FLORIDA AVENUE 985-649-5832 SLIDELL, LA. 70458
DAMMONENGINEERING.COM

SCALE:AS NOTED
FILE:
JOB NO.
DATE:1-8-07
SHEET S-7 OF

PILING & FOUNDATION PLAN
ST. TAMMANY PARISH ADMIN COMPLEX
520 OLD SPANISH TRAIL
SLIDELL, LOUISIANA