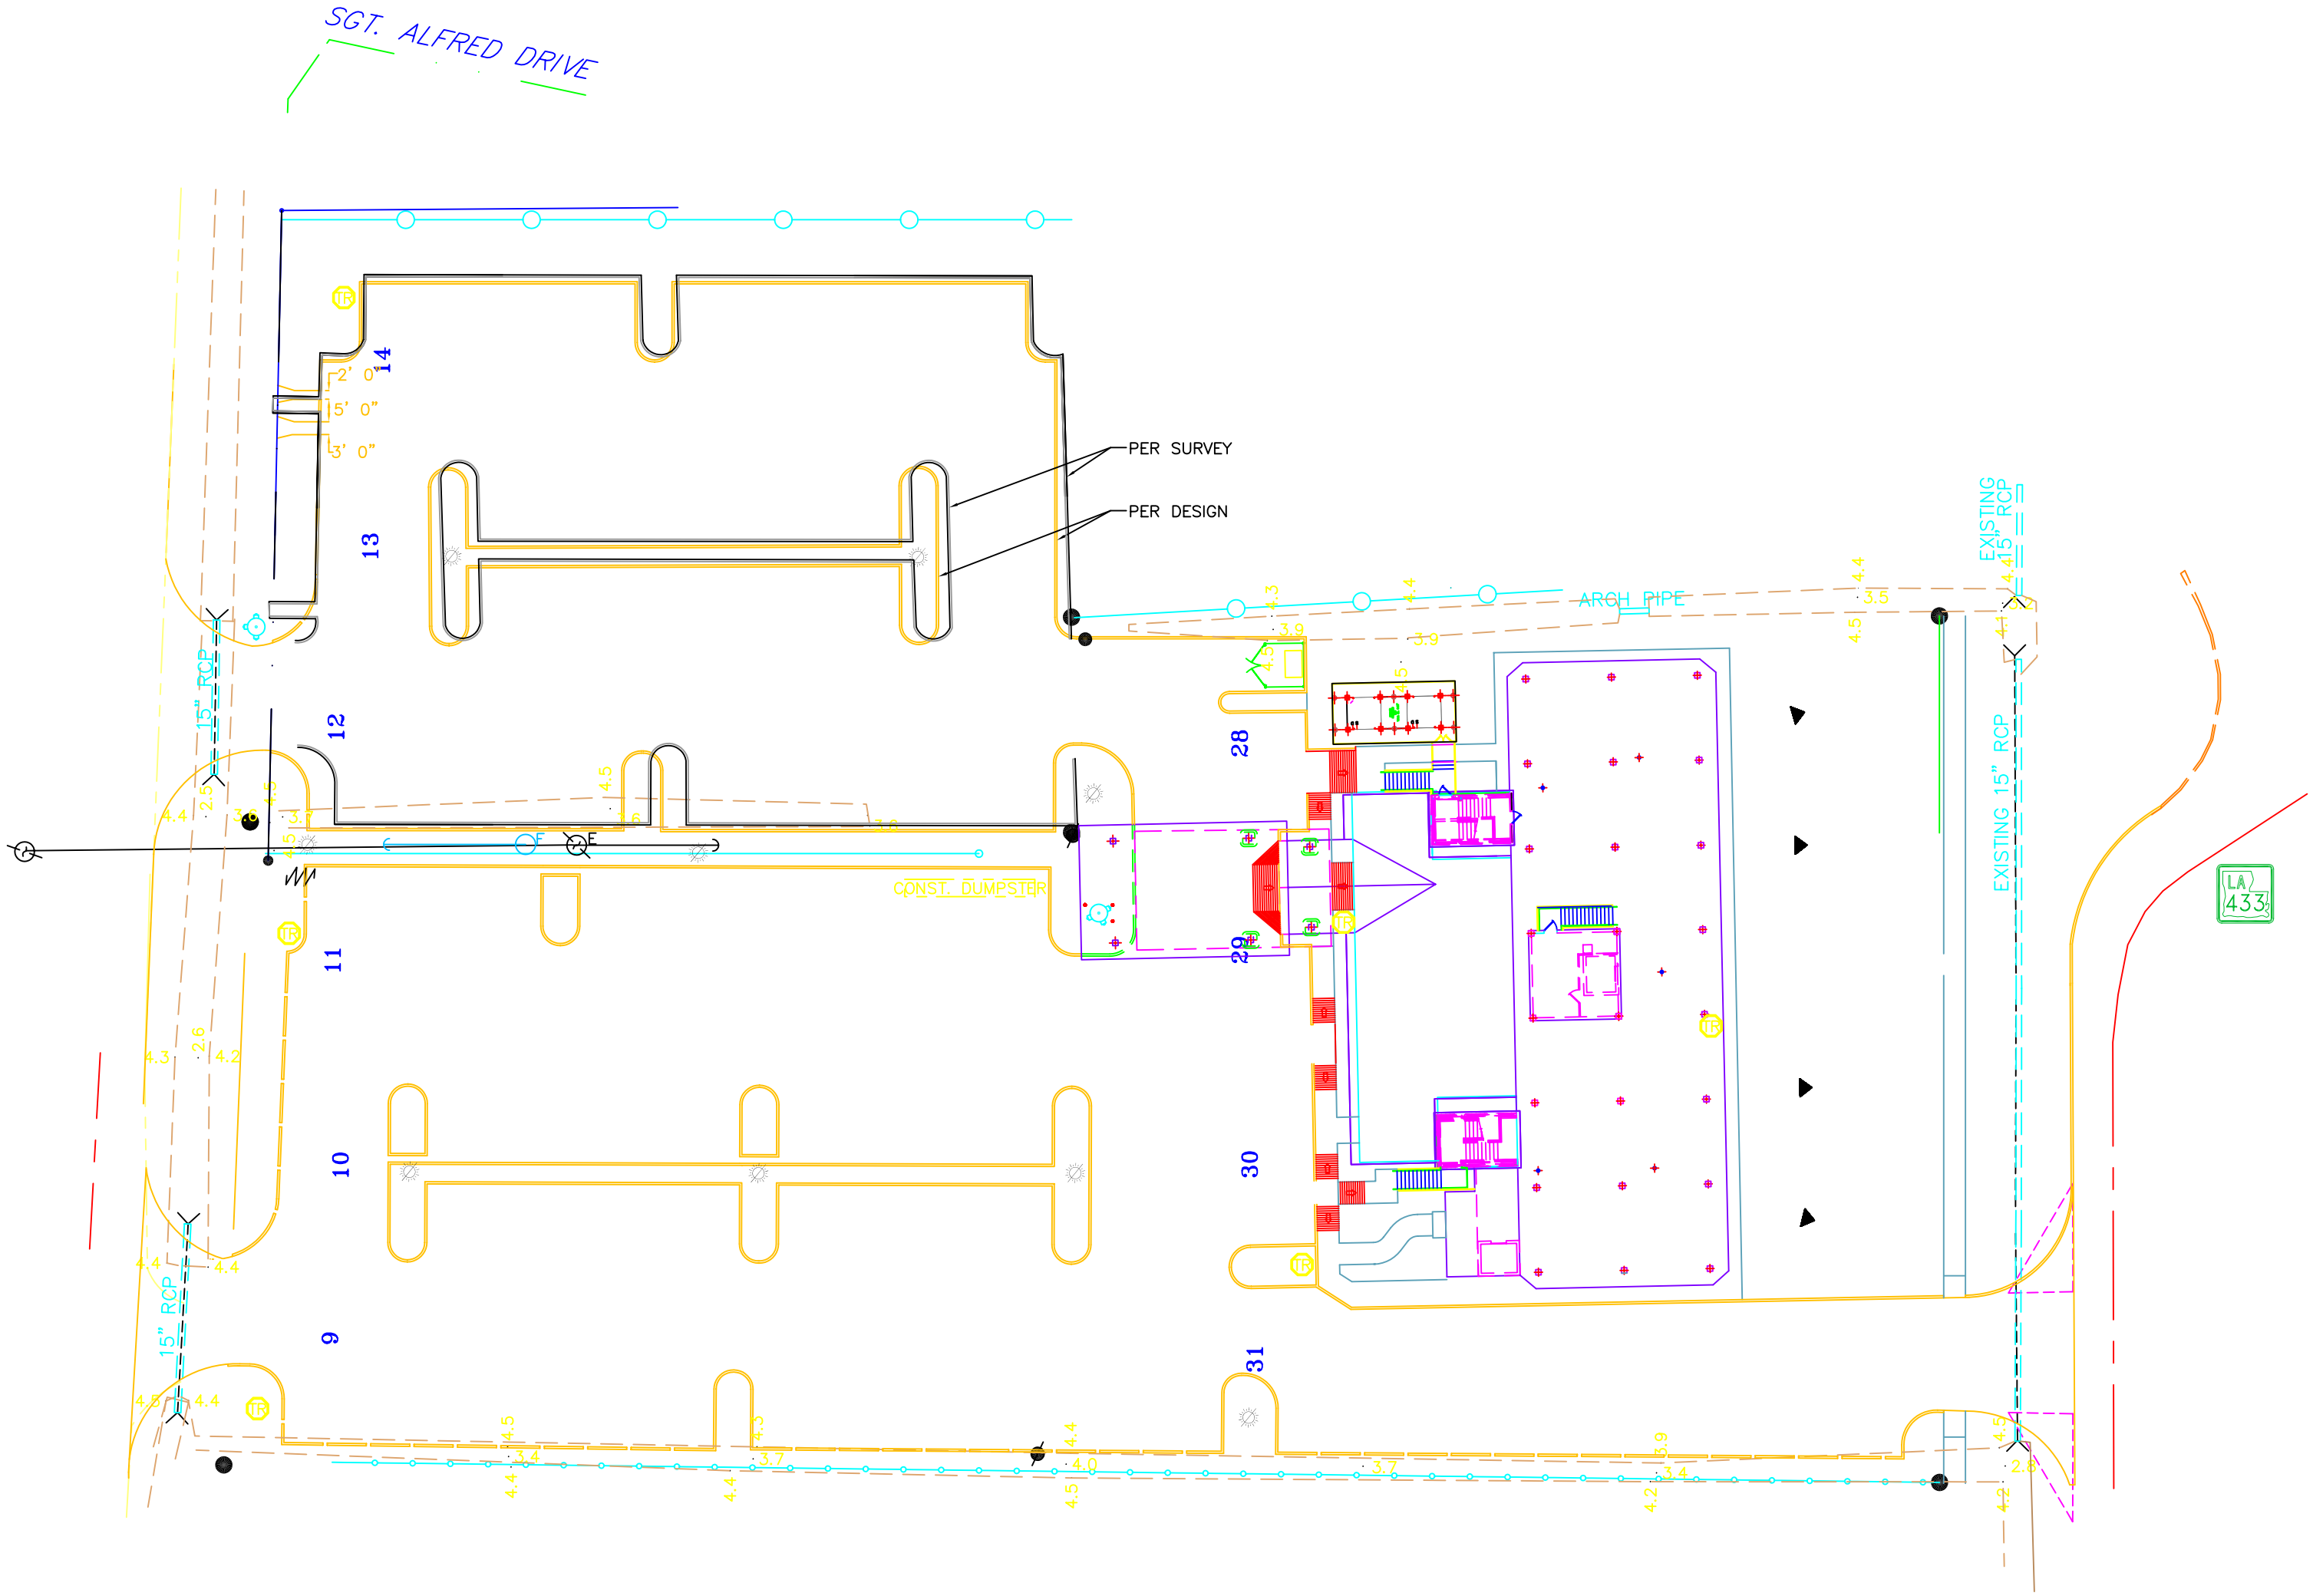
SGT. ALFRED DRIVE
PER SURVEY
PER DESIGN
ARCH PIPE
EXISTING 15" RCP
EXISTING 15" RCP
15" RCP
15" RCP
CONST. DUMPSTER
LA 433
14
13
12
11
10
9
28
29
30
31
2' 0"
5' 0"
3' 0"