


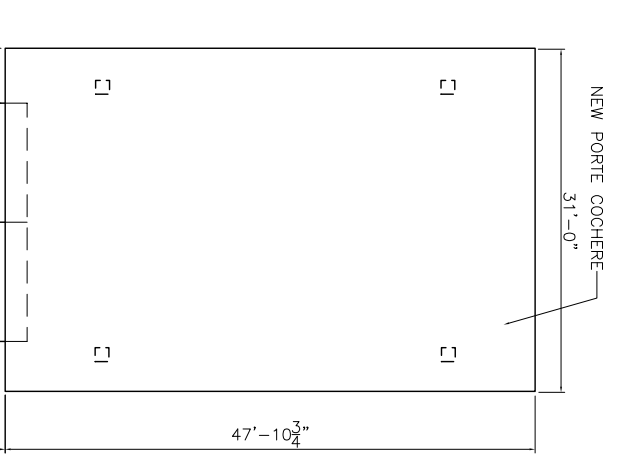




LEGEND	
NEW WALL	---
NEW FIRE RATED WALL	---
EXISTING WALL	---
CURTAIN WALL	---
SECURITY ACCESS DOOR	---
(SCANNER BY OTHERS)	---
RETURN AIR CASSED OPENING IN WALL (ROOM TO CEILING)	---
1 18" COUNTERTOP FINISHED AT 4" HIGH BY 8" WIDE SHERLOCK OPENING ABOVE	---

SECTION	
SECTION A	SCALE: 1/4" = 1'-0"
SECTION B	SCALE: 1/4" = 1'-0"
SECTION C	SCALE: 1/4" = 1'-0"

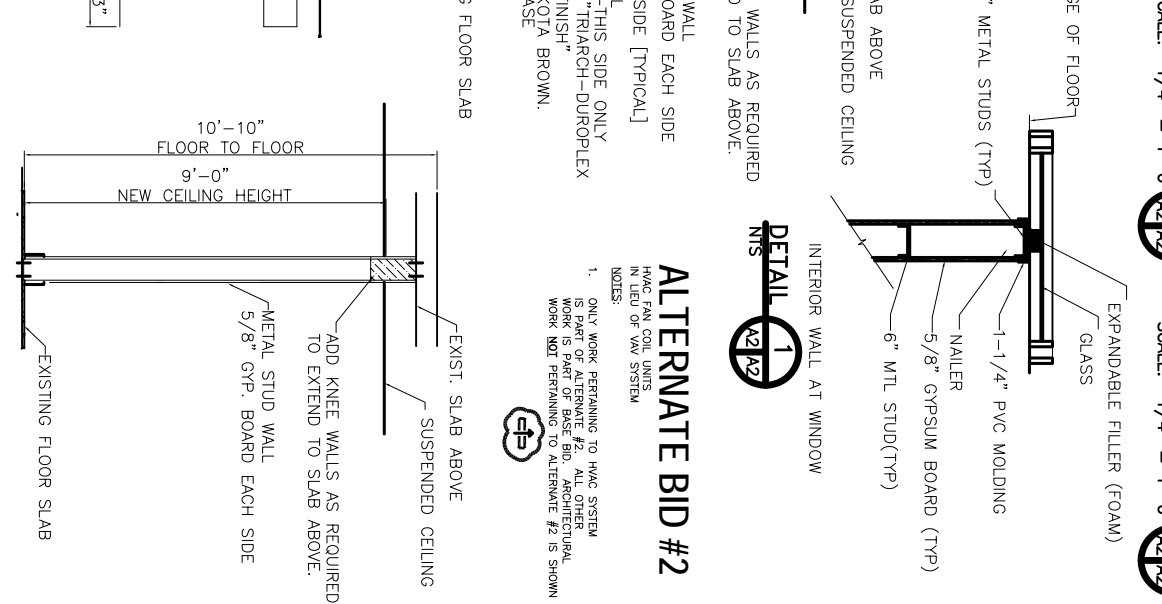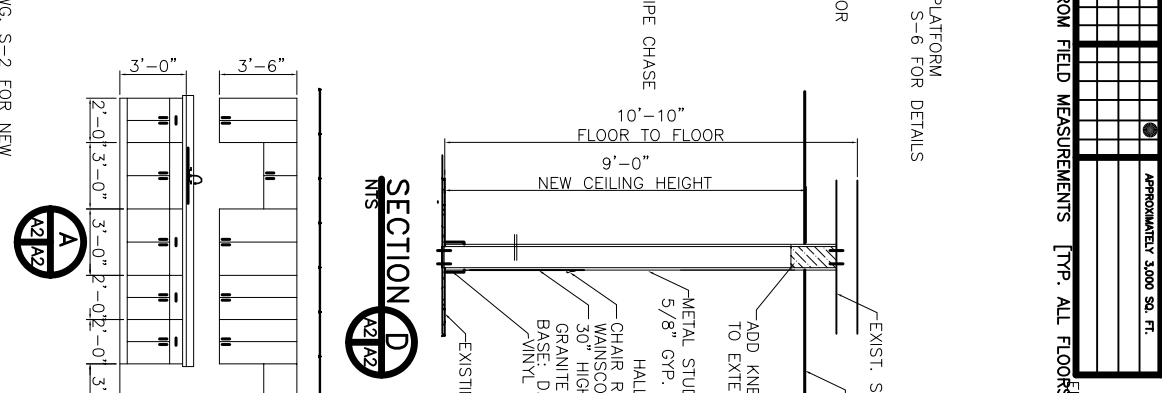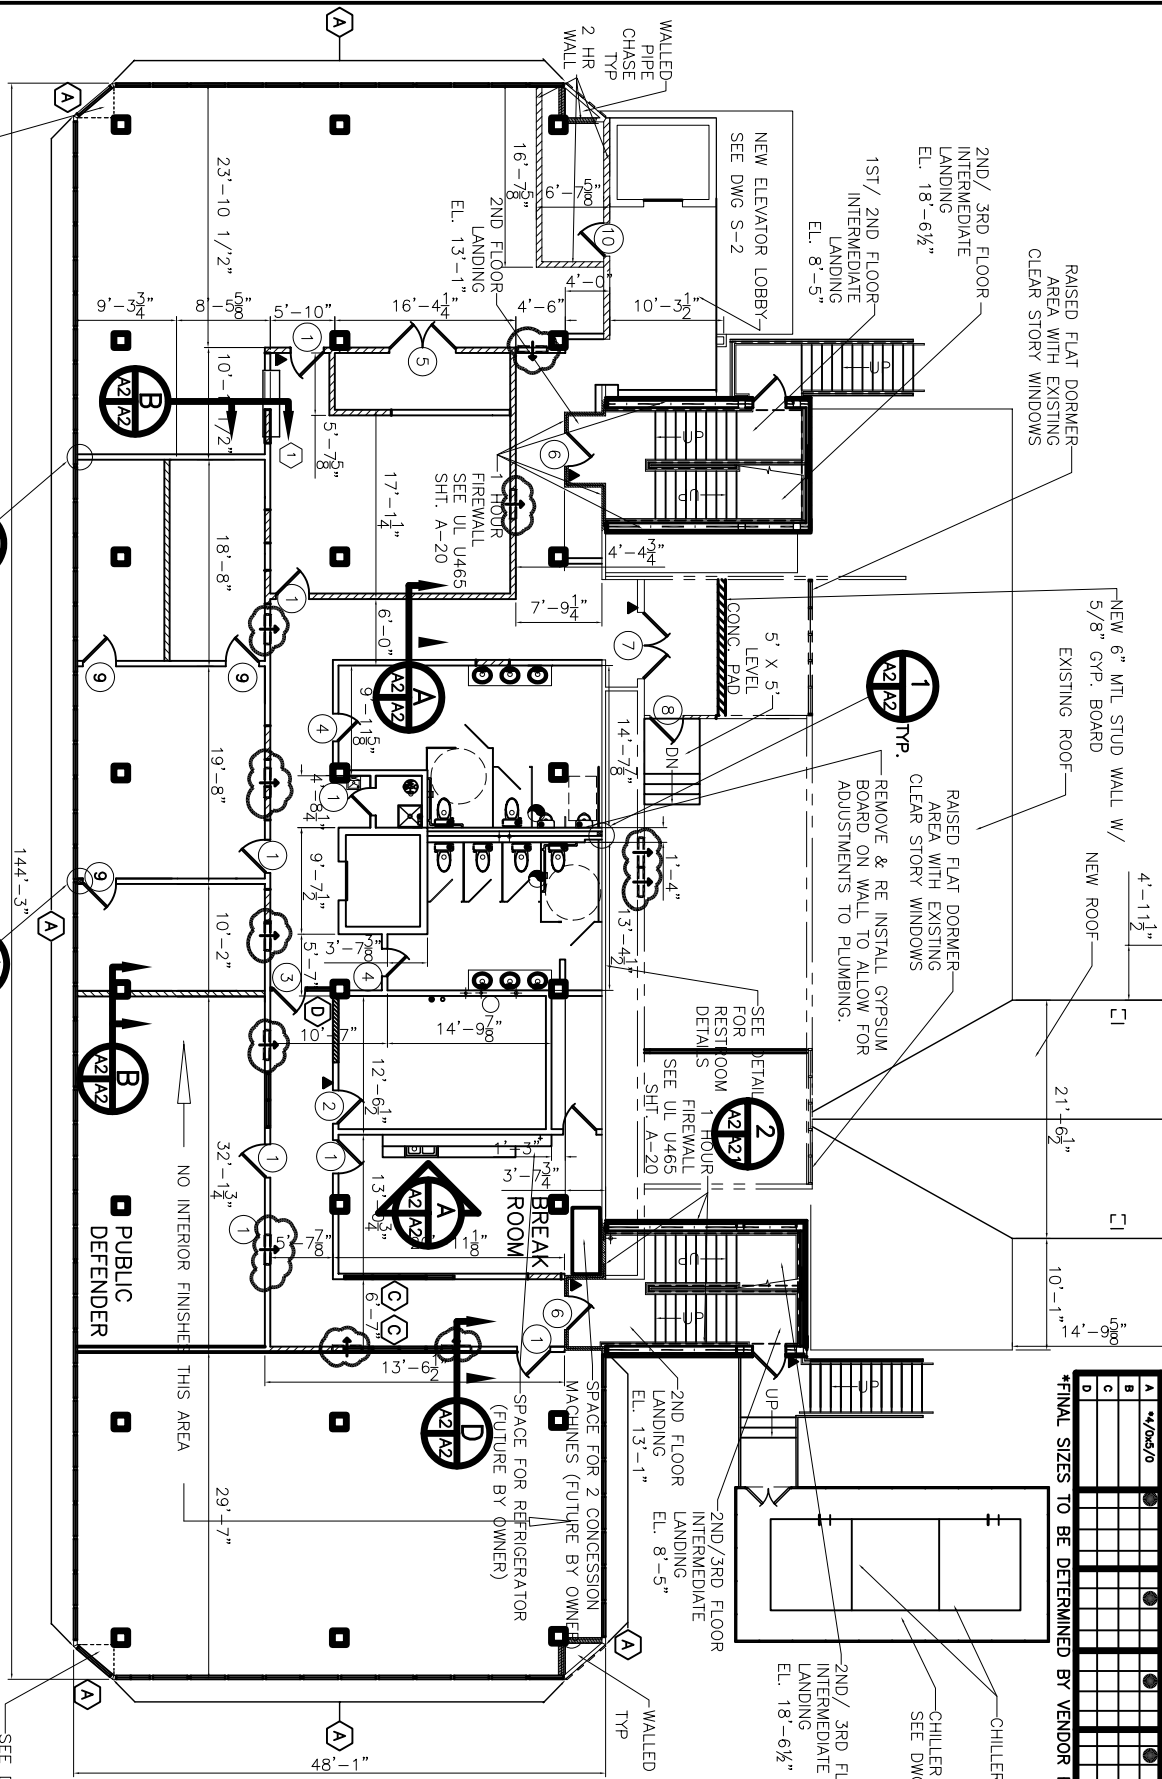

**SECOND FLOOR PLAN**  
SCALE: 1/8" = 1'-0"

REVISIONS:  
 05/17/07/ab  
 04/11/07/ab  
 03/07/07/ab  
 02/19/07  
 01/22/07

JOB NO. 1729  
DATE: 1-9-07  
SHEET A-2 OF

SCALE: AS NOTED

FILE:

RENOVATE OFFICE BUILDING

**DAMMON ENGINEERING, INC.**  
1095 FLORIDA AVENUE 985-649-5832 SLIDELL, LA. 70458  
DAMMONENGINEERING.COM

2ND FLOOR RENOVATE PLAN

ST. TAMMANY PARISH ADMIN. COMPLEX  
520 OLD SPANISH TRAIL  
SLIDELL, LOUISIANA