

FINISH SCHEDULE

ROOM	FLOOR	BASE	WALLS	CEILING	CLG HT	REMARKS
100 STORAGE	CONCRETE				12'-6" 7/8"	
101 CONFERENCE ROOM	VINYL TILE		CERAMIC TILE			CLEAN & SEAL
102 UNDER MEZZ	CARPET				9'-0"	
103 NOT USED	CERAMIC TILE				9'-0"	
104 RESTROOM	SCORED/STAINED CONCRETE				9'-0"	
105 RESTROOM	VINYL				9'-0"	
106 CLOSET	WOOD				12'-6" 7/8"	
107 NORTH LOBBY	NONE				8'-6"	GYP. ABV SUSP. CLG
108 CLOSET					12'-6" 7/8"	
109 OPEN AREA					12'-6" 7/8"	
110 CORRIDOR					9'-0"	PLASTER OVER WALLS
111 VESTIBULE					12'-6" 7/8"	
112 OPEN AREA					12'-6" 7/8"	CLEAN & SEAL
113 OPEN AREA					12'-6" 7/8"	CLEAN & SEAL
114 OPEN AREA					12'-6" 7/8"	CLEAN & SEAL
115 OPEN AREA					12'-6" 7/8"	CLEAN & SEAL
116 OPEN AREA					12'-6" 7/8"	CLEAN & SEAL
117 SOUTH LOBBY					9'-0"	
118 NORTH ENTRY #1						
119 NORTH ENTRY #2						
120 NORTH LOBBY					9'-0"	
121 NORTH ENTRY #3						
122 CLOSET					12'-6" 7/8"	CLEAN & SEAL
123 CLOSET					12'-6" 7/8"	CLEAN & SEAL
124						CLEAN WALLS & CEILING
125						CLEAN WALLS & CEILING

NOTE: SCORE ALL STAINED CONCRETE W/ 2"X2" DIAMOND PATTERN
 * STOLLER METALS OR EQUAL, AS SHOWN ON ELEV WALL PLASTER OTHER WALLS
 TEL 208-903-6095

DOOR & HARDWARE SCHEDULE

DOOR	TYPE	FRAME	HINGE	LOCK	ACCESSORIES	REMARKS
1	SOLID WOOD	ALUMINUM/CLAS	WOOD	PRIVATE	DOOR STOP	EXTERIOR
2	HOLLOW METAL	ALUMINUM	WOOD	PRIVATE	DOOR STOP	EXTERIOR
3	STOREFRONT	ALUMINUM	WOOD	PRIVATE	DOOR STOP	EXTERIOR
4	STOREFRONT	ALUMINUM	WOOD	PRIVATE	DOOR STOP	EXTERIOR
5	STOREFRONT	ALUMINUM	WOOD	PRIVATE	DOOR STOP	EXTERIOR
6	STOREFRONT	ALUMINUM	WOOD	PRIVATE	DOOR STOP	EXTERIOR
7	STOREFRONT	ALUMINUM	WOOD	PRIVATE	DOOR STOP	EXTERIOR
8	STOREFRONT	ALUMINUM	WOOD	PRIVATE	DOOR STOP	EXTERIOR
9	STOREFRONT	ALUMINUM	WOOD	PRIVATE	DOOR STOP	EXTERIOR
10	STOREFRONT	ALUMINUM	WOOD	PRIVATE	DOOR STOP	EXTERIOR
11	STOREFRONT	ALUMINUM	WOOD	PRIVATE	DOOR STOP	EXTERIOR
12	10" W/8" ROLL UP					3 HR RATED





* EQUIPPED WITH ELECTRIC STRIKE OR MAGNETIC LOCK FOR CARD READER
 * MAGNETIC HOLD OPEN
 UNDERCUT ALL DOORS 3/4" TO ALL FOR PROPER EXHAUST AIR FLOW

WINDOW SCHEDULE

WINDOW	TYPE	FRAME	GLASS	LITES	ACCESSORIES	REMARKS
BE	FIXED	ALUMINUM	W/IRGLASS	3/8"	SCREEN	STORE FRONT GLASS WALL *
CE	FIXED	ALUMINUM	W/IRGLASS	3/8"	SCREEN	STORE FRONT GLASS WALL - NEW *
A	FIXED	ALUMINUM	W/IRGLASS	3/8"	SCREEN	STORE FRONT GLASS
B	FIXED	ALUMINUM	W/IRGLASS	3/8"	SCREEN	STORE FRONT GLASS WALL *
AE	FIXED	ALUMINUM	W/IRGLASS	3/8"	SCREEN	STORE FRONT GLASS WALL *

* INSTALL ON NEW 3" TOPPING.
 * DENOTES EXISTING WINDOW (REGLAZE TO MATCH TINT)

ELEVATOR PIT NOTES:
 REMOVE ANY ELECTRICAL OUTLETS, MAKE SAFE, FILL PIT W/ SAND & COMPACT. POUR 5" CONCRETE W/ 6 MIL VISQUEEN & 6X6 0/1 MESH. INSTALL #5 REBARS MIN. 4" INTO EXISTING CONCRETE @12" O.C. AROUND OPENING. SEE DWG. S-2 FOR 2ND FLR. DET'S

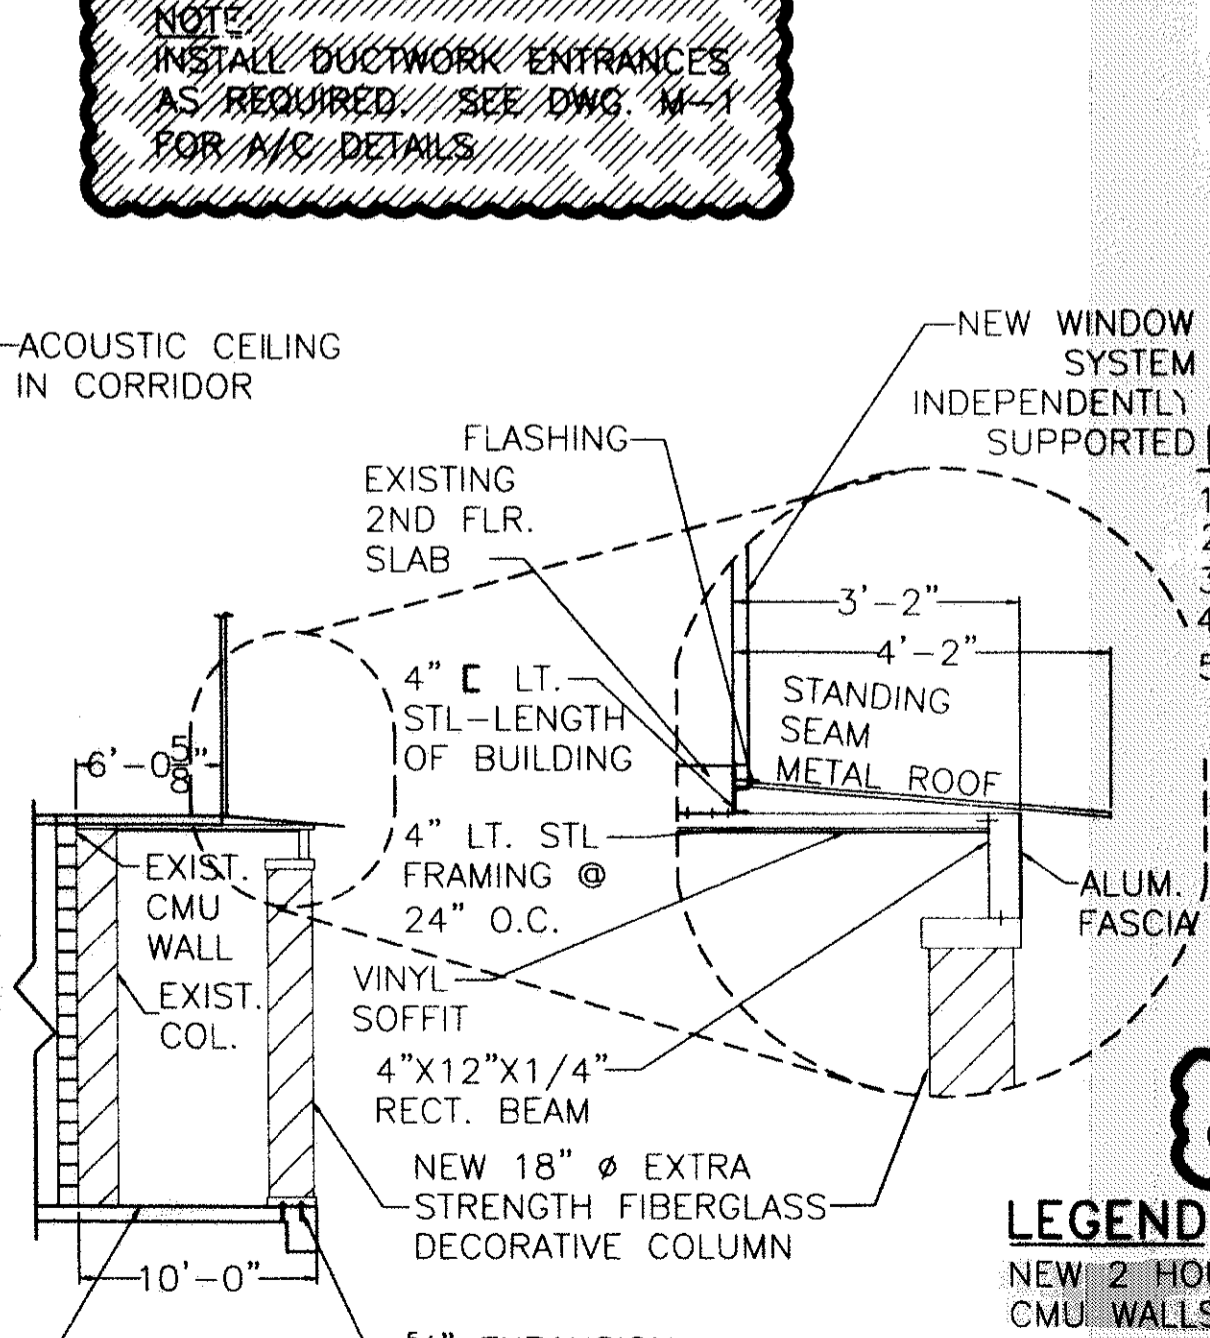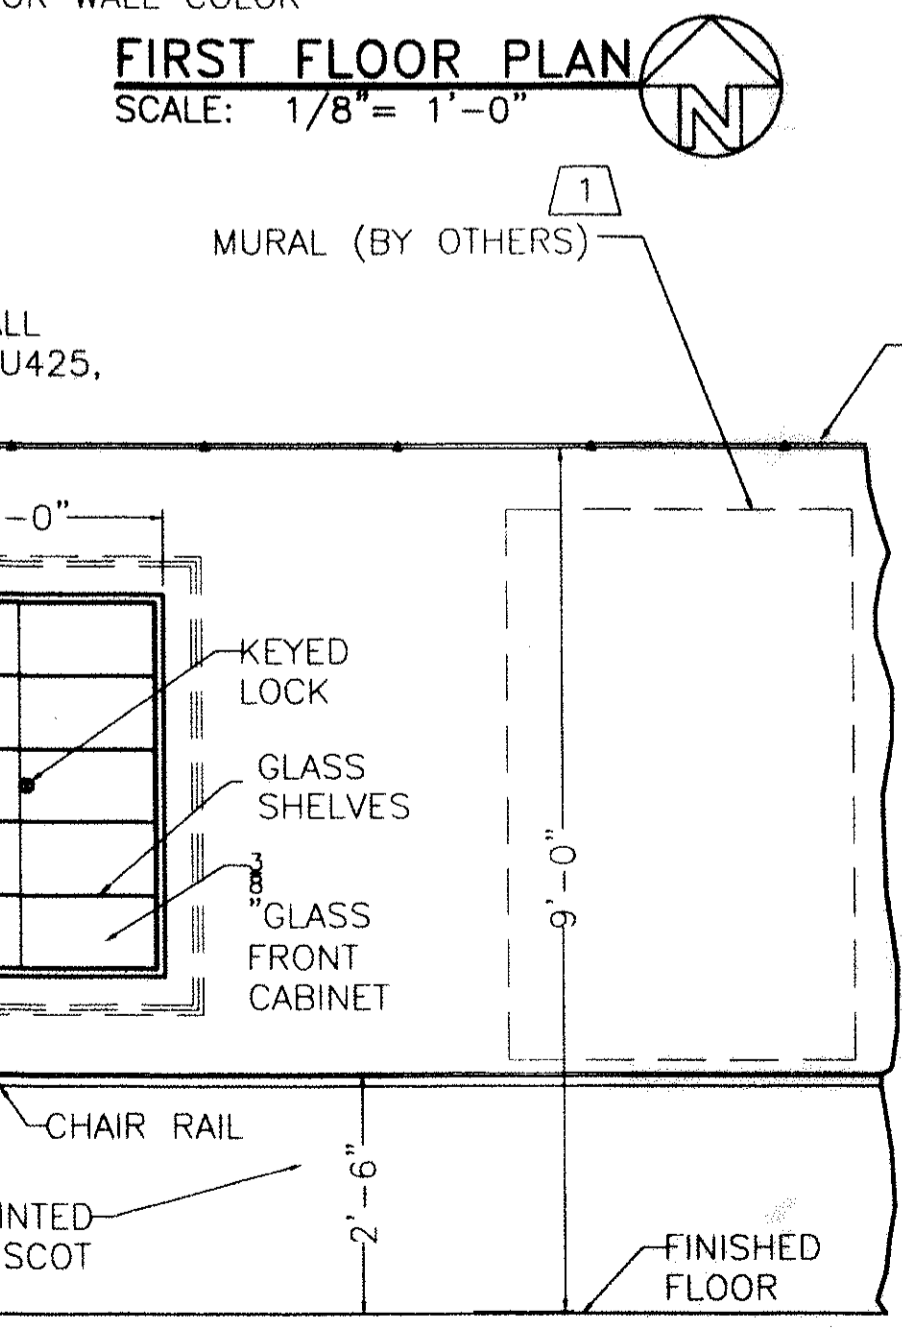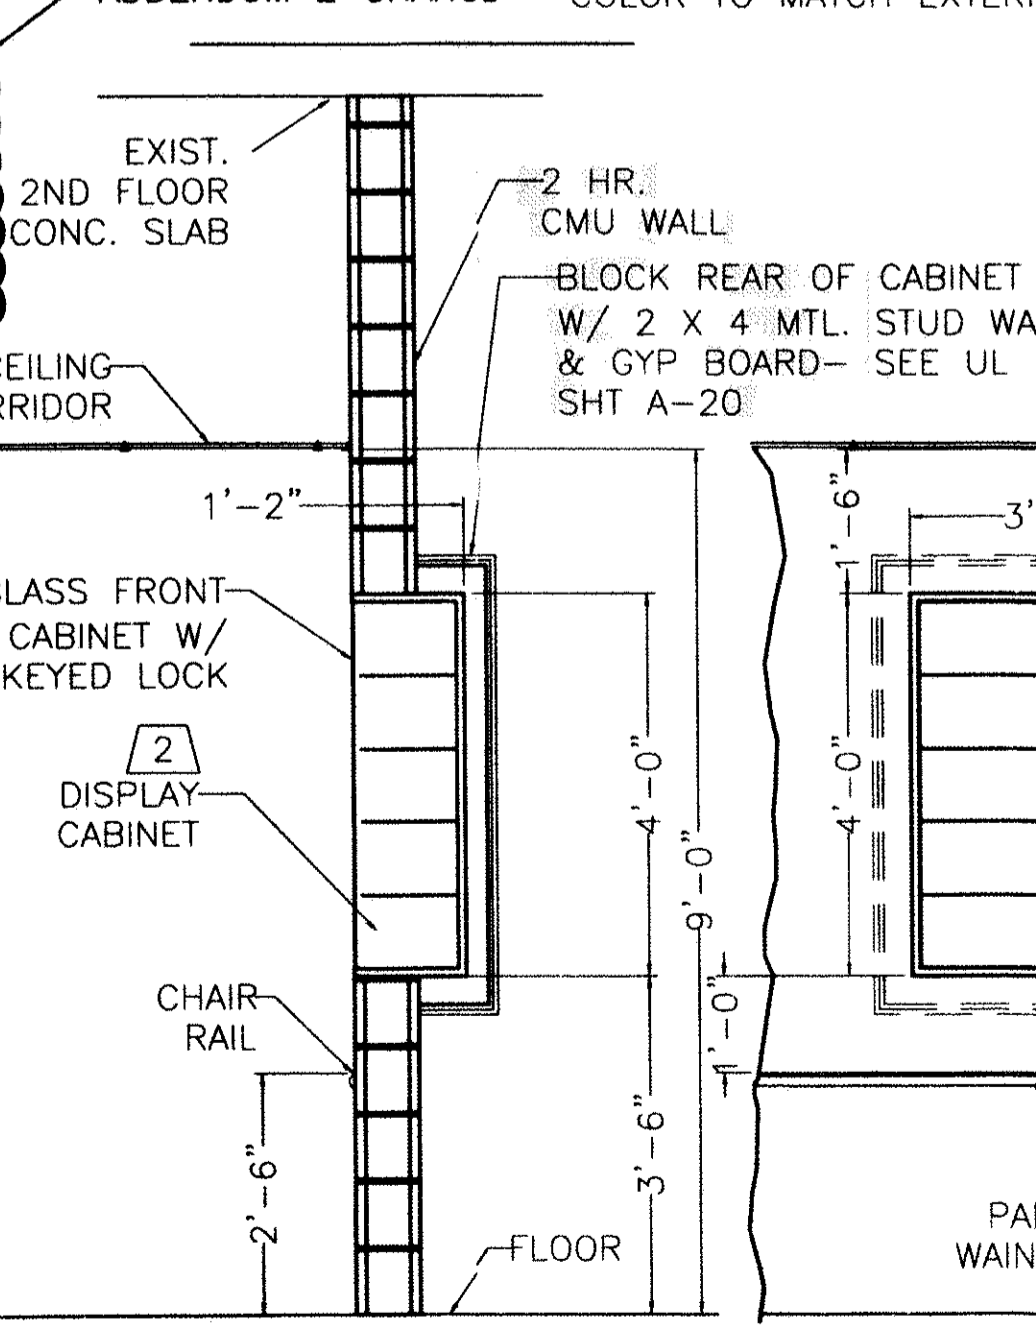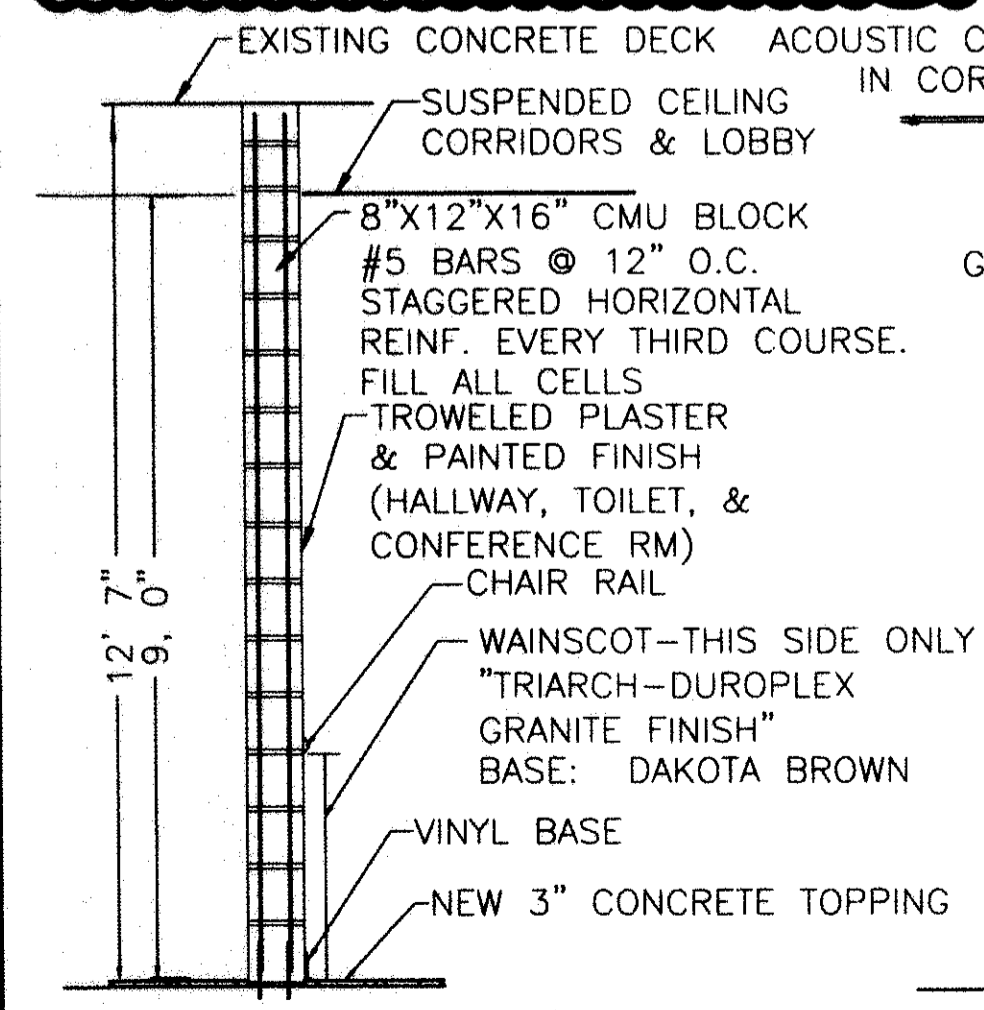

NOTES

- ALL STOREFRONT AND WINDOWS THIS LEVEL SHALL WITHSTAND WIND PRESSURES OF 43.56 PSF.
- DESIGN WIND SPEED 130 MPH THIS FLOOR.
- ALL WINDOWS AND EXTERIOR GLASS DOORS SHALL BE TINTED TO MATCH NEW WINDOW WALLS ABOVE.
- VERIFY ALL DIMENSIONS IN FIELD.
- FLOORS - MIX FOR CONCRETE FLOOR TOPPING SHALL BE 100% STRAIGHT PORTLAND CEMENT MAXIMUM GRAVEL SIZE SHALL BE 3/4". SCORE CONCRETE W/DIAMOND PATTERN (2" X 2"). STAIN SHALL BE "CHEMSTAIN CS-2 PADRE BROWN" STAIN. USE MANUFACTURERS RECOMMENDED SEALER. FOLLOW MANUFACTURERS INSTRUCTIONS FOR NONSLIP HEAVY TRAFFIC AREAS.
- ELEVATOR CONTRACTOR SHALL RELOCATE 1ST FLOOR STOPS TO ACCOUNT FOR RAISING FLOOR 3".
- KITCHEN CABINETS SHALL BE MEDIUM COMMERCIAL GRADE, FACTORY BUILT. COUNTER TOPS SHALL BE MANMADE MARBLE OR EQUAL.

LEGEND

- NEW 2 HOUR RATED CMU WALLS
- NEW CMU WALLS
- MURAL PAINTING (BY OTHERS)
- SECURITY ACCESS DOOR - (SCANNER BY OTHERS)
- ADDENDUM CHANGE
- 09/19/07 CHANGE

1ST FLOOR RENOVATE PLAN

ST. TAMMANY PARISH ADMIN. COMPLEX
 520 OLD SPANISH TRAIL
 SLIDELL, LOUISIANA

RENOVATE OFFICE BUILDING

DAMMON ENGINEERING, INC.
 1095 FLORIDA AVENUE 985-649-5652 SLIDELL, LA. 70458
 DAMMONENGINEERING.COM

SCALE: AS NOTED

FILE: [Signature]

JOB NO. 1729

DATE: 1-8-07

SHEET A-1

OF