
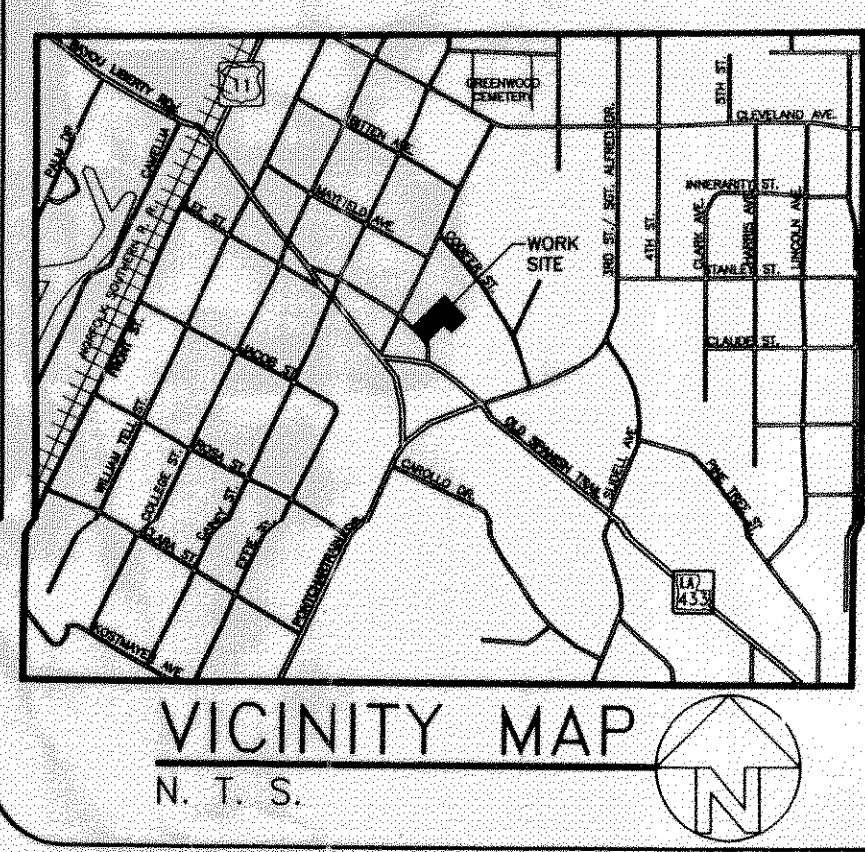


RFI 1037
RFI 13

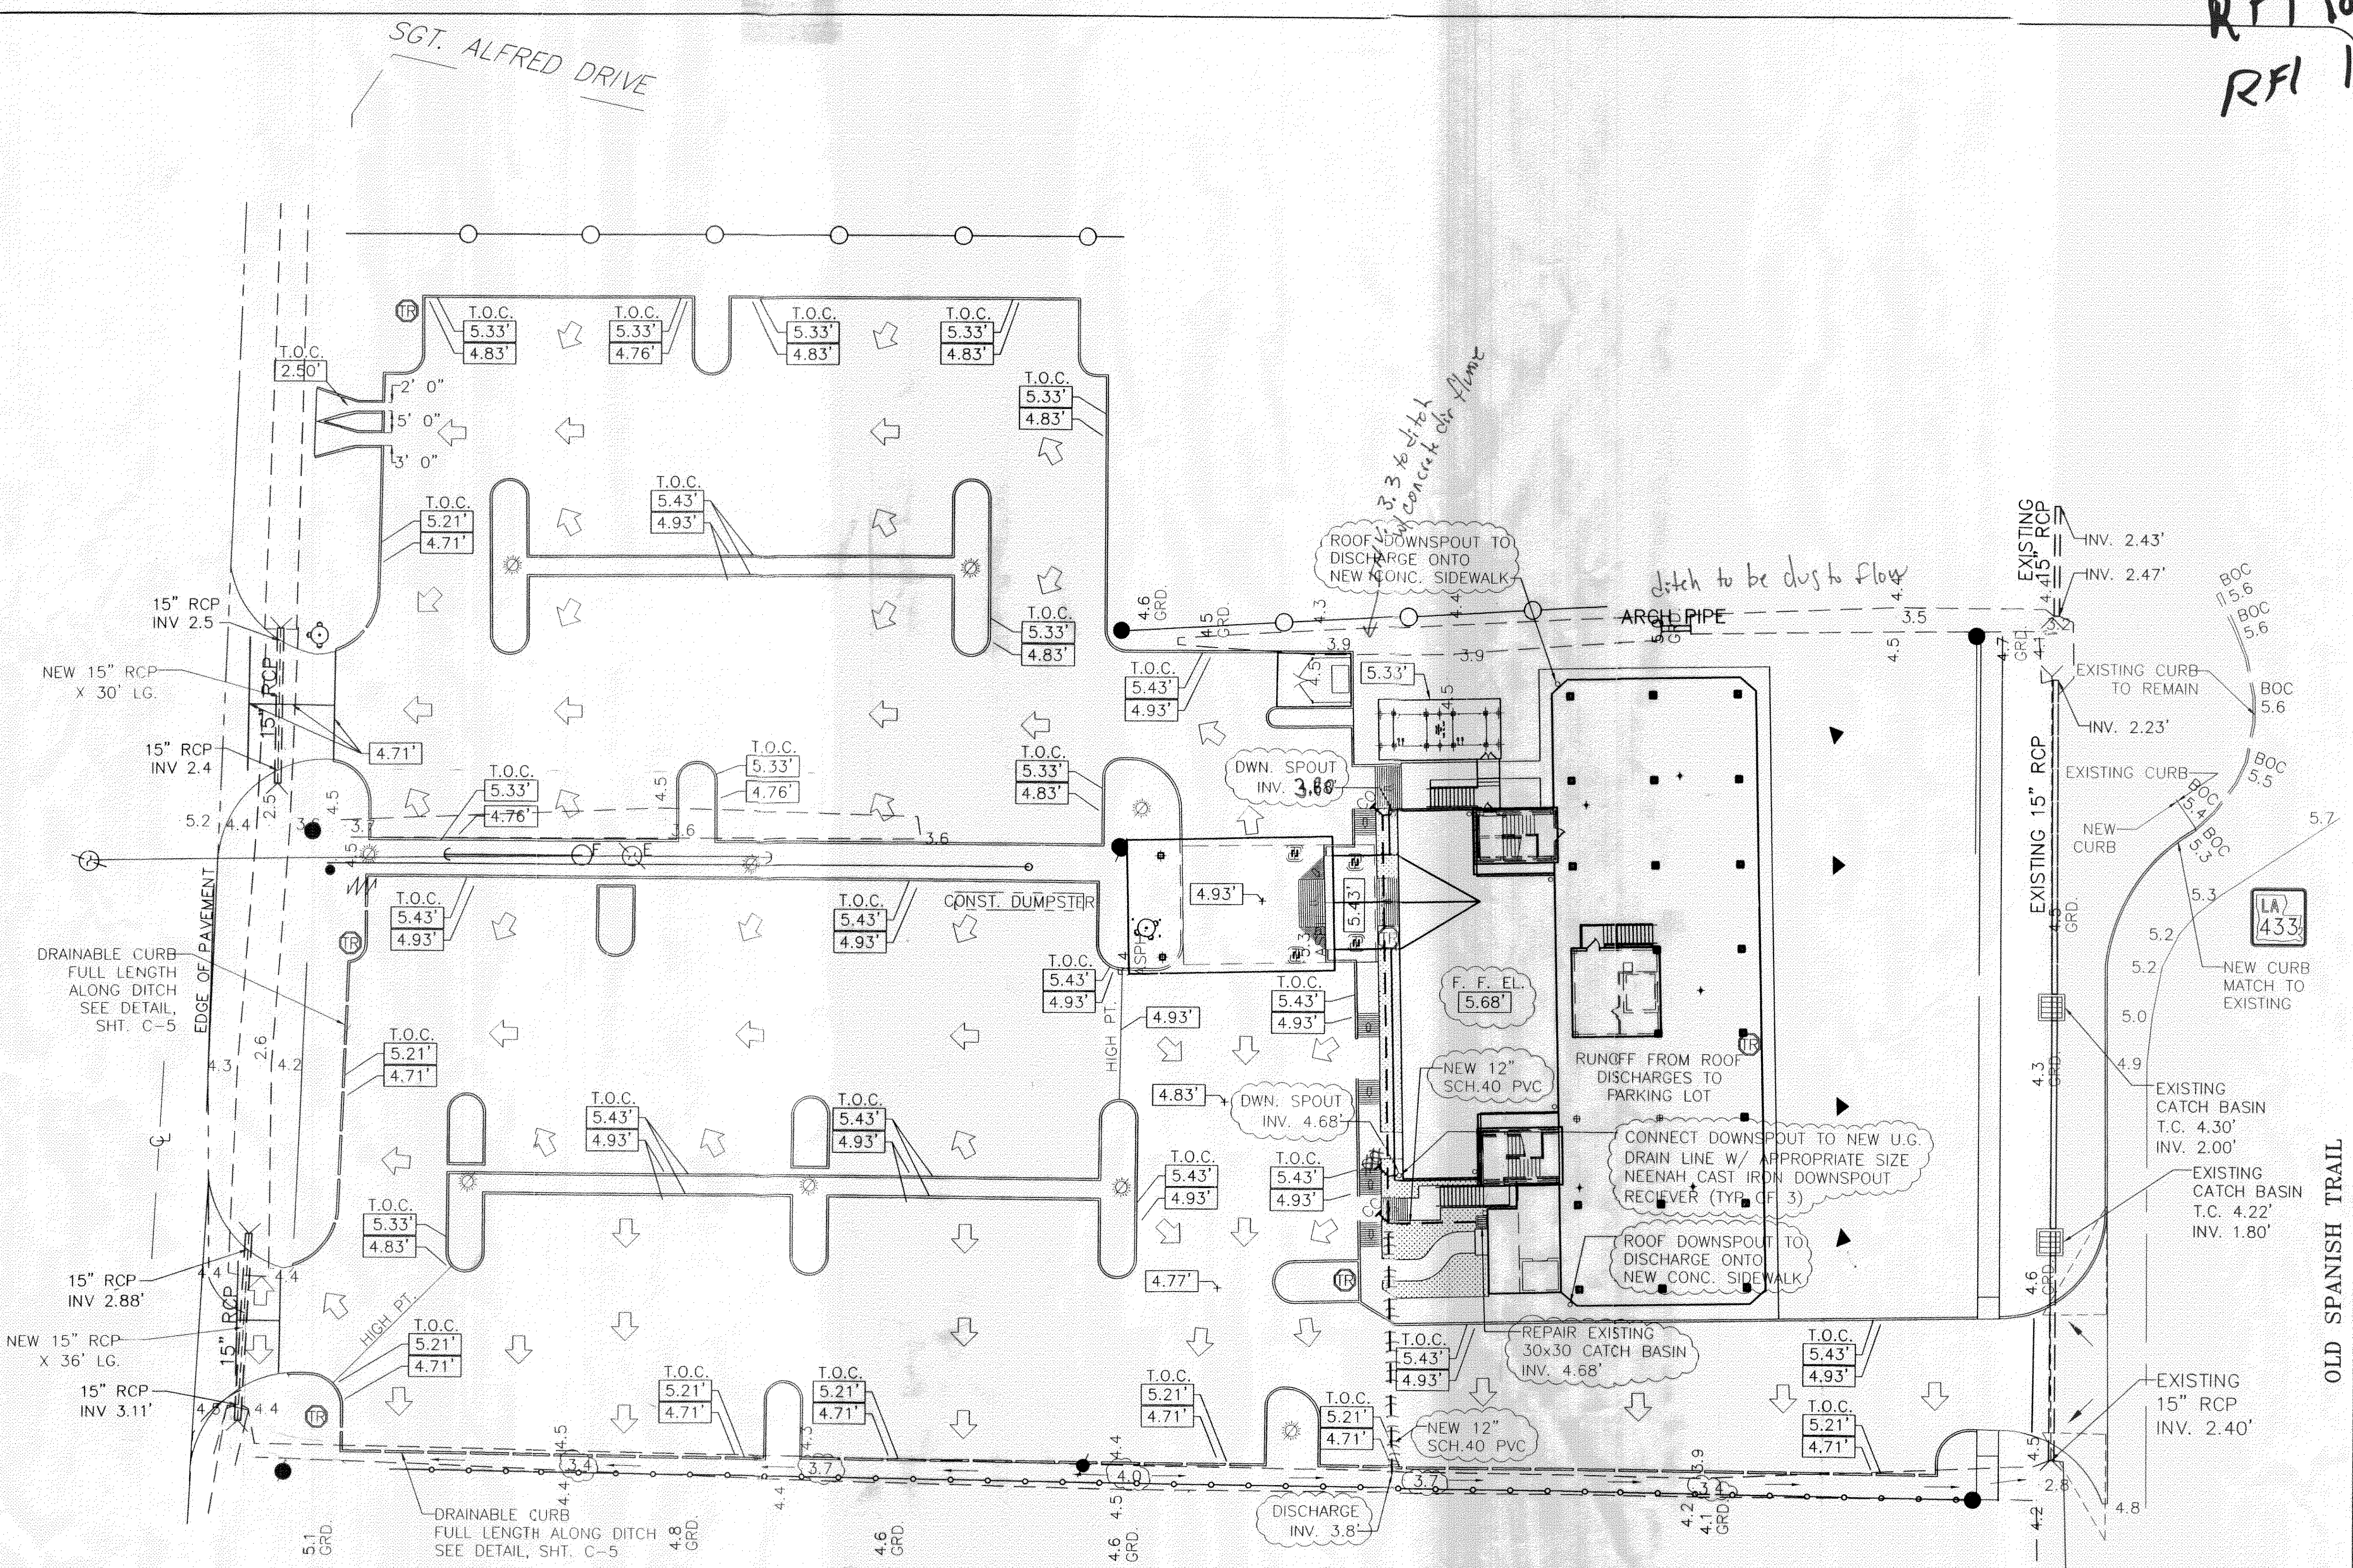

DRAINAGE PLAN

NOTE: SCALE: 1"=20'-0"
SEE DWG. C-5 FOR PAVING DETAILS.

LEGEND

- - - - - PROPERTY LINE
- - - - - SETBACK LINE
- - - - - NEW BUILDING
- - - - - NEW CURB
- T.O.C. - TOP OF CURB
- B.O.C. - BOTTOM OF CURB
- F.F. - FINISHED FLOOR
- PSF - POUNDS PER SQUARE FOOT
- [Symbol] - EXISTING CATCH BASIN
- [Symbol] - TEMPORARY SILT FENCE
- x 4.4 - EXISTING ELEVATIONS
- [Symbol] - NEW ELEVATION
- [Symbol] - DIRECTIONAL FLOW

REVISED: 6-15-10
REVISED: 03-07-07ab

CONTRACT SET- 10/10/07

DRAINAGE PLAN
ST. TAMMANY PARISH ADMIN. COMPLEX
520 OLD SPANISH TRAIL
SLIDELL, LOUISIANA

RENOVATE OFFICE BUILDING
DAMMON ENGINEERING, INC.
1095 FLORIDA AVENUE 985-649-5832 SLIDELL, LA. 70458
DAMMONENGINEERING.COM

SCALE: 1"=20'
FILE:
JOB NO. 1729
DATE: 1-12-07
SHEET
C-4
OF