


Signage Notes:

1. All signage to comply with ADA requirements to include braille, raised lettering, and symbols; color contrast; heights above finished floor; and character proportions.
2. Provide two directories per floor located near each elevator, in a visually appropriate location relative to traffic flow from entrances to elevators, and from elevator to general floor area. The directory will have a replaceable inserts by Owner and will be a slide-in paper insert from the Owner's in-house printer, with text by Owner. Directory on First Floor to have adequate spaces to list various agencies on floors above.
3. See Schedule for text of permanent signs. See example provided by Owner.
4. See Schedule for signage with replaceable inserts. See example provided by Owner. Replaceable insert will be by Owner and will be a slide-in paper insert from the Owner's in-house printer, with text by Owner. The digit on the sign will indicate the floor number. The letter on the sign will indicate the room in alphabetical order starting from the East end of the building and proceeding to the West.
5. Coordinate with requirements in Specification Section 101400 – Signage, and provide submittal for review.

Floor Number

Room letter,
East to West
sequence.

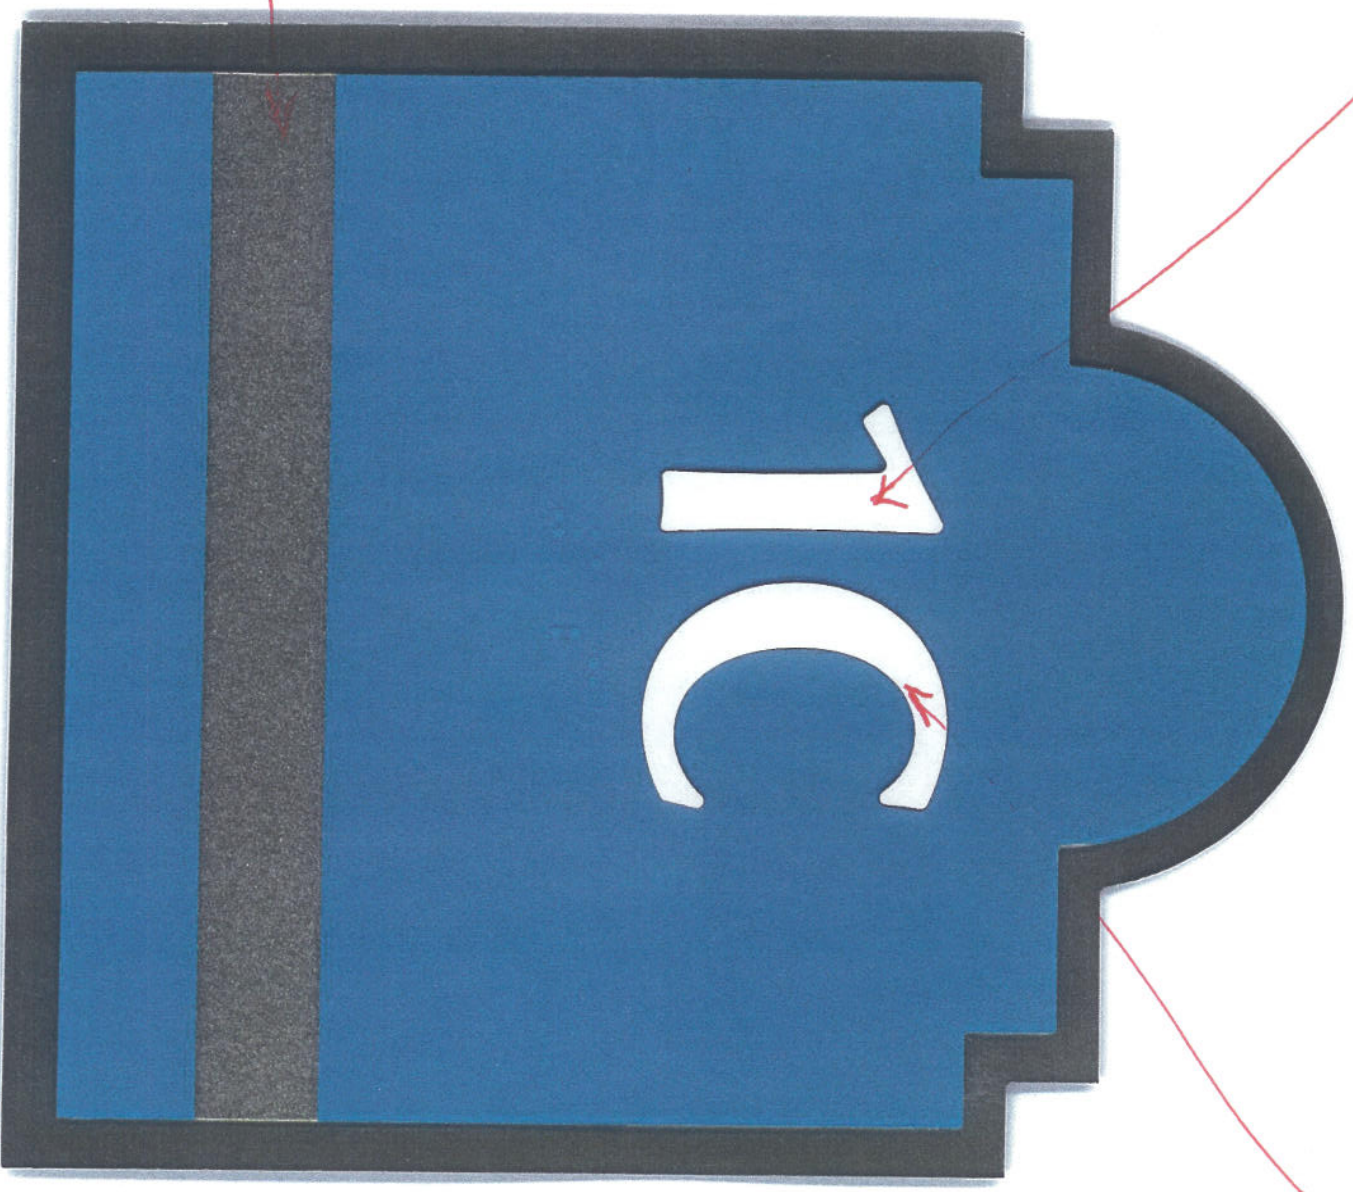

Slide-in paper insert
by Owner.

Typical Insert Sign from Owner.

MECHANICAL



ELECTRIC RM



*Typical permanent sign
from Owner.*

DIRECTORY

Slide-in paper insert by Owner.

Typical Directory Sign from Owner.

DAMMON ENGINEERING, INC.
FINISH SCHEDULE SELECTIONS

JOB TITLE: STP ADMIN. COMPLEX
 JOB ADDRESS: 520 OLD SPANISH TRAIL
 JOB NUMBER: 1729
 COUNTY/PARISH: ST. TAMMANY

CONTRACTOR: NATCO, INC. / LANDMARK CORPORATION
 CONTACT INFO: JONATHAN HORTON, PROJECT MANAGER CELL 423-341-1034
 JIM MCGUIRE, PROJECT MANAGER CELL 843-475-8783
 CONTRACT START DATE: 10-17-07
 CONTRACT END DATE: 6-24-09

FIRST FLOOR - ROOM OR AREA							FINISH		SIGNATURES	
NO.	DESCRIPTION	FLOOR	BASE	WALL	CEILING	HEIGHT	FINISH REMARKS	SIGN	TEXT, REMARKS, ETC.	
100	STORAGE	EXISTING CONC.	NONE	PTD. ARCH GRAY SW1038	PTD. ARCH GRAY SW1038	12'-6" +-		Perm.	Storage & INSERTS	
101	CONFERENCE ROOM	CONC. SCORED / STAINED	VINYL P110 BROWN	PTD. CAMEL BACK SW6122	EXISTING - SEE REMARKS	VARIES	WAINSCOT - TRIARCH - DUROPLEX GRANITE	Perm.	Conference Center (3)	
102	UNDER MEZZANINE	CONC. SCORED / STAINED	VINYL P110 BROWN	PTD. CAMEL BACK SW6122	PTD. GYP. BD. CAMEL BACK SW6122	8' +	WAINSCOT - TRIARCH - DUROPLEX GRANITE		N/A	
103	NOT USED								N/A	
104	RESTROOM - WOMENS	SPA 0148 HEX	CER. TILE	GYP. BD. PTD. SW6211 RAINWASHED	SUSP. CEILING TEGULAR	8' +	CER. TILE WAINSCOT TO BE 0148. SPA. 3'x6'; VANITY TOP - VERDE PEACOCKSINK BONE, SEE FINISH NOTE 3	Perm.	Women's	
105	RESTROOM - MENS	CYPRESS 1452 HEX	CER. TILE	GYP. BD. PTD. SW6206 OYSTER BAY	SUSP. CEILING TEGULAR	8' +	CER. TILE WAINSCOT TO BE 1452, CYPRESS, 3'x6'; VANITY TOP - VERDE PEACOCK, SEE FINISH NOTE 3	Perm.	Mens	
106	CLOSET	SEALED	NONE	PTD. ARCH GRAY SW1038	PTD. ARCH GRAY SW1038	12'-6" +-		Perm.	Storage	
107	NORTH LOBBY	CONC. SCORED / STAINED	VINYL P110 BROWN	PTD. CAMEL BACK SW6122	SUSP. CLG. TEGULAR - SEE REMARKS	8' +	WAINSCOT - TRIARCH - DUROPLEX GRANITE		N/A	
108	CLOSET	CONC. SCORED / STAINED	VINYL P110 BROWN	PTD. ARCH GRAY SW1038	PTD. ARCH GRAY SW1038	12'-6" +-	WAINSCOT - TRIARCH - DUROPLEX GRANITE	Perm.	Storage	
109	OPEN AREA						NOT USED		N/A	
110	EXIT CORRIDOR	CONC. SCORED / STAINED	VINYL P110 BROWN	PTD. CAMEL BACK SW6122	SUSP. CLG. TEGULAR - SEE REMARKS	8' +	WAINSCOT - TRIARCH - DUROPLEX GRANITE		N/A	
111	VESTIBULE	CONC. SCORED / STAINED	VINYL P110 BROWN	PTD. CAMEL BACK SW6122	SUSP. CLG. TEGULAR - SEE REMARKS	VERIFY 12'-6" +-	WAINSCOT - TRIARCH - DUROPLEX GRANITE		N/A	
112	OPEN AREA - TO BE LOCATED	CONC.	NONE	NONE	NONE	12'-6" +-	CLEAN AND SEAL CONCRETE		N/A	
113	OPEN AREA - OFFICE	CONC.	NONE	PTD. ARCH GRAY SW1038	PTD. ARCH GRAY SW1038	12'-6" +-	CLEAN AND SEAL CONCRETE		N/A	
114	OPEN AREA - TO BE LOCATED	CONC.	NONE	PTD. ARCH GRAY SW1038	PTD. ARCH GRAY SW1038	12'-6" +-	CLEAN AND SEAL CONCRETE		N/A	

SECOND FLOOR - ROOM OR AREA						FINISH		SIGNS	
NO.	DESCRIPTION	FLOOR	BASE	WALL	CEILING	HEIGHT	FINISH REMARKS	SIGN	TEXT, REMARKS, ETC.
200	ELEVATOR LOBBY / CORRIDOR	VCT 1622 W/ 1356 ACCENT 505.	VINYL P 110 BROWN	GYP. BD. PTD. CAMEL BACK 5W6122	SUSP. CLG. TEGULAR	8' +	PROVIDE CHAIR RAIL (VERIFY LOCATION) - SEE VCT PATTERN DETAIL.		N/A
201	VESTIBULE	VCT 1622 W/ 1356 ACCENT 505.	VINYL P 110 BROWN	GYP. BD. PTD. CAMEL BACK 5W6122	GYP. BD. PTD. CAMEL BACK 5W6123	8' +		Perms.	Mechanicals
202	ROOM	EXISTING CONCRETE	NONE	GYP. BD. PTD. CAMEL BACK 5W6122	EXPOSED WD. DECK	8' +			N/A
203	ROOM - NOT USED	NA	NA	NA	NA	8' +	NO FINISHES AT THIS TIME		N/A
204	ELEVATOR EQUIPMENT ROOM	EXISTING CONCRETE	VINYL P 110 BROWN	PTD. ARCH GRAY 5W1038	OPEN PTD. ARCH GRAY 5W1038	8' +	2 HR. RATED CONST.	Perms	Elevator Equipment
205	RESTROOM - MENS	CYPRESS 1452 HEX	CER. TILE	GYP. BD. PTD. 5W6206 OYSTER BAY	SUSP. CLG. TEGULAR	8' +	CER. TILE TO BE WAINSCOT 1452, CYPRESS, 3"x6"; VANITY TOP VERDE PEACOCK, SEE FINISH NOTE 3	Perms.	Mens
206	RESTROOM - WOMENS	SPA 0148 HEX	CER. TILE	GYP. BD. PTD. 5W6211 RAINWASHED	SUSP. CLG. TEGULAR	8' +	CER. TILE TO BE WAINSCOT 0148, SPA, 3"x6"; VANITY TOP VERDE PEACOCK/SINK BONE, SEE FINISH NOTE 3	Perms	Women's
207	ROOM - NOT USED	NA	NA	NA	NA	8' +	NO FINISHES AT THIS TIME		N/A
208	ROOM	NA	NA	NA	NA	8' +	NO FINISHES AT THIS TIME		N/A
209	PERMITS	VCT 1622	VINYL P 110 BROWN	GYP. BD. PTD. CAMEL BACK 5W6122	SUSP. CLG. TEGULAR	8' +		Insert	2
210	ROOM	VCT 1622	VINYL P 110 BROWN	GYP. BD. PTD. CAMEL BACK 5W6122	SUSP. CLG. TEGULAR	8' +		11	
211	ROOM	VCT 1622	VINYL P 110 BROWN	GYP. BD. PTD. CAMEL BACK 5W6122	SUSP. CLG. TEGULAR	8' +		11	
212	ROOM - JANITORS CLOSET	VCT 1622	VINYL P 110 BROWN	GYP. BD. PTD. CAMEL BACK 5W6122	SUSP. CLG. TEGULAR	8' +	W.R. GREENBOARD @ WALLS	Perms.	Janitor
213	MECHANICAL ROOM	EXISTING CONCRETE	NONE	PTD. ARCH GRAY 5W1038	OPEN PTD. ARCH GRAY 5W1038	10'-4"		Perms.	Mechanical
214	BREAK ROOM	VCT 1622	VINYL P 110 BROWN	GYP. BD. PTD. CAMEL BACK 5W6122	SUSP. CLG. TEGULAR	8' +	CABINETRY - PLANTATION CHERRY - CARAMEL SHADOW	Perms.	Break Room
215	ROOM	CARPET	VINYL	GYP. BD. PTD. CAMEL BACK 5W6122	SUSP. CLG. TEGULAR	8' +		Insert	2
216	VETERAN'S WAITING ROOM	CARPET	VINYL	GYP. BD. PTD. CAMEL BACK 5W6122	SUSP. CLG. TEGULAR	8' +		11	11
217	VETERAN'S FILE ROOM	CARPET	VINYL	GYP. BD. PTD. CAMEL BACK 5W6122	SUSP. CLG. TEGULAR	8' +		11	11
218	VETERAN'S OFFICE	CARPET	VINYL	GYP. BD. PTD. CAMEL BACK 5W6122	SUSP. CLG. TEGULAR	8' +		11	11

THIRD FLOOR - ROOM OR AREA				FINISH			SIGNS		
NO.	DESCRIPTION	FLOOR	BASE	WALL	CEILING	HEIGHT	FINISH REMARKS	SIGN	TEXT, REMARKS, ETC.
300	CORRIDOR / ELEVATOR LOBBY	VCT 1622 W/ 1356 ACCENT SQS.	VINYL P110 BROWN	GYP. BD. PTD. CAMEL BACK SWG122	SUSP. CLG. TEGULAR	8' +	PROVIDE CHAIR RAIL VERIFY LOCATION - SEE VCT PATTERN DETAIL.		N/A
301	CAA	CARPET	VINYL	GYP. BD. PTD. CAMEL BACK SWG122	SUSP. CLG. TEGULAR	8' +		Insert	3
302	CAA	CARPET	VINYL	GYP. BD. PTD. CAMEL BACK SWG122	SUSP. CLG. TEGULAR	8' +		"	"
303	CAA	CARPET	VINYL	GYP. BD. PTD. CAMEL BACK SWG122	SUSP. CLG. TEGULAR	8' +		"	"
304	CAA	CARPET	VINYL	GYP. BD. PTD. CAMEL BACK SWG122	SUSP. CLG. TEGULAR	8' +		"	"
305	MENS RESTROOM	CYPRESS 1452 HEX	CER. TILE	GYP. BD. PTD. SWG206 OYSTER BAY	SUSP. CLG. TEGULAR	8' +	CER. TILE TO BE WAINSCOT 1452. CYPRESS, 3"x6"; VANITY TOP VERDE PEACOCK, SEE FINISH NOTE 3	Perm.	Mens
306	ROOM (JANITORS CLOSET)	VCT 1622	VINYL P110 BROWN	GYP. BD. PTD. CAMEL BACK SWG122	SUSP. CLG. TEGULAR	8' +		Perm.	Janitor
307	LADIES RESTROOM	SPA 0148 HEX	CER. TILE	GYP. BD. PTD. SWG211 RAINWASHED	SUSP. CLG. TEGULAR	8' +	CER. TILE TO BE WAINSCOT 0148, SPA, 3"x6"; VANITY TOP VERDE PEACOCK/SINK BONE, SEE FINISH NOTE 3	Perm.	Wc Vocals
308	MECHANICAL ROOM	EXISTING CONCRETE	NONE	ARCH GRAY SW1038	OPEN PTD. ARCH GRAY SW1038	10'-4"		Perm.	Mechanical
309	CAA	CARPET	VINYL	GYP. BD. PTD. CAMEL BACK SWG122	SUSP. CLG. TEGULAR	8' +		Insert	3
310	DA - TOILET ROOM	CYPRESS 1452 HEX	CER. TILE	GYP. BD. PTD. OYSTER BAY SWG206	SUSP. CLG. TEGULAR	8' +	VANITY TOP TO BE VERDE PEACOCK	Perm.	Restroom
311	DA	CARPET	VINYL	GYP. BD. PTD. CAMEL BACK SWG122	SUSP. CLG. TEGULAR	8' +		Insert	3
312	DA	CARPET	VINYL	GYP. BD. PTD. CAMEL BACK SWG122	SUSP. CLG. TEGULAR	8' +		"	"
313	DRUG COURT	CARPET	VINYL	GYP. BD. PTD. CAMEL BACK SWG122	SUSP. CLG. TEGULAR	8' +		"	" 2 req.
314	DA	CARPET	VINYL	GYP. BD. PTD. CAMEL BACK SWG122	SUSP. CLG. TEGULAR	8' +		"	3
315	CORRIDOR	CARPET	VINYL	GYP. BD. PTD. CAMEL BACK SWG122	SUSP. CLG. TEGULAR	8' +		"	" 2 req.
316	DA	CARPET	VINYL	GYP. BD. PTD. CAMEL BACK SWG122	SUSP. CLG. TEGULAR	8' +		"	3
317	CAA	CARPET	VINYL	GYP. BD. PTD. CAMEL BACK SWG122	SUSP. CLG. TEGULAR	8' +		"	"
318	CORRIDOR	CARPET	VINYL	GYP. BD. PTD. CAMEL BACK SWG122	SUSP. CLG. TEGULAR	8' +		"	" 2 req.

FOURTH FLOOR - ROOM OR AREA				FINISH				SIGNS	
NO.	DESCRIPTION	FLOOR	BASE	WALL	CEILING	HEIGHT	FINISH REMARKS	SIGN	TEXT, REMARKS, ETC.
400	CORRIDOR / ELEVATOR LOBBY	VCT 1622 W/ 1356 ACCENT SQS.	VINYL P 110 BROWN	GYP. BD. PTD. CAMEL BACK SWG122	SUSP. CLG. TEGULAR	8' +	PROVIDE CHAIR RAIL VERIFY LOCATION - SEE VCT PATTERN DETAIL.		N/A
401	ARCHIVES	VCT 1622	VINYL P 110 BROWN	GYP. BD. PTD. CAMEL BACK SWG122	SUSP. CLG. TEGULAR	8' +		Insert	4
402	ARCHIVE STORE ROOM / FILE ROOM	CARPET	VINYL	GYP. BD. PTD. CAMEL BACK SWG122	SUSP. CLG. TEGULAR	8' +		"	" 2 req.
403	MENS RESTROOM	CYPRESS 1452 HEX	CER. TILE	GYP. BD. PTD. SWG206 OYSTER BAY	SUSP. CLG. TEGULAR	8' +	CER. TILE TO BE WAINSCOT 1452, CYPRESS, 3"x6"; VANITY TOP VERDE PEACOCK, SEE FINISH NOTE 3	Perm	Men's
404	LADIES RESTROOM	SFA 0148 HEX	CER. TILE	GYP. BD. PTD. SWG211 RAINWASHED	SUSP. CLG. TEGULAR	8' +	CER. TILE TO BE WAINSCOT 0148, SFA, 3"x6"; VANITY TOP VERDE PEACOCK/SINK BONE, SEE FINISH NOTE 3	Perm.	Women's
405	COMMUNICATION CLOSET	VCT 1622	VINYL P 110 BROWN	GYP. BD. PTD. CAMEL BACK SWG122	SUSP. CLG. TEGULAR	8' +		Perm	Communication Closet
406	ASSESSOR	CARPET	VINYL	GYP. BD. PTD. CAMEL BACK SWG122	SUSP. CLG. TEGULAR	8' +		Insert	4
407	ASSESSOR	CARPET	VINYL	GYP. BD. PTD. CAMEL BACK SWG122	SUSP. CLG. TEGULAR	8' +		"	4
408	JANITORS CLOSET	VCT 1622	VINYL P 110 BROWN	GYP. BD. PTD. CAMEL BACK SWG122	SUSP. CLG. TEGULAR	8' +		Perm.	Janitor
409	MECHANICAL ROOM	EXISTING CONCRETE	NONE	GYP. BD. PTD. ARCH GRAY SW1038	OPEN PTD. ARCH GRAY SW1038	10'-4"		Perm.	Mechanicals
410	ASSESSOR	CARPET	VINYL	GYP. BD. PTD. CAMEL BACK SWG122	SUSP. CLG. TEGULAR	8' +		Insert	4
411	ARCHIVES	CARPET	VINYL	GYP. BD. PTD. CAMEL BACK SWG122	SUSP. CLG. TEGULAR	8' +		"	"
412	ARCHIVES	CARPET	VINYL	GYP. BD. PTD. CAMEL BACK SWG122	SUSP. CLG. TEGULAR	8' +		"	" 2 req.
413	ROV	CARPET	VINYL	GYP. BD. PTD. CAMEL BACK SWG122	SUSP. CLG. TEGULAR	8' +		"	4
414	REGISTRAR OF VOTERS	CARPET	VINYL	GYP. BD. PTD. CAMEL BACK SWG122	SUSP. CLG. TEGULAR	8' +		"	"
415	ROV	CARPET	VINYL	GYP. BD. PTD. CAMEL BACK SWG122	SUSP. CLG. TEGULAR	8' +		"	" 2 req.
416	ASSESSOR	CARPET	VINYL	GYP. BD. PTD. CAMEL BACK SWG122	SUSP. CLG. TEGULAR	8' +		"	" 11
417	ASSESSOR	CARPET	VINYL	GYP. BD. PTD. CAMEL BACK SWG122	SUSP. CLG. TEGULAR	8' +		Insert	4

FIFTH FLOOR - ROOM OR AREA				FINISH				SIGNS	
NO.	DESCRIPTION	FLOOR	BASE	WALL	CEILING	HEIGHT	FINISH REMARKS	SIGN	TEXT, REMARKS, ETC.
500	CORRIDOR / ELEVATOR LOBBY	VCT 1622 w/ 1356 ACCENT 505.	VINYL P110 BROWN	GYP. BD. PTD. CAMEL BACK SW6122	SUSP. CLG. TEGULAR	8' +	PROVIDE CHAIR RAIL VERIFY LOCATION - SEE VCT PATTERN DETAIL.		N/A
501	CLERK OF COURT	CARPET	VINYL	GYP. BD. PTD. CAMEL BACK SW6122	SUSP. CLG. TEGULAR	8' +		Insert.	5 — 2 req.
502	COC BREAK ROOM	VCT 1622	VINYL P110 BROWN	GYP. BD. PTD. CAMEL BACK SW6122	SUSP. CLG. TEGULAR	8' +	CABINETRY - PLANTATION CHERRY - CAMEL SHADOW	Perm.	Break Room
503	MEN'S RESTROOM	CYPRESS 1452 HEX	CER. TILE	GYP. BD. PTD. SW6206 OYSTER BAY	SUSP. CLG. TEGULAR	8' +	CER. TILE TO BE WAISSCOT 1452, CYPRESS, 3"x6"; VANITY TOP VERDE PEACOCK. SEE FINISH NOTE 3	Perm.	Men's
504	LADIES RESTROOM	SPA 0148 HEX	CER. TILE	GYP. BD. PTD. SW6211 RAINWASHED	SUSP. CLG. TEGULAR	8' +	CER. TILE TO BE WAISSCOT 1452, CYPRESS, 3"x6"; VANITY TOP VERDE PEACOCK. SEE FINISH NOTE 3	Perm.	Women's
505	COC DATA	CARPET	VINYL	GYP. BD. PTD. CAMEL BACK SW6122	SUSP. CLG. TEGULAR	8' +		Insert	5 —
506	COUNCIL OFFICE	CARPET	VINYL	GYP. BD. PTD. CAMEL BACK SW6122	SUSP. CLG. TEGULAR	8' +		u	u 2req.
507	COC	VCT 1622	VINYL P110 BROWN	GYP. BD. PTD. CAMEL BACK SW6122	SUSP. CLG. TEGULAR	8' +		Insert	5 —
508	COC	CARPET	VINYL	GYP. BD. PTD. CAMEL BACK SW6122	SUSP. CLG. TEGULAR	8' +		u	u 2req.
509	MECHANICAL ROOM	EXISTING CONCRETE	NONE	GYP. BD. PTD. ARCH GRAY SW1038	OPEN PTD. ARCH GRAY SW1038	10'-6"		Perm.	Mechanical
510	COUNCIL CHAMBERS	CARPET	VINYL	GYP. BD. PTD. CAMEL BACK SW6122	SUSP. CLG. TEGULAR	8' +		Perm.	Council Council Chambers 2req.
511	MARRIAGE LICENSES	CARPET	VINYL	GYP. BD. PTD. CAMEL BACK SW6122	SUSP. CLG. TEGULAR	8' +		Insert	5 — 2req.
512	COUNCIL OFFICE	CARPET	VINYL	GYP. BD. PTD. CAMEL BACK SW6122	SUSP. CLG. TEGULAR	8' +		Insert	5 —
513	JANITORS CLOSET	VCT 1622	VINYL P110 BROWN	GYP. BD. PTD. CAMEL BACK SW6122	SUSP. CLG. TEGULAR	8' +		Perm.	Janitor
514	COC STORES	VCT 1622	VINYL P110 BROWN	GYP. BD. PTD. CAMEL BACK SW6122	SUSP. CLG. TEGULAR	8' +		Insert.	5 —

SIXTH FLOOR - ROOM OR AREA		FINISH							SIGNS	
NO.	DESCRIPTION	FLOOR	BASE	WALL	CEILING	HEIGHT	FINISH REMARKS	SIGN	TEXT, REMARKS, ETC.	
600	CORRIDOR / ELEVATOR LOBBY	VCT 1622 W/ 1356 ACCENT 505.	VINYL P 110 BROWN	GYP. BD. PTD. CAMEL BACK SW6122	SUSP. CLG. TEGULAR	8' +	PROVIDE CHAIR RAIL - SEE VCT PATTERN DETAIL.		N/A	
601	ROOM	NA	NA	NA	NA	8' +	NO FINISHES AT THIS TIME	Perm.	Authorized Personnel Only	
602	ROOM	NA	NA	NA	NA	8' +	NO FINISHES AT THIS TIME	u	u	
603	MEN'S RESTROOM	CYPRESS 1452 HEX	CER. TILE	GYP. BD. PTD. SW6206 OYSTER BAY	SUSP. CLG. TEGULAR	8' +	CER. TILE TO BE WAINSCOT 1452, CYPRESS, 3"x6"; VANITY TOP VERDE PEACOCK. SEE FINISH NOTE 3	Perm.	Men's	
604	LADIES RESTROOM	SPA 0148 HEX	CER. TILE	GYP. BD. PTD. SW6211 RAINWASHED	SUSP. CLG. TEGULAR	8' +	CER. TILE TO BE WAINSCOT 1452, CYPRESS, 3"x6"; VANITY TOP VERDE PEACOCK. SEE FINISH NOTE 3	Perm.	Women's	
605	ROOM	VCT 1622	NONE	GYP. BD. PTD. CAMEL BACK SW6122	OPEN PTD. CAMEL BACK SW6122	8' +		Perm.	Authorized Personnel Only	
606	ROOM (KITCHEN/BREAK RM)	20"x20" CERAMIC TILE COLISEUM ATHENS	WOOD 6" SEE FIN. NOTE 8	GYP. BD. PTD. ARCH GRAY SW1038	SUSP. CLG. TEGULAR	8' +	SEE FINISH NOTE 1 & 5. 36" HIGH BASE CABINETS PLANTATION CHERRY - CAMEL SHADOW, COUNTER NEW VENETIAN GOLD AT KITCHEN COUNTER HEIGHT. SEE FIN. NOTE #7.	Insert	6	
607	JANITOR	EXISTING CONCRETE	NONE	GYP. BD. PTD. ARCH GRAY SW1038	GYP. BD. PTD. OPEN ARCH GRAY SW1038	10'-6"		Perm.	Janitor	
608	ROOM	NA	NA	NA	NA	8' +	NO FINISHES AT THIS TIME	Perm.	Authorized Personnel Only	
609	MECHANICAL ROOM	EXISTING CONCRETE	NONE	GYP. BD. PTD. ARCH GRAY SW1038	OPEN PTD. ARCH GRAY SW1038	10'-6"		Perm.	Mechanical	
610	ROOM (SECRETARY)	WOOD SEE FINISH NOTE 4	WOOD 6" SEE FIN. NOTE 5	GYP. BD. PTD. SW6122 TRIM SW6119	SUSP. CLG. TEGULAR	8' +	SEE FINISH NOTE 6 & 7.	Insert	6	
611	ROOM	NA	NA	NA	NA	8' +	NO FINISHES AT THIS TIME	Perm.	Authorized Personnel Only 3 req.	
612	ROOM	WOOD SEE FINISH NOTE 4	WOOD 6" SEE FIN. NOTE 5	GYP. BD. PTD. ARCH GRAY SW1038	SUSP. CLG. TEGULAR	8' +	SEE FINISH NOTE 6 & 7.		N/A	
613	ROOM (K.D. OFFICE)	WOOD SEE FINISH NOTE 4	WOOD 6" SEE FIN. NOTE 6	GYP. BD. PTD. SW6122 SEE FINISH NOTE 6	SUSP. CLG. TEGULAR SEE REMARKS	8' +	CONTR. TOP SHALL BE NEW VENETIAN GOLD @ CONTR. HGT., CABINETS PLANTATION CHERRY - CAMEL SHADOW, DOORS DARKER STAIN. SEE FINISH NOTE 6 & 7.		N/A	
614	RESTROOM	20"x20" CERAMIC TILE COLISEUM ATHENS	WOOD 6" SEE FIN. NOTE 7	GYP. BD. PTD. SW6122 TRIM SW6119	SUSP. CLG. TEGULAR SEE REMARKS	8' +	CONTR. TOP SHALL BE NEW VENETIAN GOLD @ CONTR. HGT., CABINETS PLANTATION CHERRY - CAMEL SHADOW, MEDICAL CAB. SURFACE INTD. SEE FINISH NOTE 6 & 7.		N/A	
615	RESTROOM	20"x20" CERAMIC TILE COLISEUM ATHENS	WOOD 6" SEE FIN. NOTE 8	GYP. BD. PTD. SW6122 TRIM SW6119	SUSP. CLG. TEGULAR SEE REMARKS	8' +	CONTR. TOP SHALL BE NEW VENETIAN GOLD @ CONTR. HGT., CABINETS PLANTATION CHERRY - CAMEL SHADOW, MEDICAL CAB. SURFACE INTD. SEE FINISH NOTE 6 & 7.		N/A	
	EAST STAIRWELL WEST STAIRWELL	CONC.	NONE	PTD. ARCH GRAY SW1038	SUSP. CLG. TEGULAR SEE REMARKS	SLOPES			N/A	
	PENT HOUSE	CONC.	NONE	PTD. ARCH GRAY SW1038	SUSP. CLG. TEGULAR SEE REMARKS		CLEAN & PAINT	Perm.	Authorized Personnel Only	