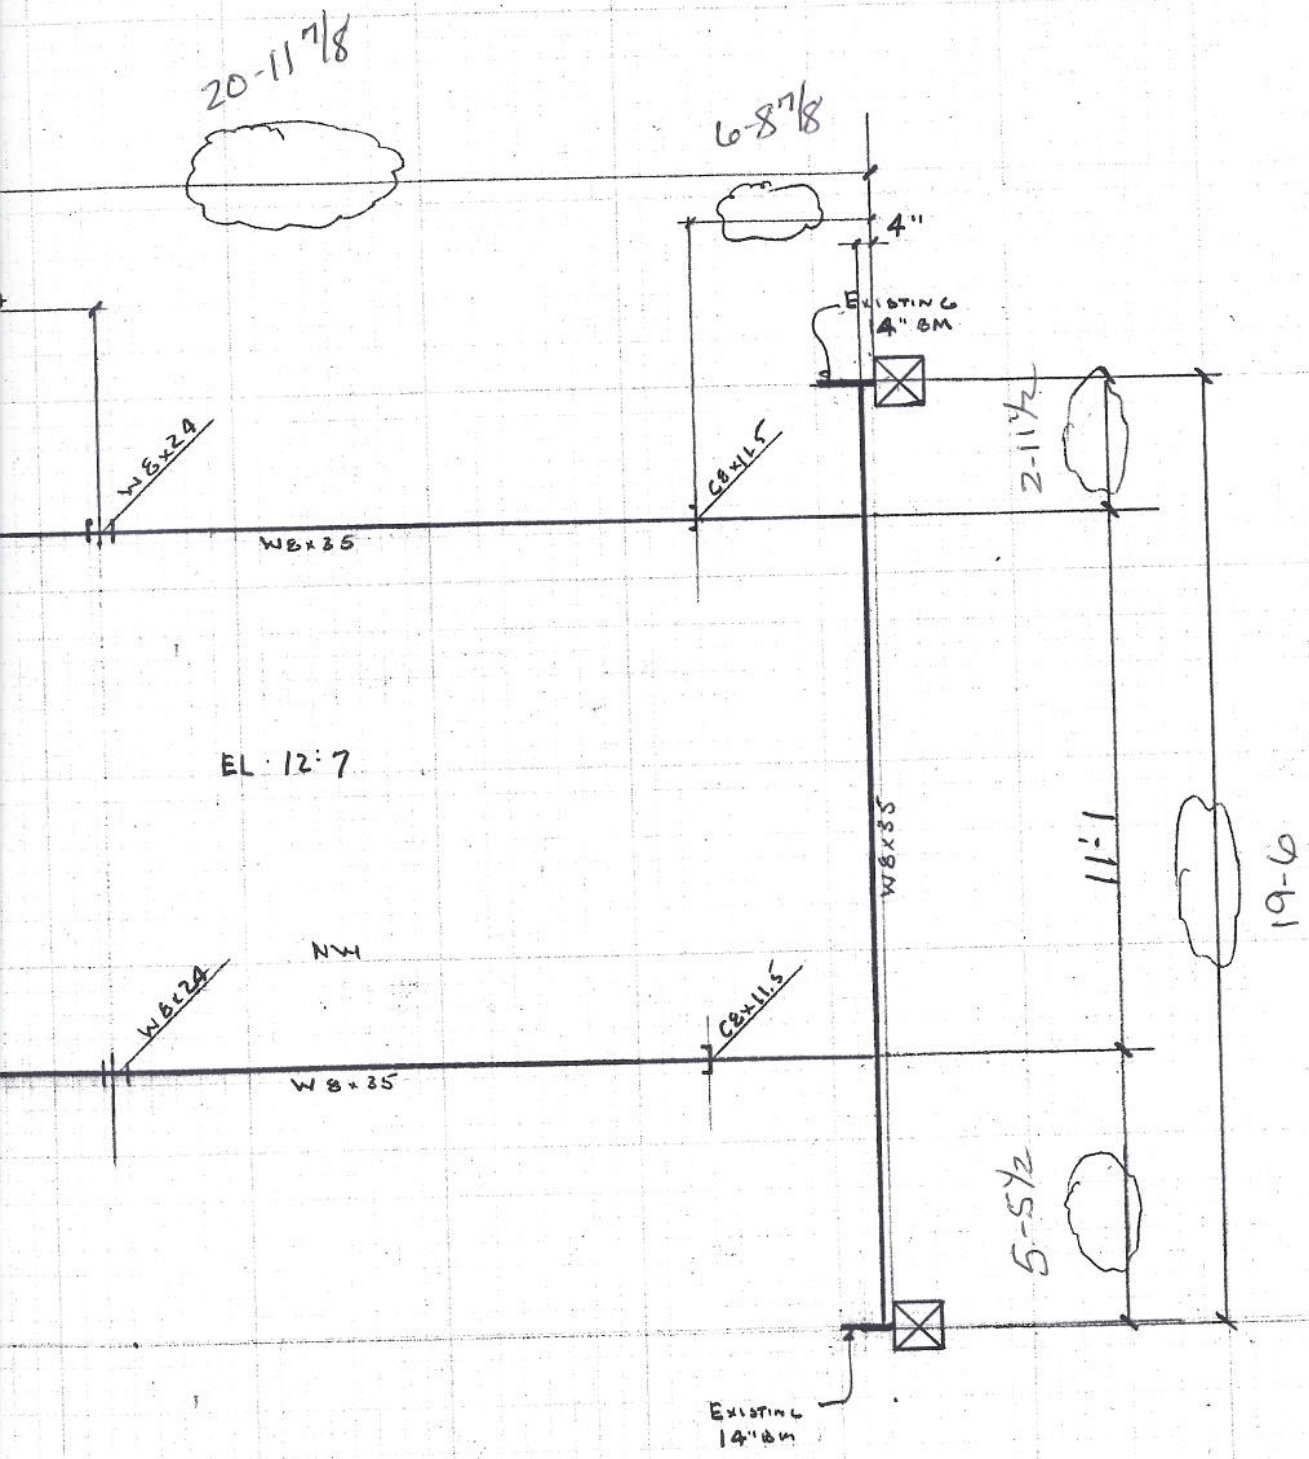

NORTH WEST STAIR