



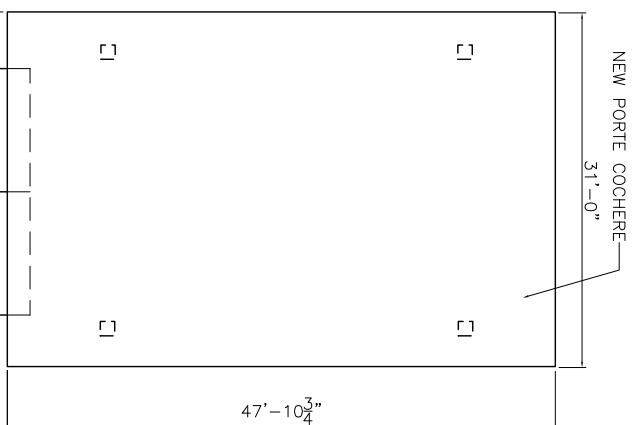



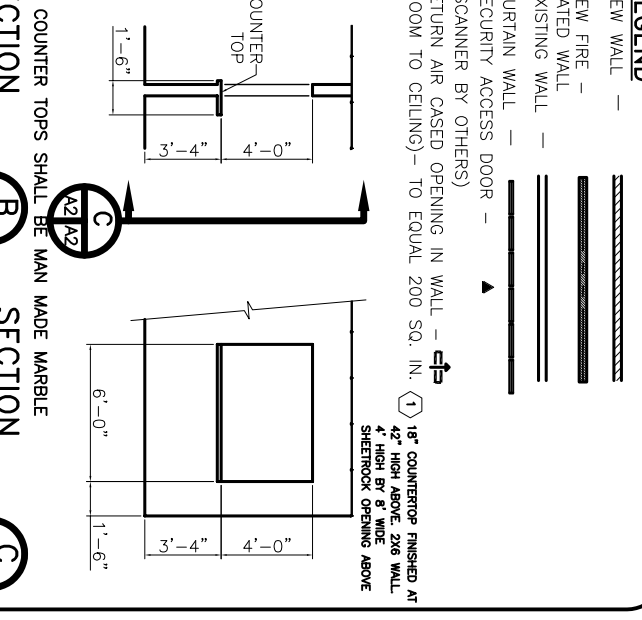



LEGEND	



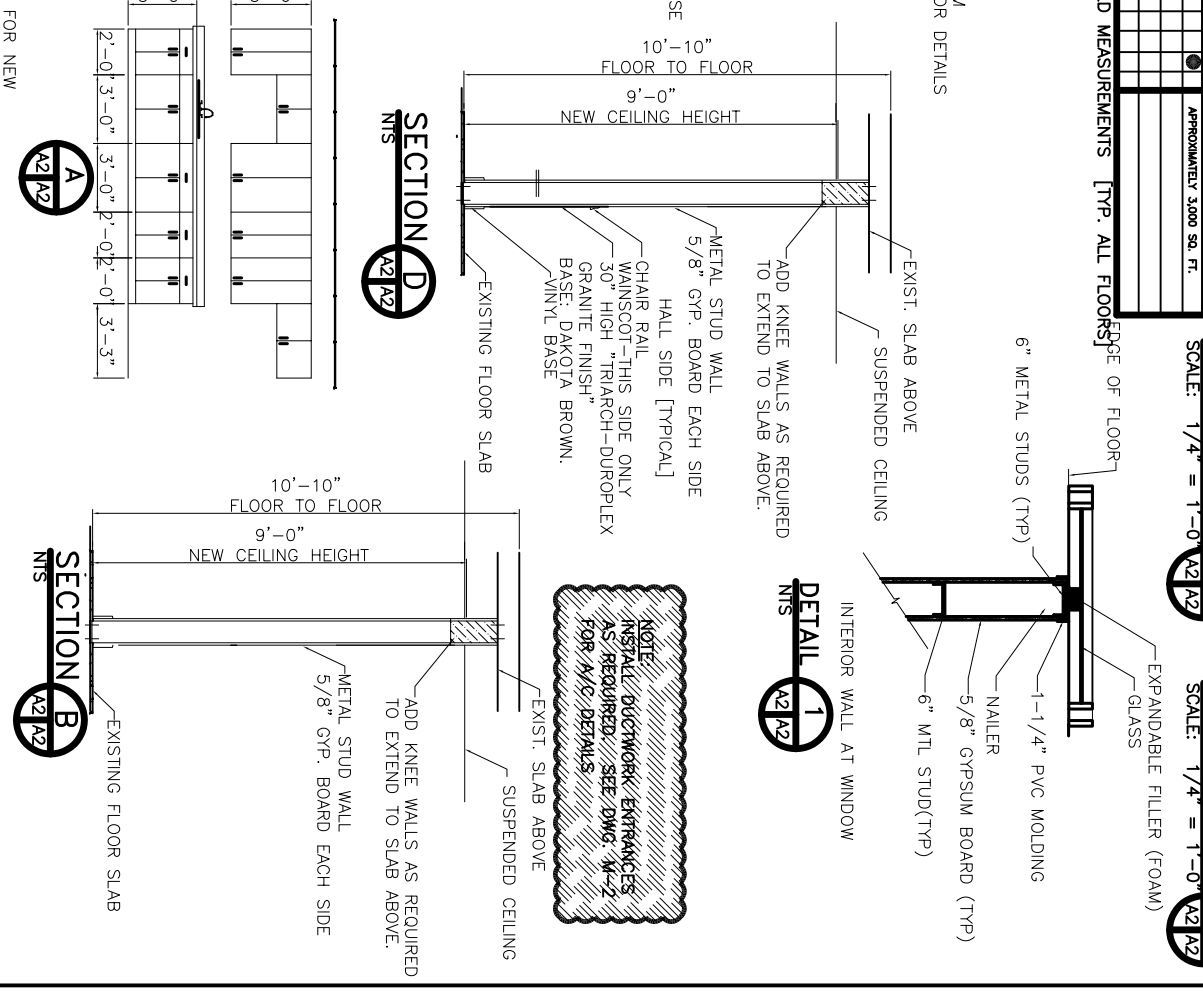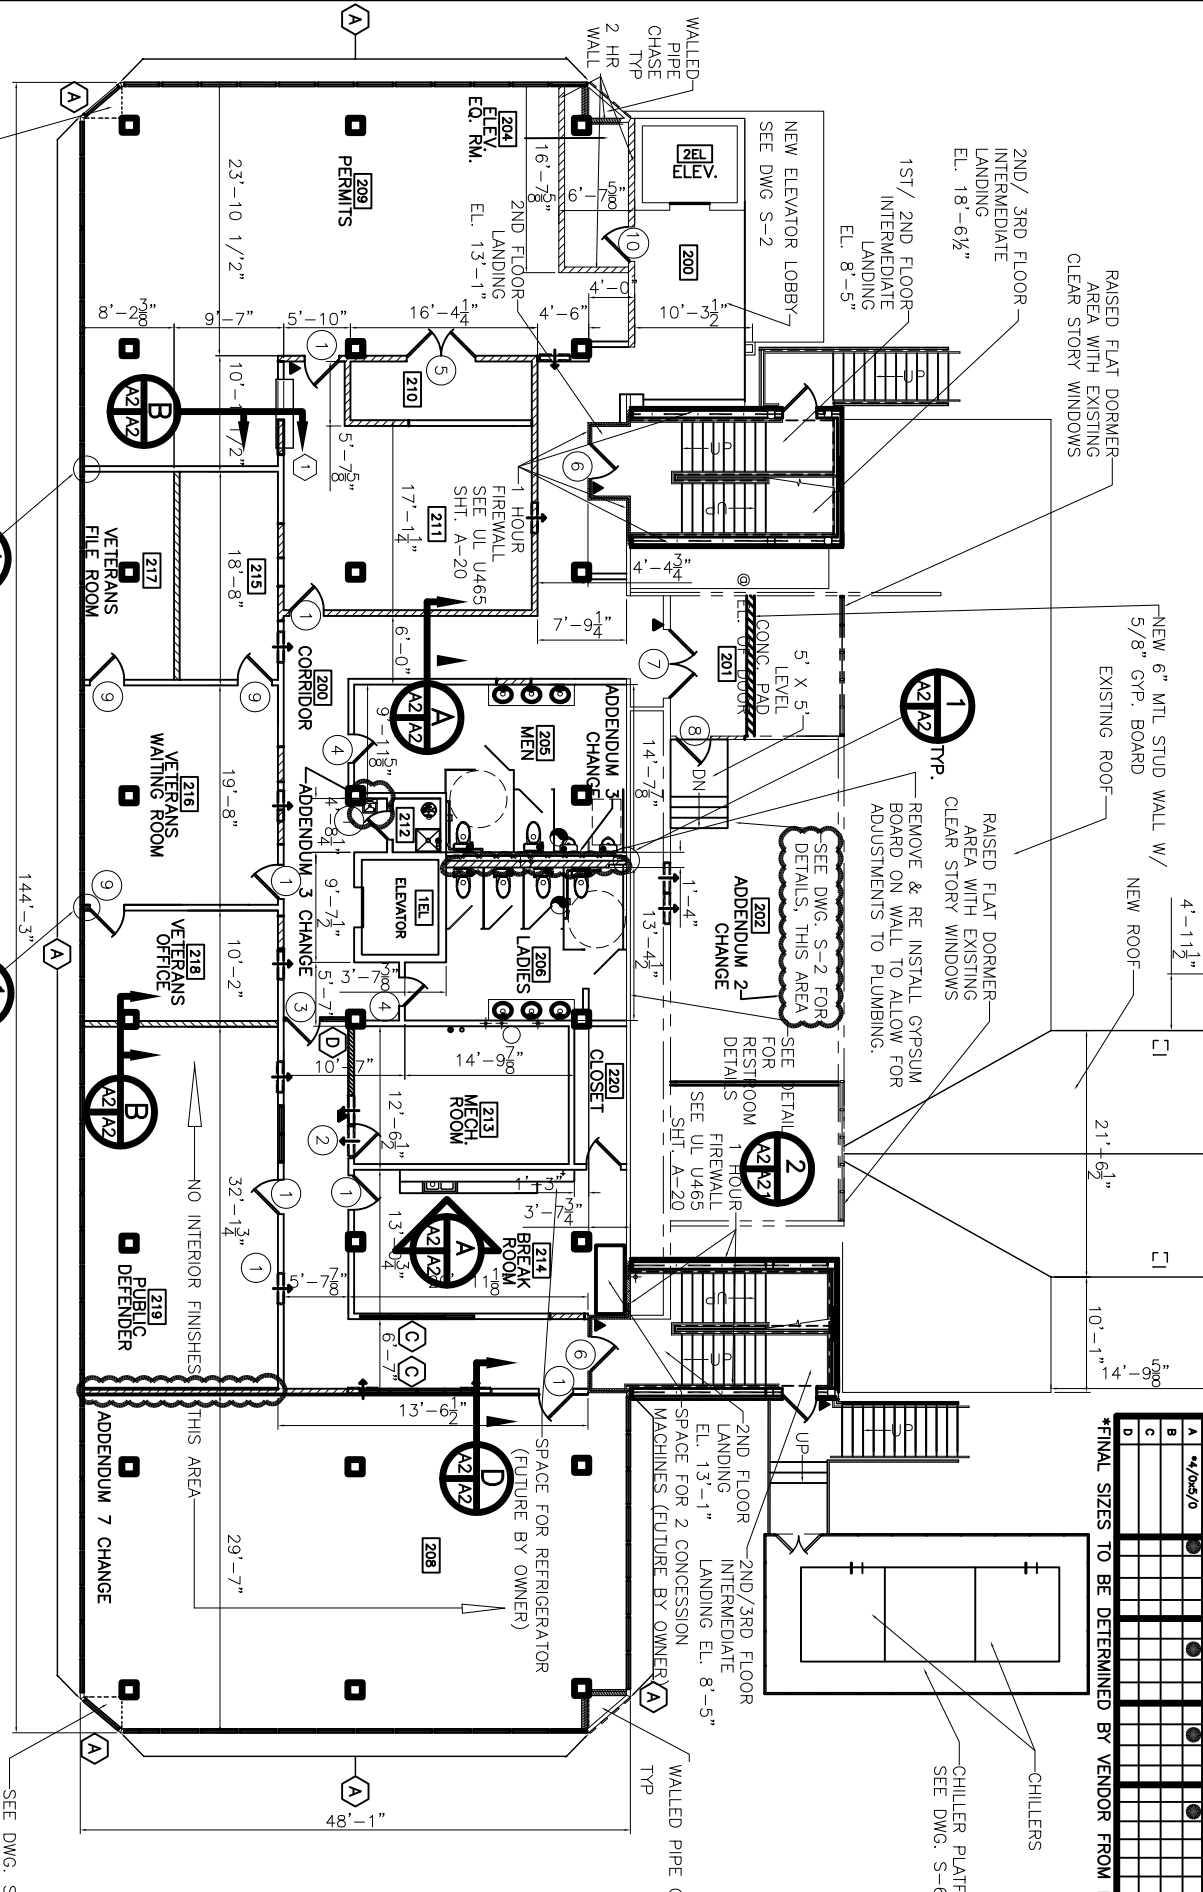

SCALE AS NOTED	
FILE:	DATE: 1-9-07
JOB NO. 1729	REVISIONS:
REVISIONS:	REVISIONS:
REVISIONS:	REVISIONS:
SHEET	
A-2	OF

RENOVATE OFFICE BUILDING	
DAMMON ENGINEERING, INC.	
1095 FLORIDA AVENUE 985-649-5832 SLIDELL, LA. 70458	
DAMMONENGINEERING.COM	

2ND FLOOR RENOVATE PLAN	
ST. TAMMANY PARISH ADMIN. COMPLEX	
520 OLD SPANISH TRAIL	
SLIDELL, LOUISIANA	