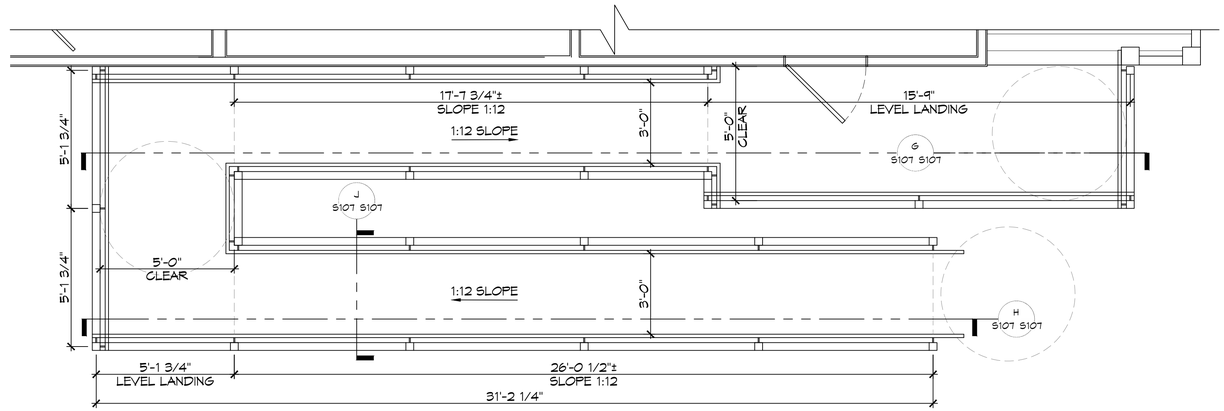

23 DECK PLAN VIEW
SCALE: 3/8"=1'-0"

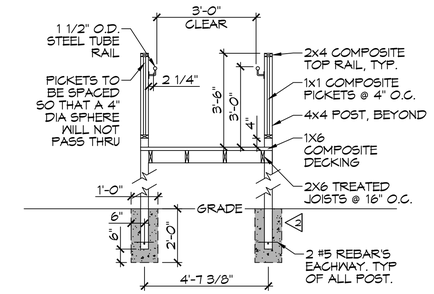

J RAMP SECTION VIEW
S107 | S107 SCALE: 3/8" = 1'-0"

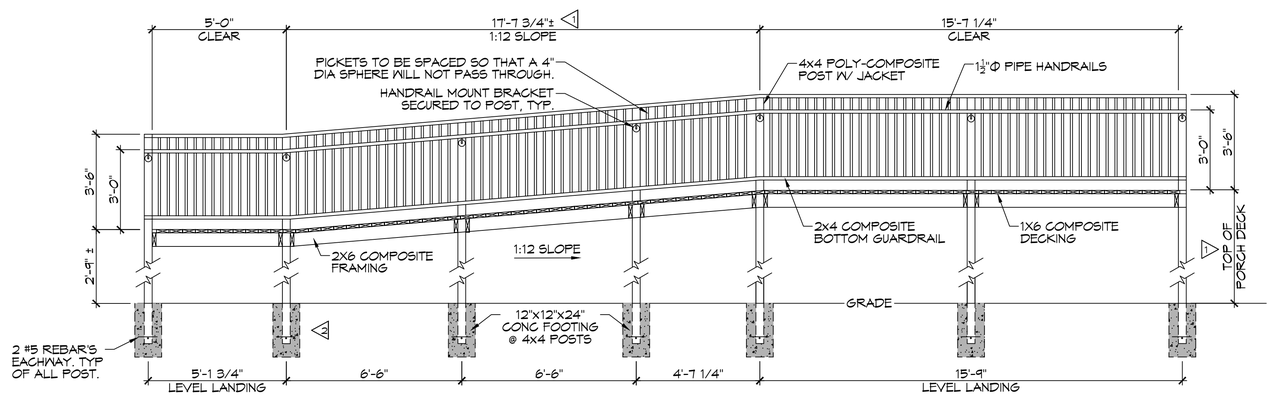

G RAMP SECTION VIEW
S107 | S107 SCALE: 3/8" = 1'-0"

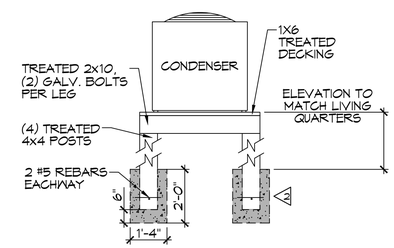

24 A/C CONDENSER
SCALE: 3/8"=1'-0"

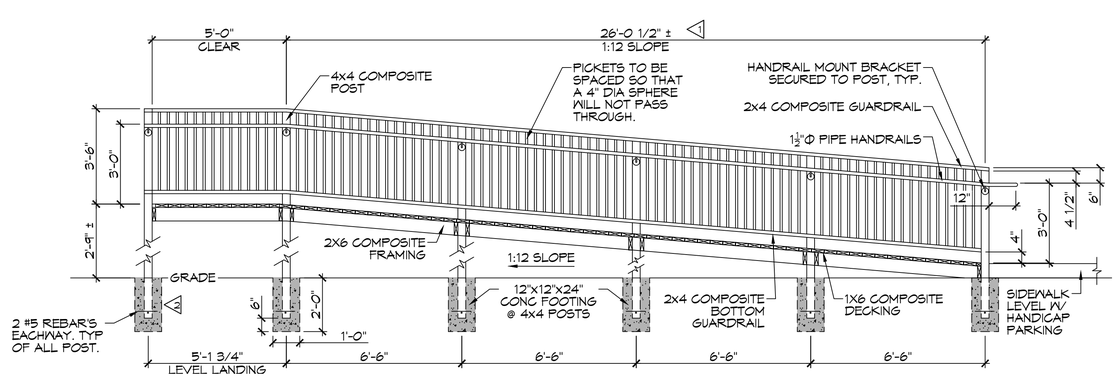

H RAMP SECTION VIEW
S107 | S107 SCALE: 3/8" = 1'-0"

GENERAL NOTES

1. FIELD VERIFY HEIGHT TO MATCH BUILDING
2. 4000 PSI CAST IN PLACE CONCRETE FOOTING

DAMMON ENGINEERING, INC.
LOUISIANA & MISSISSIPPI
www.dammonengineering.com
info@dammonengineering.com
PH: 985.649.5832
Chief Engineer: Brian Mistich, PE
504 Gibson Trail
Slidell, LA 70458

#	DESCRIPTION	DATE

REVISIONS

SEAL:

STATE OF LOUISIANA
BRIAN A. MISTICH
License No. 30187
PROFESSIONAL ENGINEER

ST. TAMMANY FIRE PROTECTION DISTRICT NO. 1

FIRE STATION 19

5'1047 ALLEN ROAD
SLIDELL, LOUISIANA 70461

JOB No: 2456
DATE: 05-16-2022
DRAWN BY: CKD
CHECKED BY: BAM

These plans and specifications, regardless of form, are the property of Dammon Engineering and shall not be loaned, copied or used for any purpose other than those specifically agreed to by Dammon Engineering. Any other use or reuse by any other person or entity is prohibited. Dammon Engineering is not responsible for any reuse of or changes made to these plans and specifications for any purpose other than those for which they were prepared and is entitled to compensation for any such reuse or changes made by others.

SHEET TITLE:
ADA RAMP

DRAWING NUMBER:

S107

SHEET No: 12 of 30