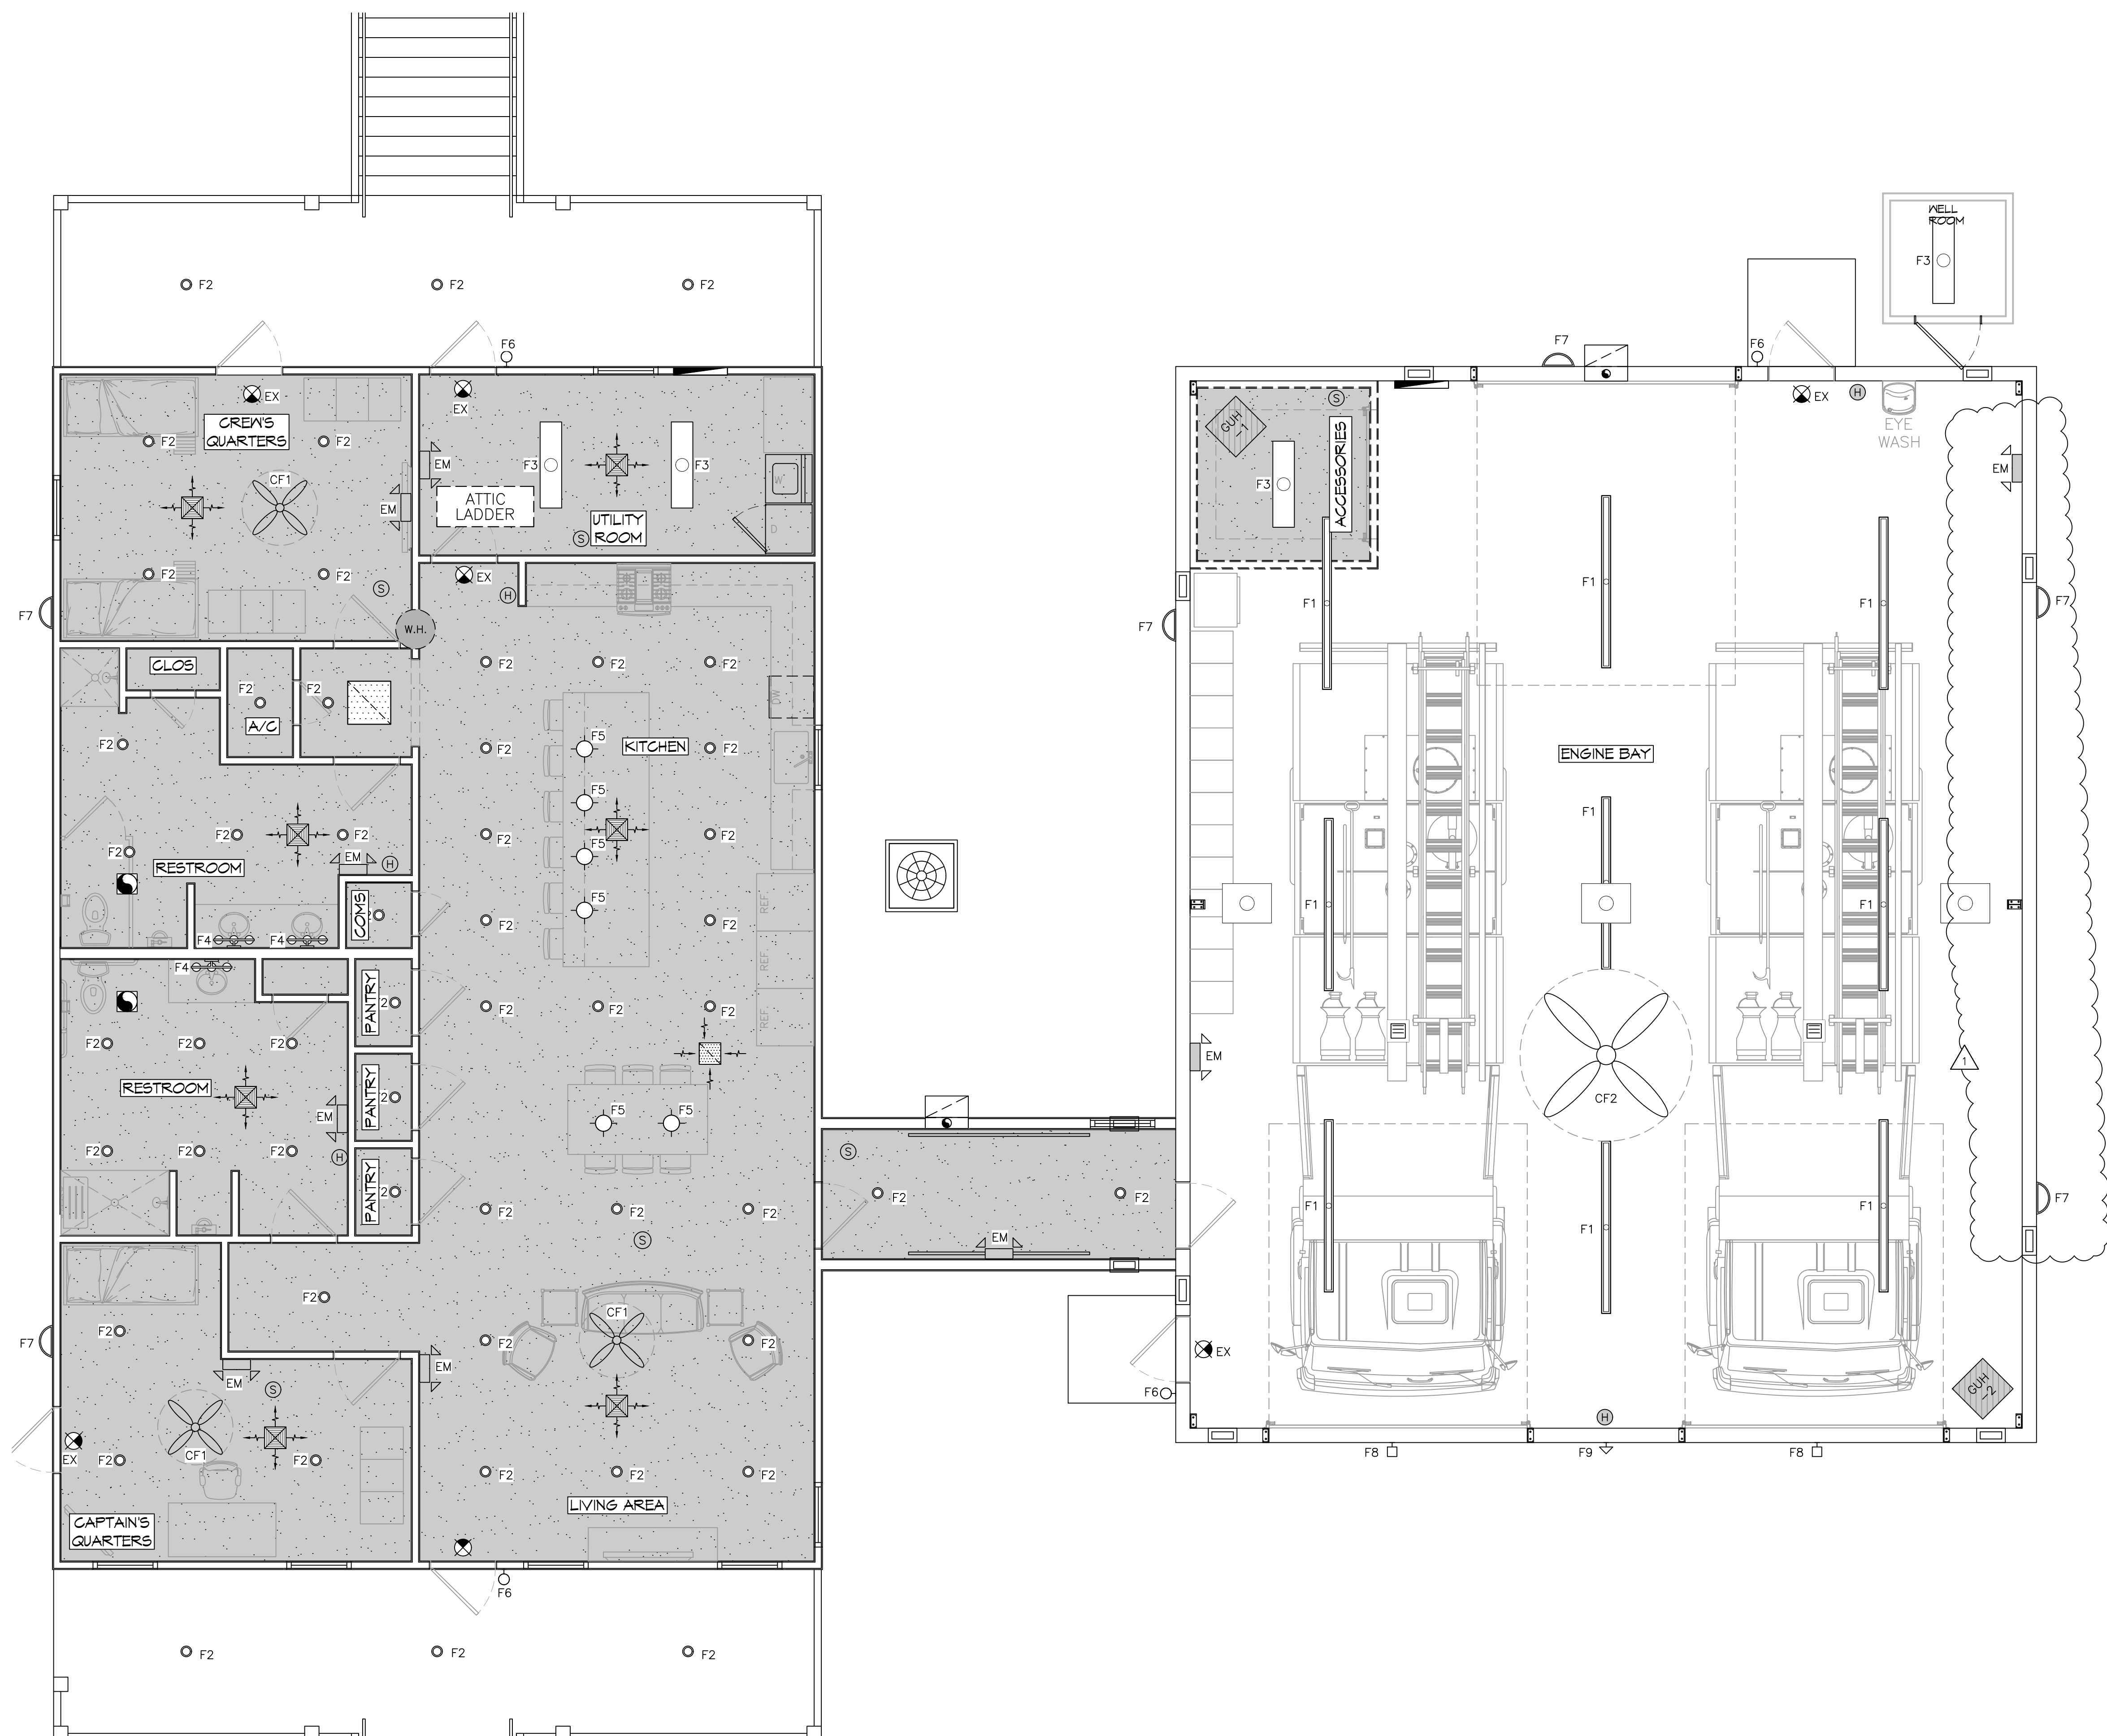
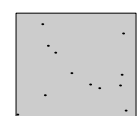
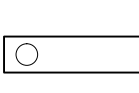
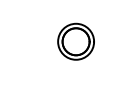
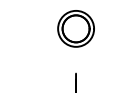
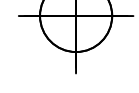
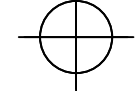
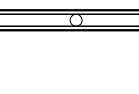

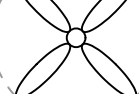
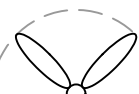
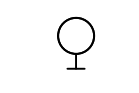

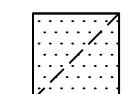
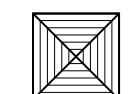

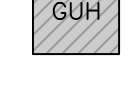
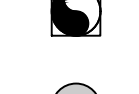
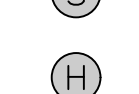
 


E:\WORK - A1 - DAMMON\38 - Allen Road Fire Station - 38 Reflected Ceiling Plan.dwg - 11/25/2022 2:14:44 PM



REFLECTIVE CEILING LEGEND

-  GYPSUM BOARD CEILING - 9'-0" A.F.F.
- LIGHTING**
- F1  1'x4' LENSED LED TROFFER IV/ UNIVERSAL BALLAST
COOPER 146R-LD4-28-A125-UNV-L835-1
- F2A  INTERIOR 6" RECESSED LIGHT
HALO PD6-12-ED10-PDM6-4956-61V-H-WF
- F2B  EXTERIOR 6" RECESSED LIGHT
HALO 5LD612-0-35-WH-UNV
- F3  9"Ø LED "TRISHA" PENDANT
TMS LIGHTING TRH-9-15LED-C36-35K-120-BR
- F4  16"Ø LED "GALVIN" PENDANT
TMS LIGHTING GAL-1-16-TLED-C36-35K-120-BR
- F5  8" LED SHOP LIGHT IV/ CHAIN HANGING KIT & WIRE GUARD
METALUX 8TNLED-LD4-885L-UNV-L835-CD1-U-AYC-WG4
- F6  LED VANITY LIGHT
METALUX 52NLED-LD4-205L-LM-UNV-L835-CD1-5VFP2-U
- F7A  42" CEILING FAN - CONTRACTOR SERIES, BRUSHED STEEL
MINKA AIRE F546-B5
- F7B  8"Ø SHOP FAN - BIG ASS FAN
BIG ASS FANS POWERFOL 8-08
- F8  EXTERIOR WALL SCONCE
KILLARK VSL-16-30-V1H-S
-  LED EXIT SIGN
COOPER EST-10-R-120V-C
- MECHANICAL**
-  HVAC RETURN AIR GRILLE
-  HVAC SUPPLY AIR GRILLE
-  HVAC MINI SPLIT
-  GAS FIRED HEATER
-  EXHAUST FAN
-  SMOKE DETECTOR
-  HEAT DETECTOR

38 REFLECTED CEILING PLAN
SCALE: 1/4" = 1'-0"

DAMMON ENGINEERING, INC.
 LOUISIANA & MISSISSIPPI
 Chief Engineer: Brian Misch, PE
 554 Old Spanish Trail
 Slidell, LA 70458
 www.dammonengineering.com
 info@dammonengineering.com
 PH: 985.649.8832

REVISIONS	DATE
1	7/25/2022
DESCRIPTION: lighting right side of Engine Bay.	

SEAL:



ST. TAMMANY FIRE PROTECTION DISTRICT No. 1
FIRE STATION 19
 57047 ALLEN ROAD
 SLIDELL, LOUISIANA 70461
 JOB No: 2456
 DATE: 05-16-2022
 DRAWN BY: CKD
 CHECKED BY: JMS

SHEET TITLE:
REFLECTIVE CEILING PLAN

DRAWING NUMBER:
A106

SHEET No: 20 of 30