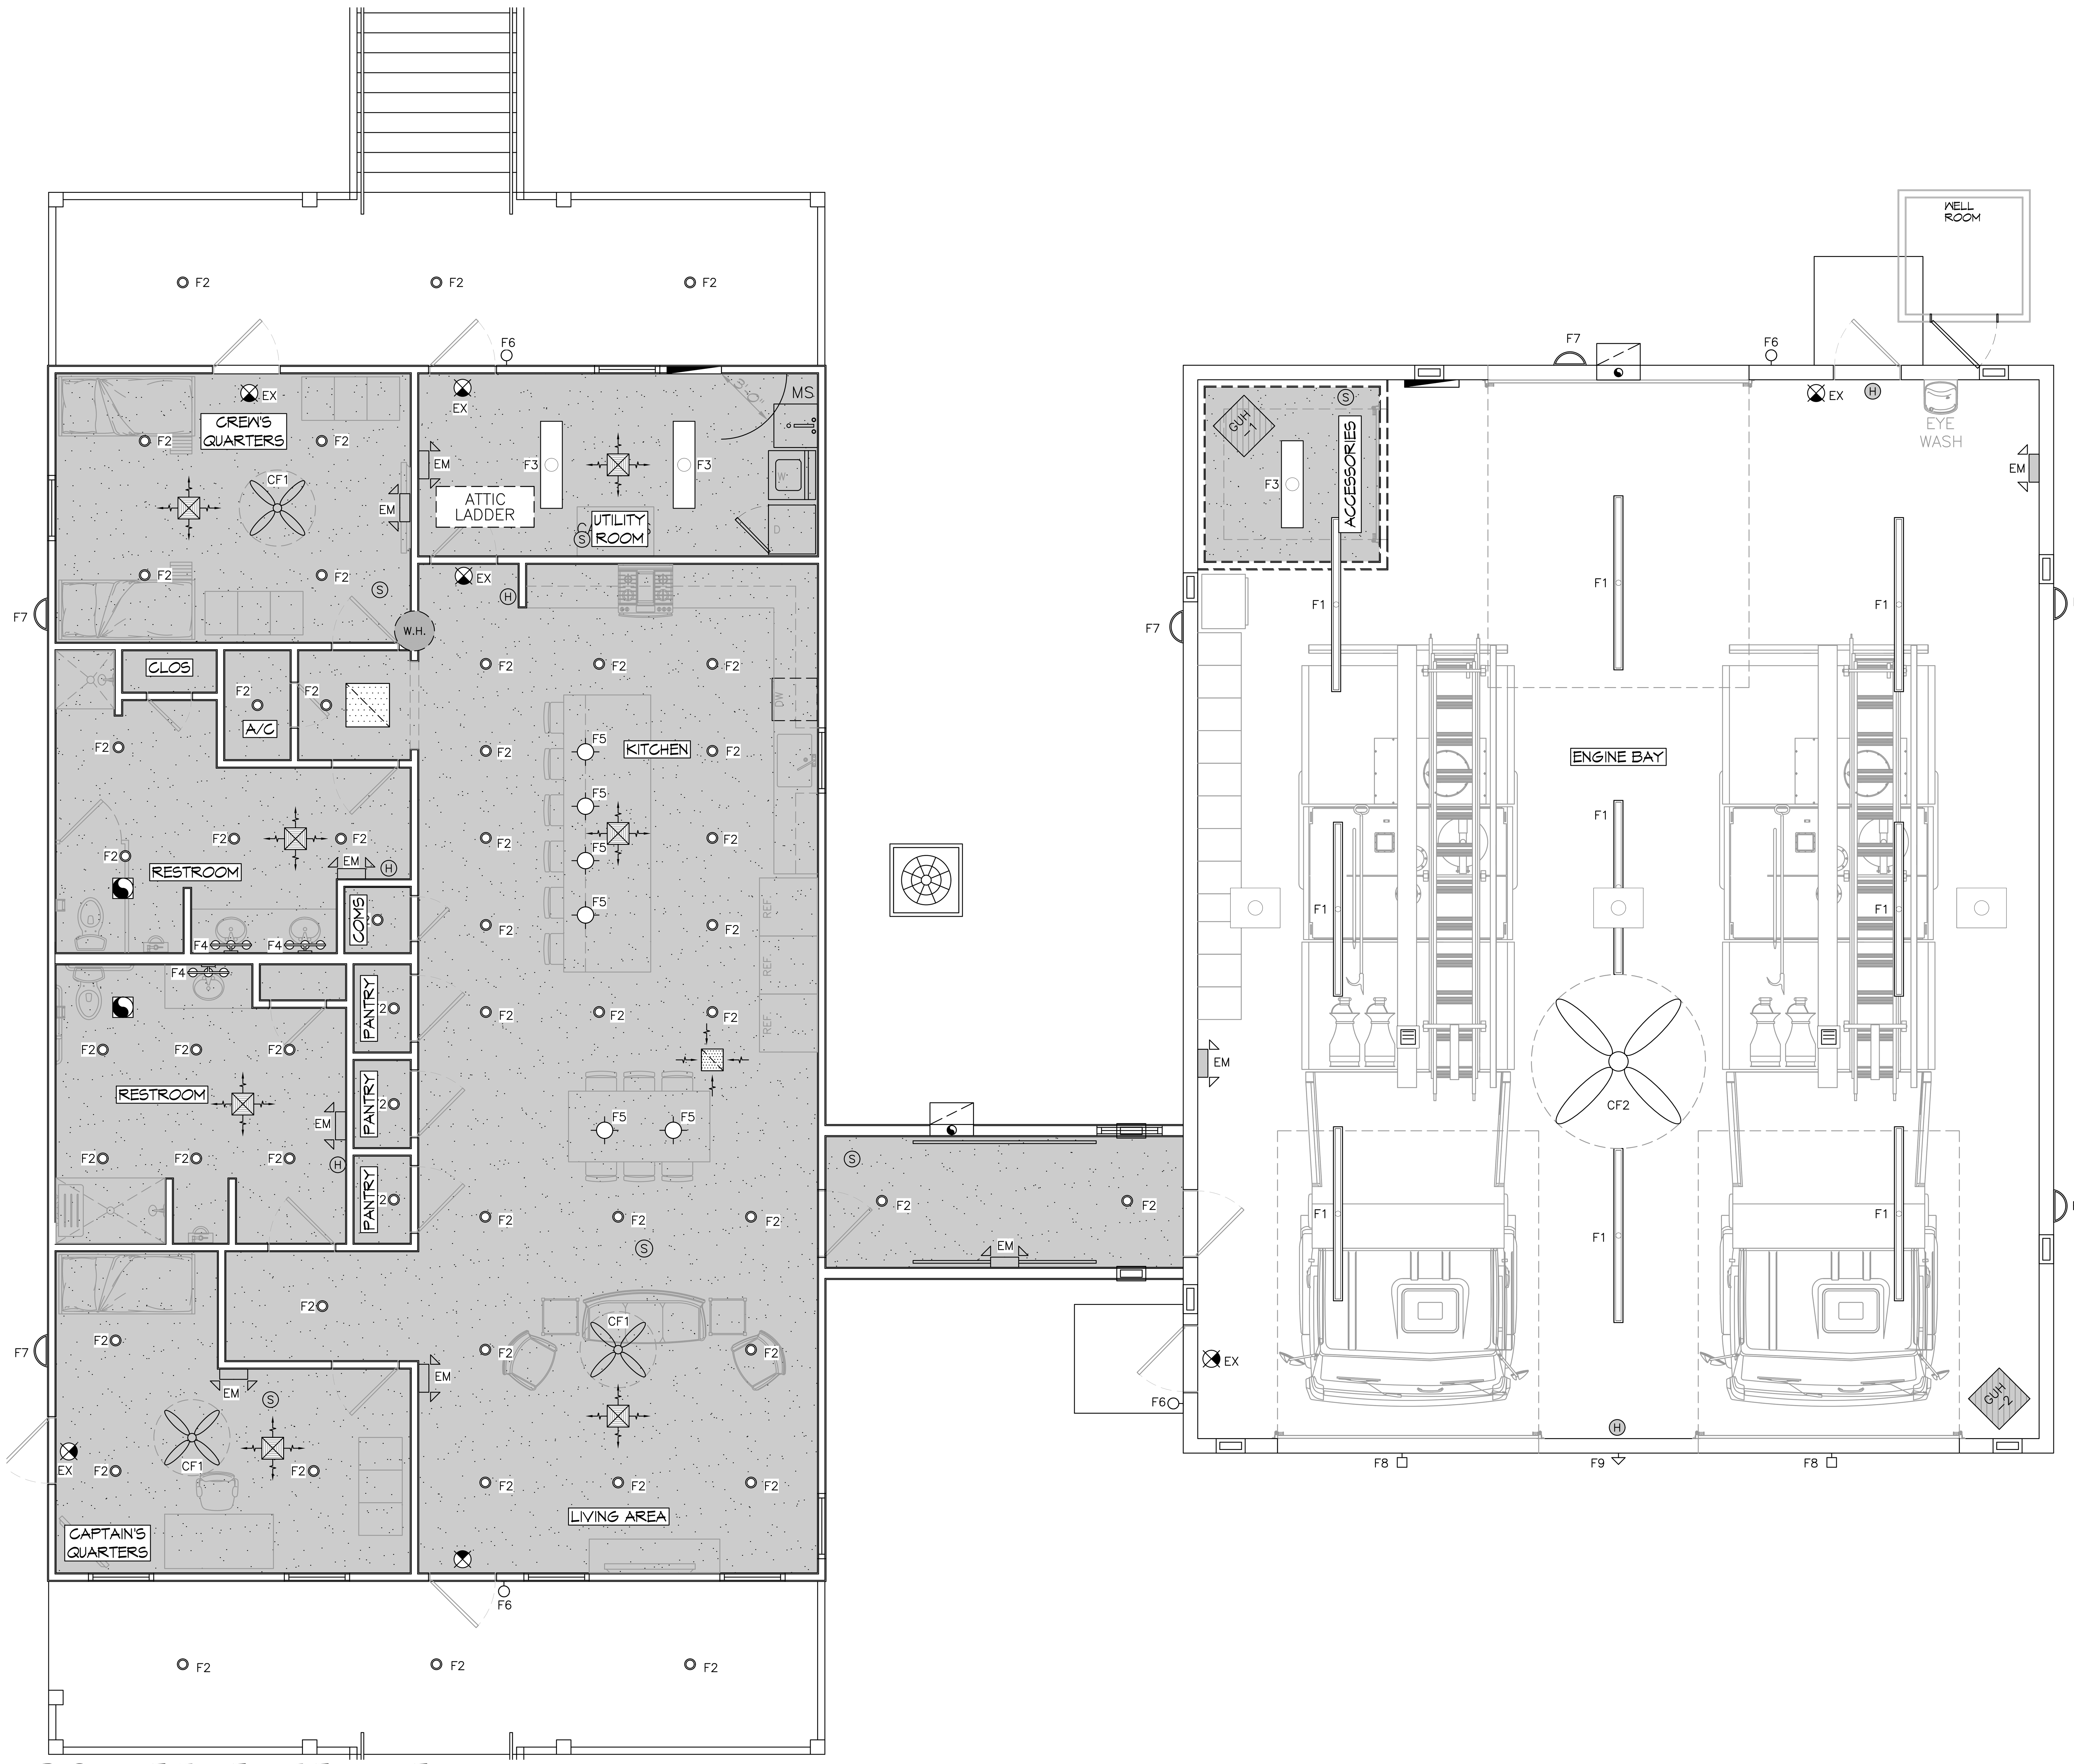

38 REFLECTED CEILING PLAN
SCALE: 1/4"= 1'-0"

REFLECTIVE CEILING LEGEND

GYPSUM BOARD CEILING - 9'-0" A.F.F

LIGHTING

F1		1'x4' LENSED LED TROFFER W/ UNIVERSAL BALLAST COOPER 14GR-LD4-28-A125-UNV-L835-1
F2A		INTERIOR 6" RECESSED LIGHT HALO PD6-12-ED010-PDM6-9356-61V-H-WF
F2B		EXTERIOR 6" RECESSED LIGHT HALO SLD612-8-35-WH-UNV
F3		9"Ø LED "TRISHA" PENDANT TMS LIGHTING TRI-1-9-15LED-C36-35K-120-BR
F4		16"Ø LED "CALVIN" PENDANT TMS LIGHTING CAL-1-16-17LED-C36-35K-120-BR
F5		8' LED SHOP LIGHT W/ CHAIN HANGING KIT & WIRE GUARD METALUX 8TSNLED-LD4-88SL-UNV-L835-CD1-U-AYC-WG4
F6		LED VANITY LIGHT METALUX S24LED-LD4-20SL-LW-UNV-L835-CD1-SVPD2-U
F7A		42" CEILING FAN - CONTRACTOR SERIES, BRUSHED STEEL MINKA AIRE F546-BS
F7B		8'Ø SHOP FAN - BIG ASS FAN BIG ASS FANS POWERFOIL 8-05
F8		EXTERIOR WALL SCONCE KILLARK VSL-18-30-V1-H-G
		LED EXIT SIGN COOPER ES7-70-R-120V-C

MECHANICAL

HVAC RETURN AIR GRILLE
HVAC SUPPLY AIR GRILLE
HVAC MINI SPLIT
GAS FIRED HEATER (GUH)
EXHAUST FAN
SMOKE DETECTOR (S)
HEAT DETECTOR (H)

DAMMON ENGINEERING, INC.
LOUISIANA & MISSISSIPPI
Chief Engineer: Brian Mistich, PE
554 Old Spanish Trail
Slidell, LA 70458
www.dammonengineering.com
info@dammonengineering.com
PH: 985.649.5832

#	DESCRIPTION	DATE
REVISIONS		

ST. TAMMANY FIRE PROTECTION DISTRICT No. 1

FIRE STATION 19

51047 ALLEN ROAD
SLIDELL, LOUISIANA 70461

JOB No:	2456	DATE:	05-16-2022
DRAWN BY:	CKD	CHECKED BY:	JMS

SHEET TITLE:
REFLECTIVE CEILING PLAN

DRAWING NUMBER:
A106

SHEET No: 20 of 30

AS-BUILT
1-31-24