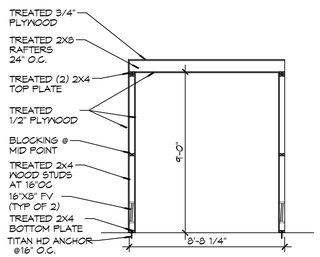

21 ACCESSORIES BLDG SECTION
SCALE: 1/4" = 1'-0"

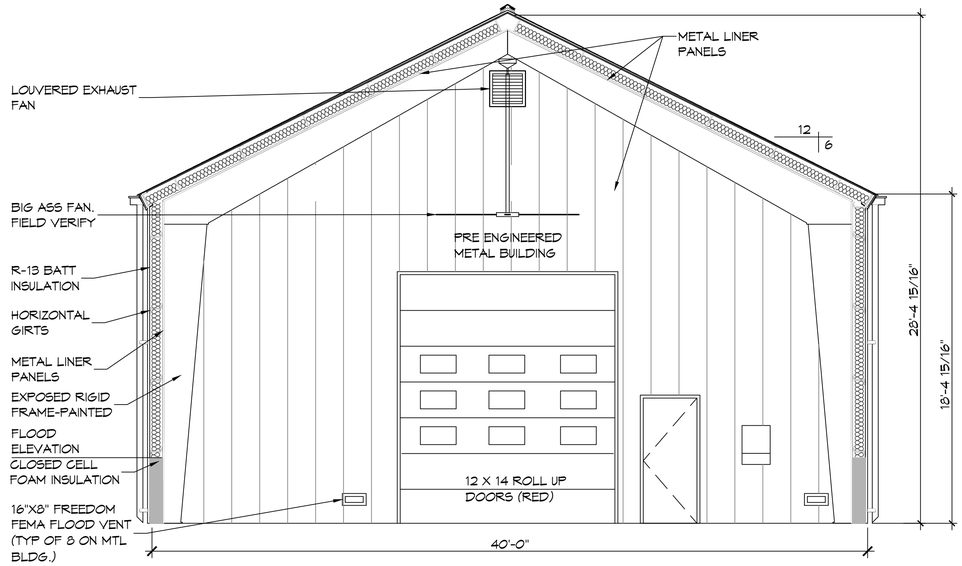

22 ENGINE BAY BLDG SECTION
SCALE: 1/4" = 1'-0"

ENGINE BAY

AS-BUILT
1-31-24

DAMMON ENGINEERING, INC.
LOUISIANA & MISSISSIPPI
www.dammonengineering.com
info@dammonengineering.com
PH: 985-649-5922
Chief Engineer: Brian Mistich, PE
554 Old Spanish Trail
Slidell, LA 70458

#	DESCRIPTION	DATE

REVISIONS

STATE OF LOUISIANA
BRIAN A. MISTICH
License No. 30187
PROFESSIONAL ENGINEER

ST. TAMMANY FIRE PROTECTION DISTRICT NO. 1

FIRE STATION 19

5704 ALLEN ROAD
SLIDELL, LOUISIANA 70461

JOB No: 2456
DATE: 05-16-2022
DRAWN BY: CAD
CHECKED BY: BAM

These plans and specifications, regardless of the extent to which they may be used in the future, are the property of Dammon Engineering, Inc. and may not be used for any purpose or project except those for which they have been prepared and adapted unless permission is obtained from Dammon Engineering, Inc. Any alteration of these plans and specifications is prohibited by law to the extent such alteration may affect the health and safety of the public. Any such alteration must be sealed by a registered professional engineer who assumes responsibility for the alteration.
COPYRIGHT © 2022 DAMMON ENGINEERING, INC. ALL RIGHTS RESERVED

SHEET TITLE:
ENGINE BAY SECTION

DRAWING NUMBER:
S106

SHEET No: 11 of 30

FILE NAME: J:\2-Dammon\2456 - New Bush Fire Station - LA\Drawing\Current Drawings\S106-Engine Bay Framing Section.dwg PLOT DATE & TIME: Wednesday, January 31, 2024 3:11:00 PM