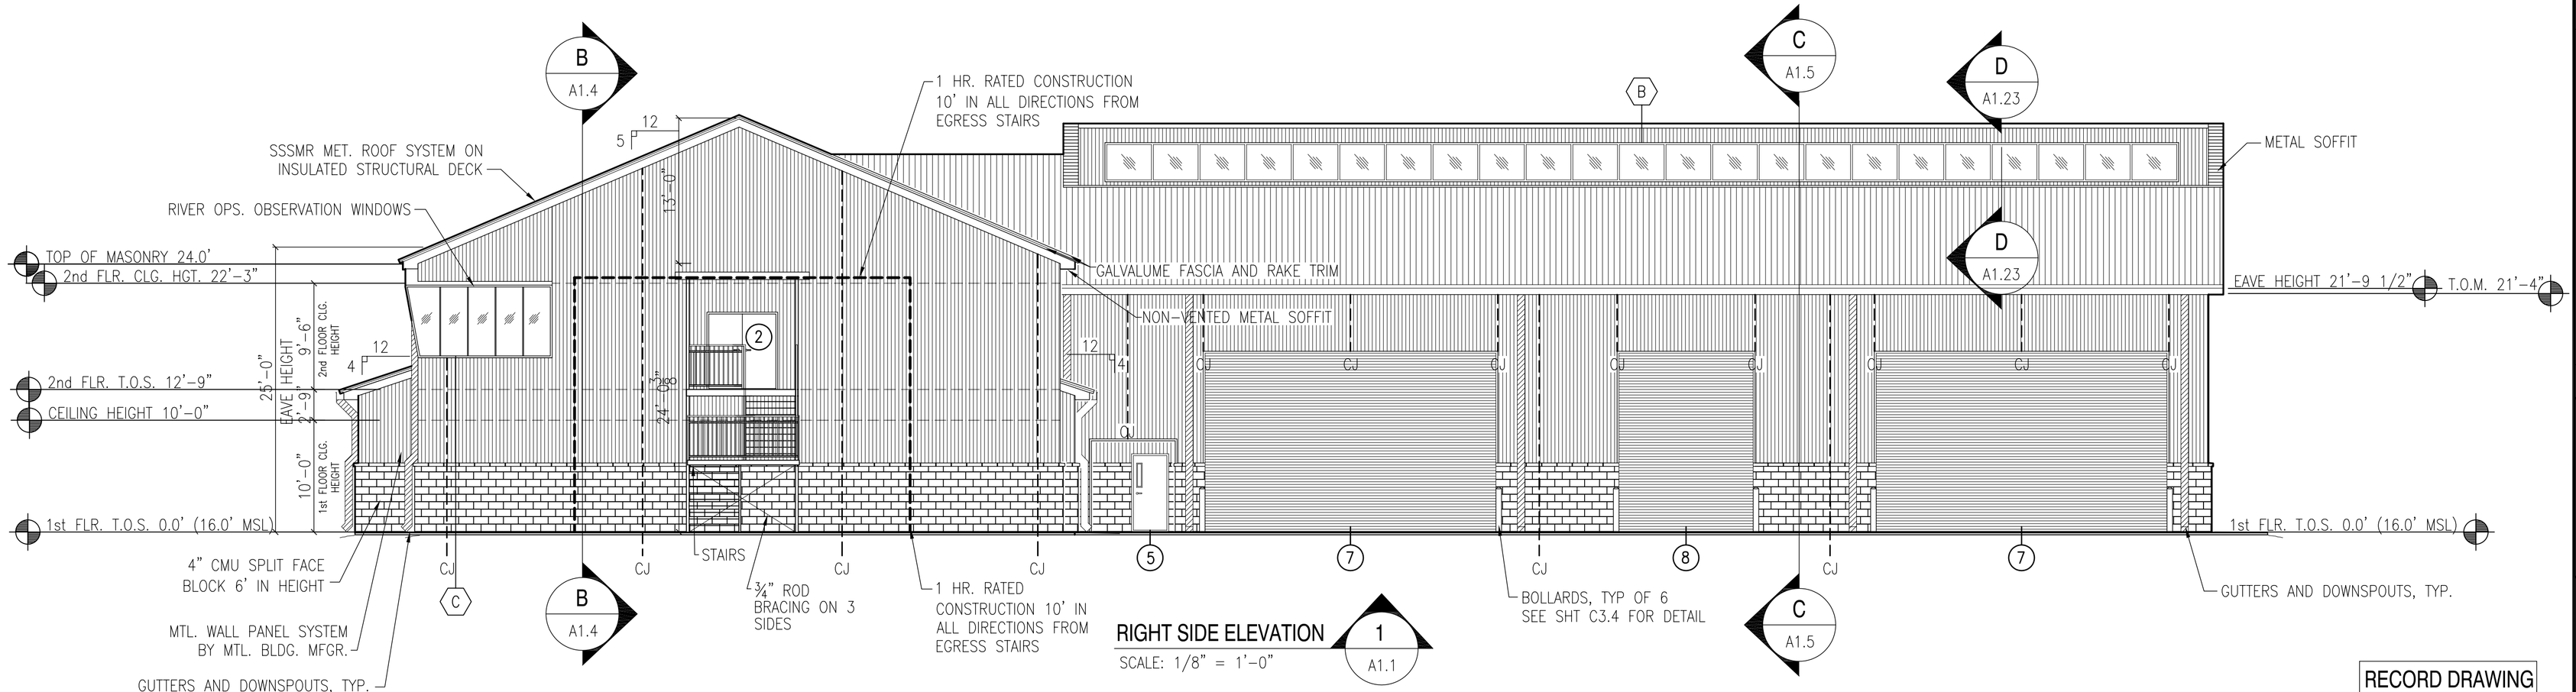

RIGHT SIDE ELEVATION 1 A1.1

SCALE: 1/8" = 1'-0"

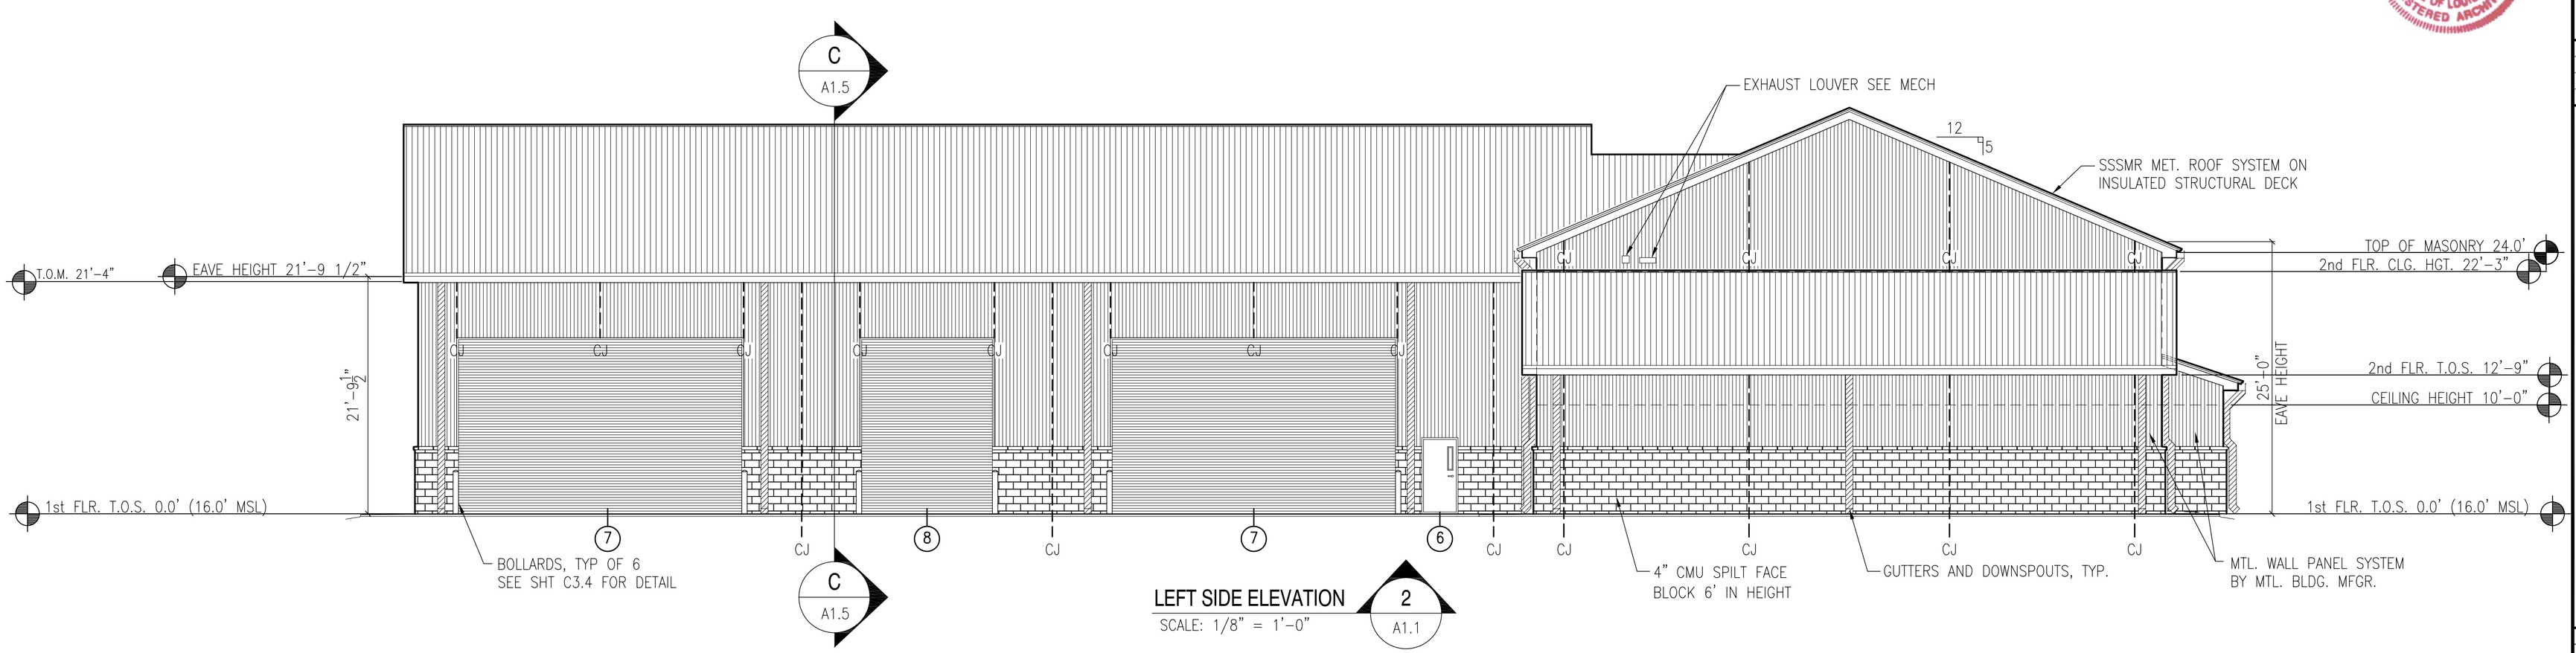

LEFT SIDE ELEVATION 2 A1.1

SCALE: 1/8" = 1'-0"

5' 0 5' 10' 15' 20' 25'

RECORD DRAWING LETTER DATED - 5-27-10

DATE	DESCRIPTION	APPR
3-12-10	AS-BUILT	RW
11-6-09	REVISED AS PER UPS COMMENTS 9 OCTOBER 2009	RW

NAVFAC

DAMMON ENGINEERING, INC.
CHIEF ENGINEER EMMETT G. DAMMON, P.E.
CHIEF ARCHITECT ROBERT LEE WILTSE
1095 FLORIDA AVENUE
SLIDELL, LA 70458
(985) 649-5832
SEPTEMBER 4, 2009

DES: R. WILTSE | DRW: J. TIFFANY
REVIEWED BY: R. WILTSE
PM/DM: T. ARTRIP
CHIEF ENG/ARCH. P. DAMMON

DEPARTMENT OF THE NAVY
NAVAL FACILITIES ENGINEERING COMMAND SOUTHEAST
JOHN C. STENNIS SPACE CENTER
NAVAL FACILITIES ENGINEERING COMMAND
NAVAL AIR STATION JACKSONVILLE
MISSISSIPPI
SOF RIVERINE AND COMBATANT CRAFT OPERATIONS FACILITY - PRE-FINAL
OPS./MAINT. BLDG. 2440/2441 ELEVATIONS

CODE ID. NO. N4412 | SIZE D
SCALE: AS SHOWN
MAXIMO NO. #####
STA. PROJ. NO. P-210
WORK ORDER NO. 510247
CONSTR. CONTR. NO. N62467-05-D-0096
NAVFAC DRAWING NO. 15026685
SHEET 38 OF 132

A1.8

DRAWFORM REVISION: 01 JAN 2009

REVDATE: