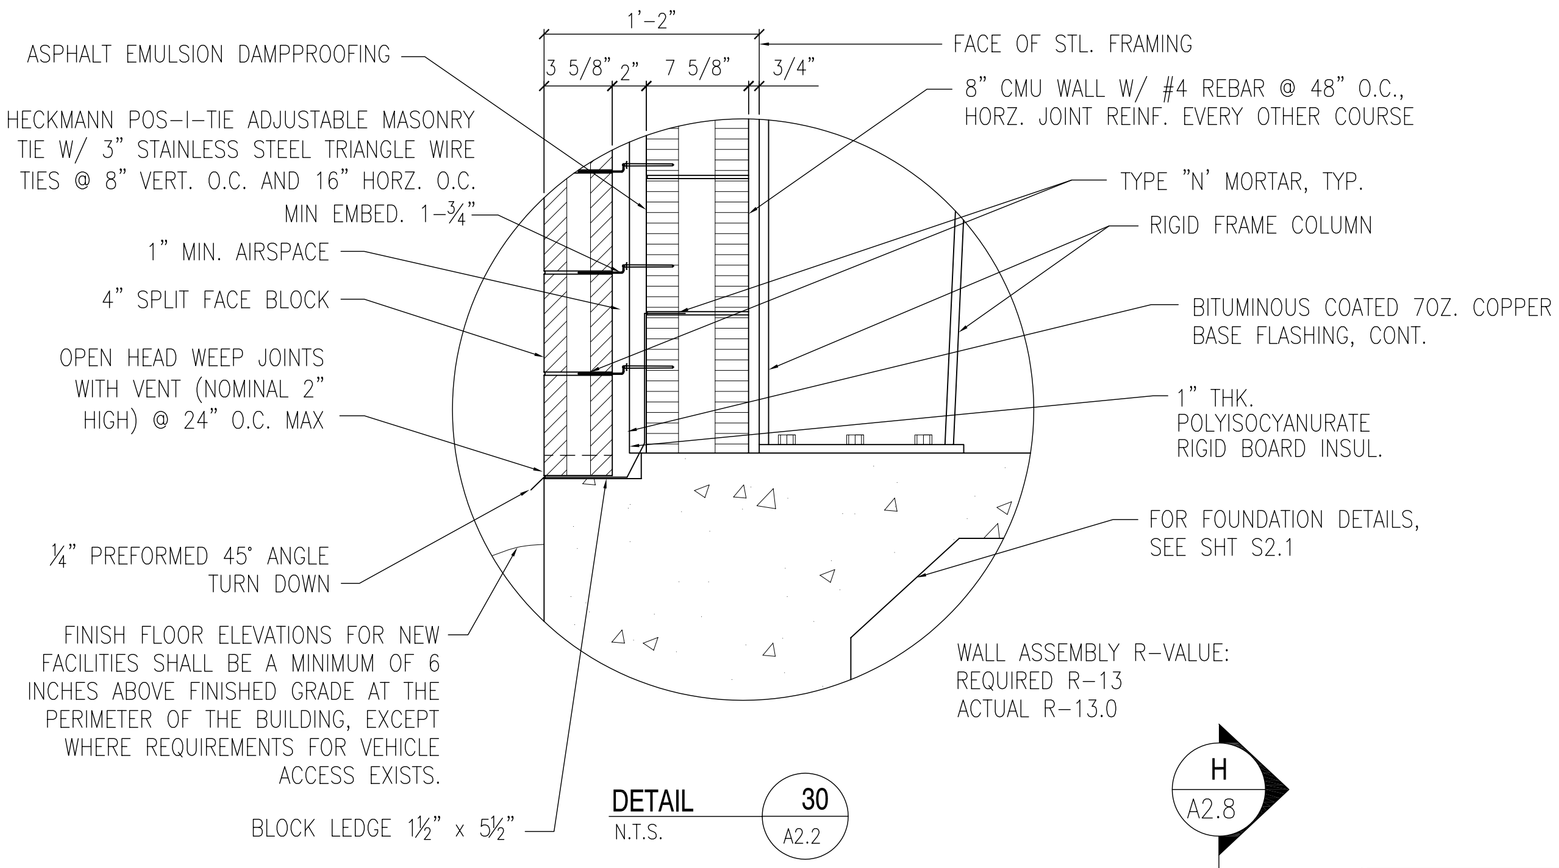

DETAIL 30 (A2.2)
N.T.S.

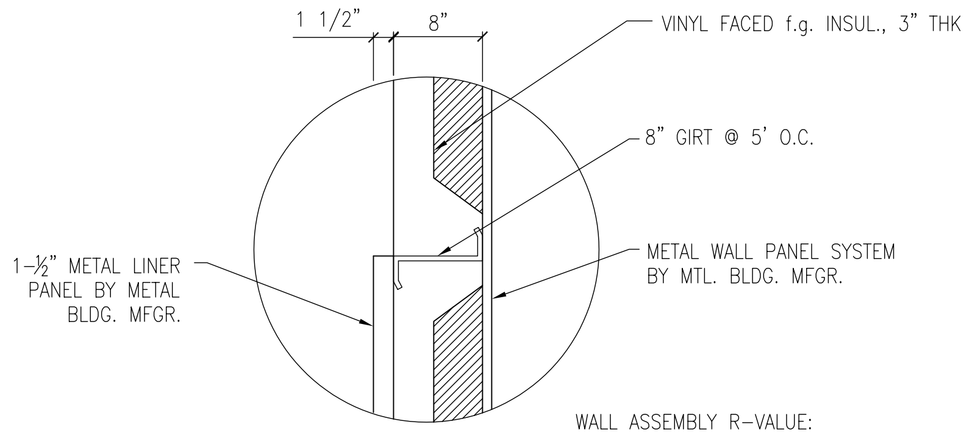

DETAIL 31 (A2.2)
N.T.S.

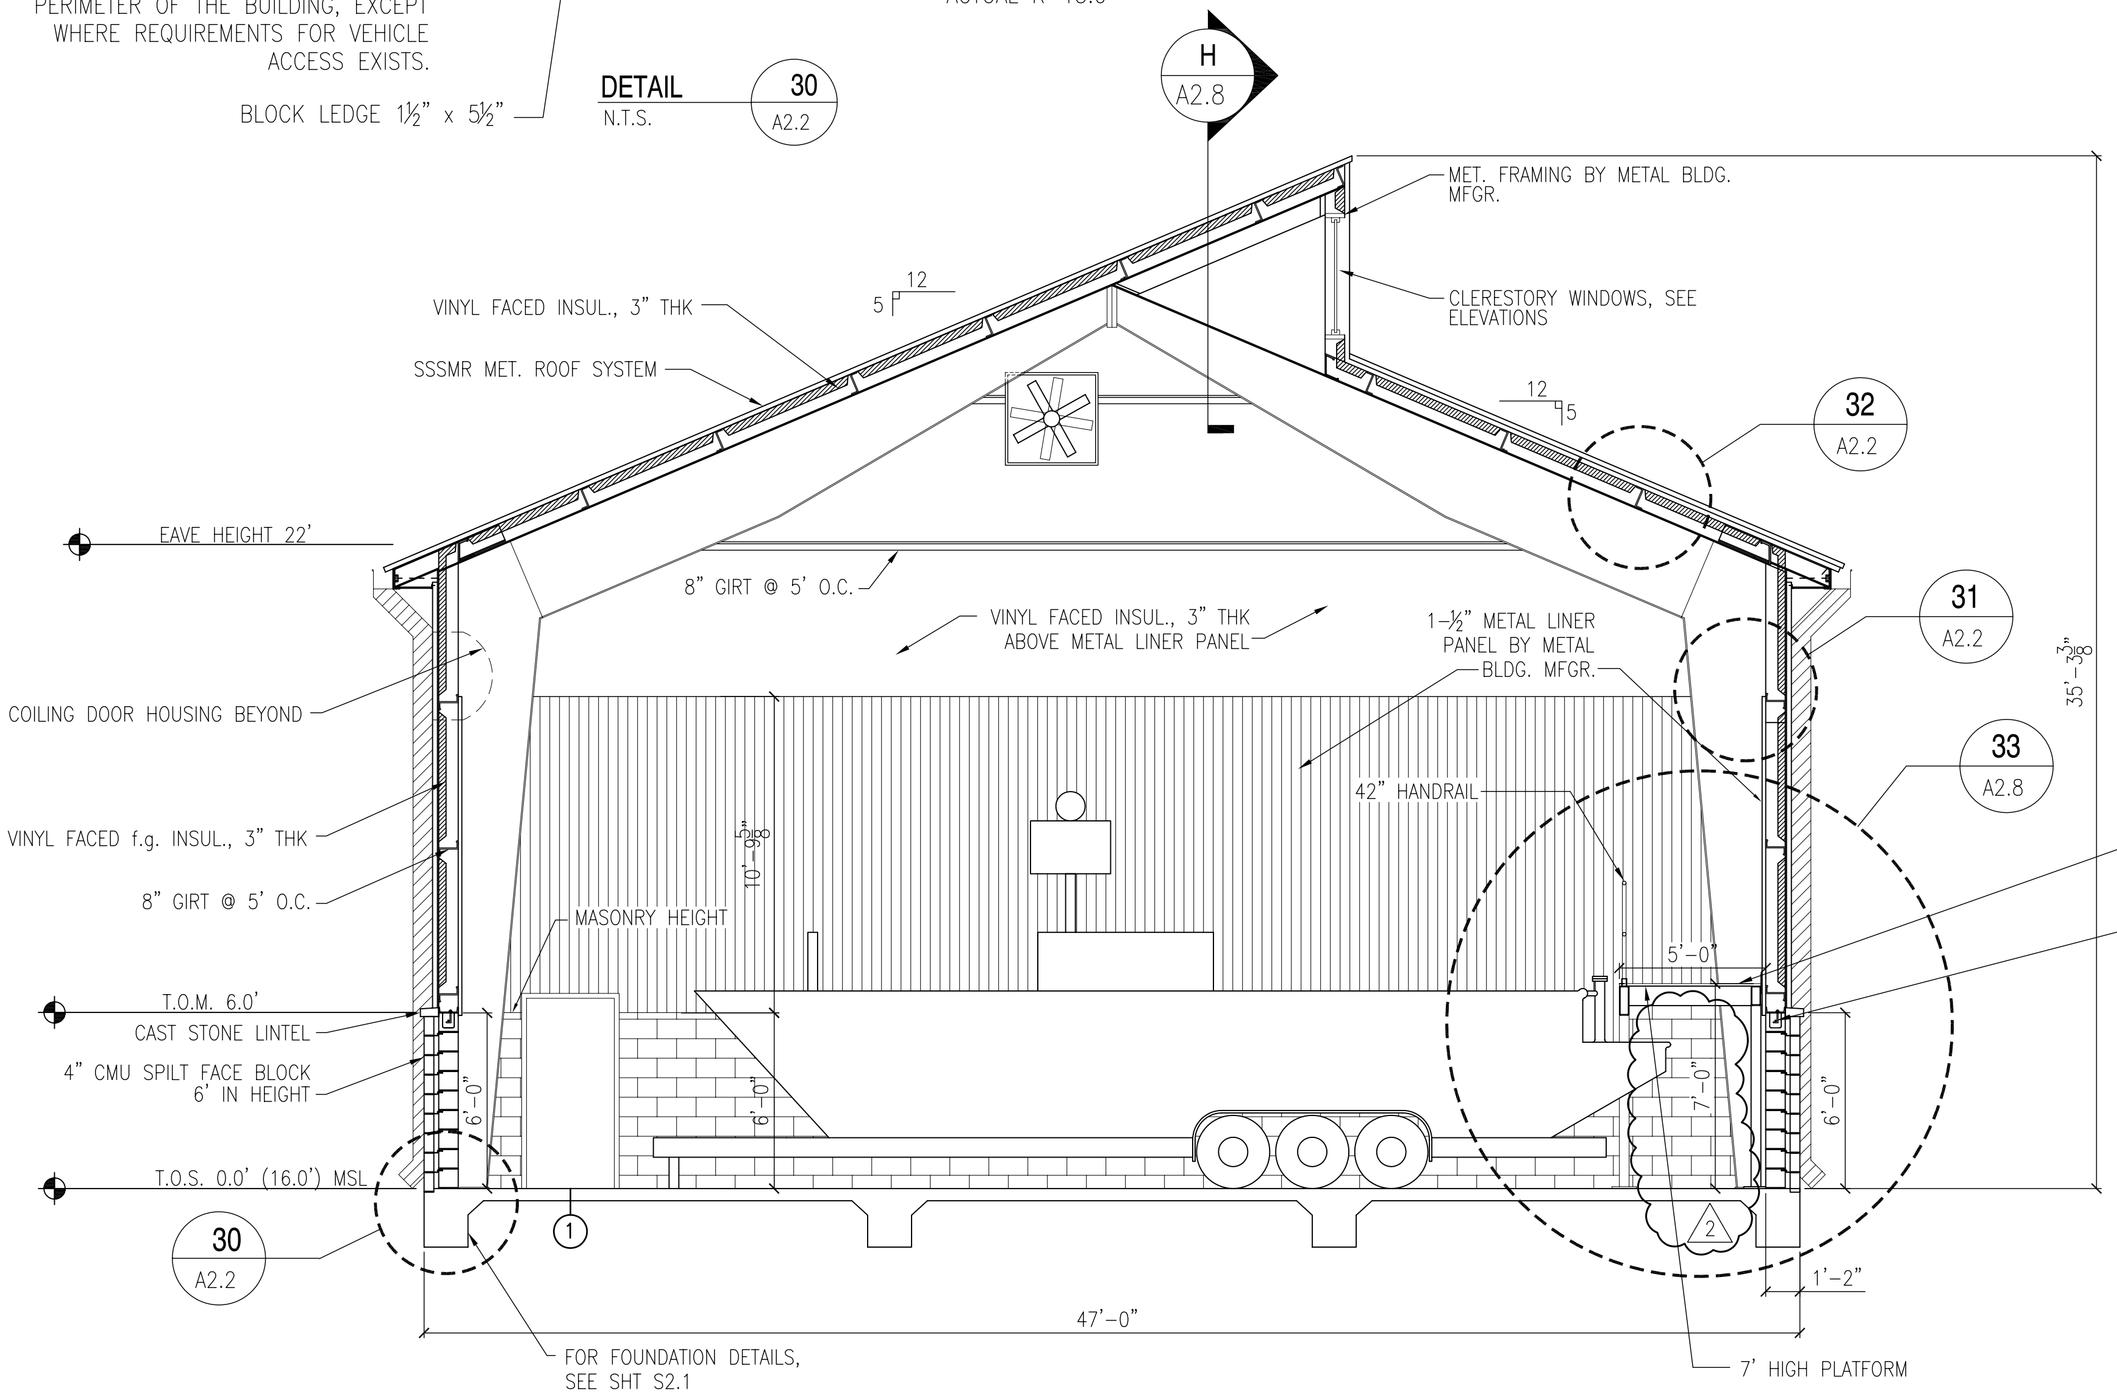

BOAT STORAGE BLDG. 2442 SECTION (F, A2.1)
SCALE: ¼"=1'-0"

5' 0 5' 10'

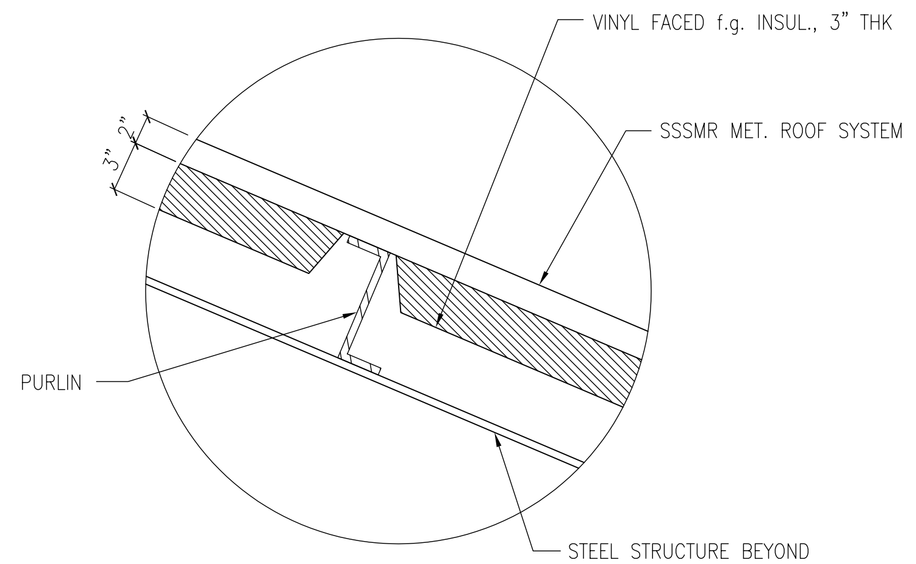

ROOF ASSEMBLY R-VALUE:
REQUIRED R-6
ACTUAL R-10

DETAIL 32 (A2.2)
N.T.S.

RECORD DRAWING
LETTER DATED -
5-27-10

3	AS-BUILT CONDITIONS SHOWN	4-25-10 RW
2	REVISED AS PER USS COMMENTS 9 OCTOBER 2009	11-6-09 RW
DESCRIPTION		DATE APPR

NAVFAC

DAMMON ENGINEERING, INC.
CHIEF ENGINEER EMMETT DAMMON, P.E.
CHIEF ARCHITECT ROBERT WILTSE
1095 FLORIDA AVENUE
SLIDELL, LA 70458
(985) 649-5832
SEPTEMBER 4, 2009

EMMETT G. DAMMON LICENSED PROFESSIONAL ENGINEER 9652 STATE OF MISSISSIPPI

DES: R. WILTSE | DRW: J. TIFFANY
REVIEWED BY: R. WILTSE
PM/DM: T. ARTRIP
CHIEF ENG/ARCH: P. DAMMON

DEPARTMENT OF THE NAVY
NAVAL FACILITIES ENGINEERING COMMAND SOUTHEAST
PPT GULF COAST
JOHN C. STENNIS SPACE CENTER
NAVAL FACILITIES ENGINEERING COMMAND
NAVAL AIR STATION JACKSONVILLE
MISSISSIPPI

SOF RIVERINE AND COMBATANT CRAFT OPERATIONS FACILITY - PRE-FINAL

BOAT STORAGE BLDG. 2442 SECTION

CODE ID. NO. N4412 | SIZE D
SCALE: AS SHOWN
MAXIMO NO. #####
STA. PROJ. NO. P-210
WORK ORDER NO. 510247
CONSTR. CONTR. NO. N62467-05-D-0096
NAVFAC DRAWING NO. 15026702
SHEET 55 OF 132

A2.2

DRAWFORM REVISION: 01 JAN 2009

ROBERT LEE WILTSE REG. NO. 27258 STATE OF LOUISIANA REGISTERED ARCHITECT

REVDATE: