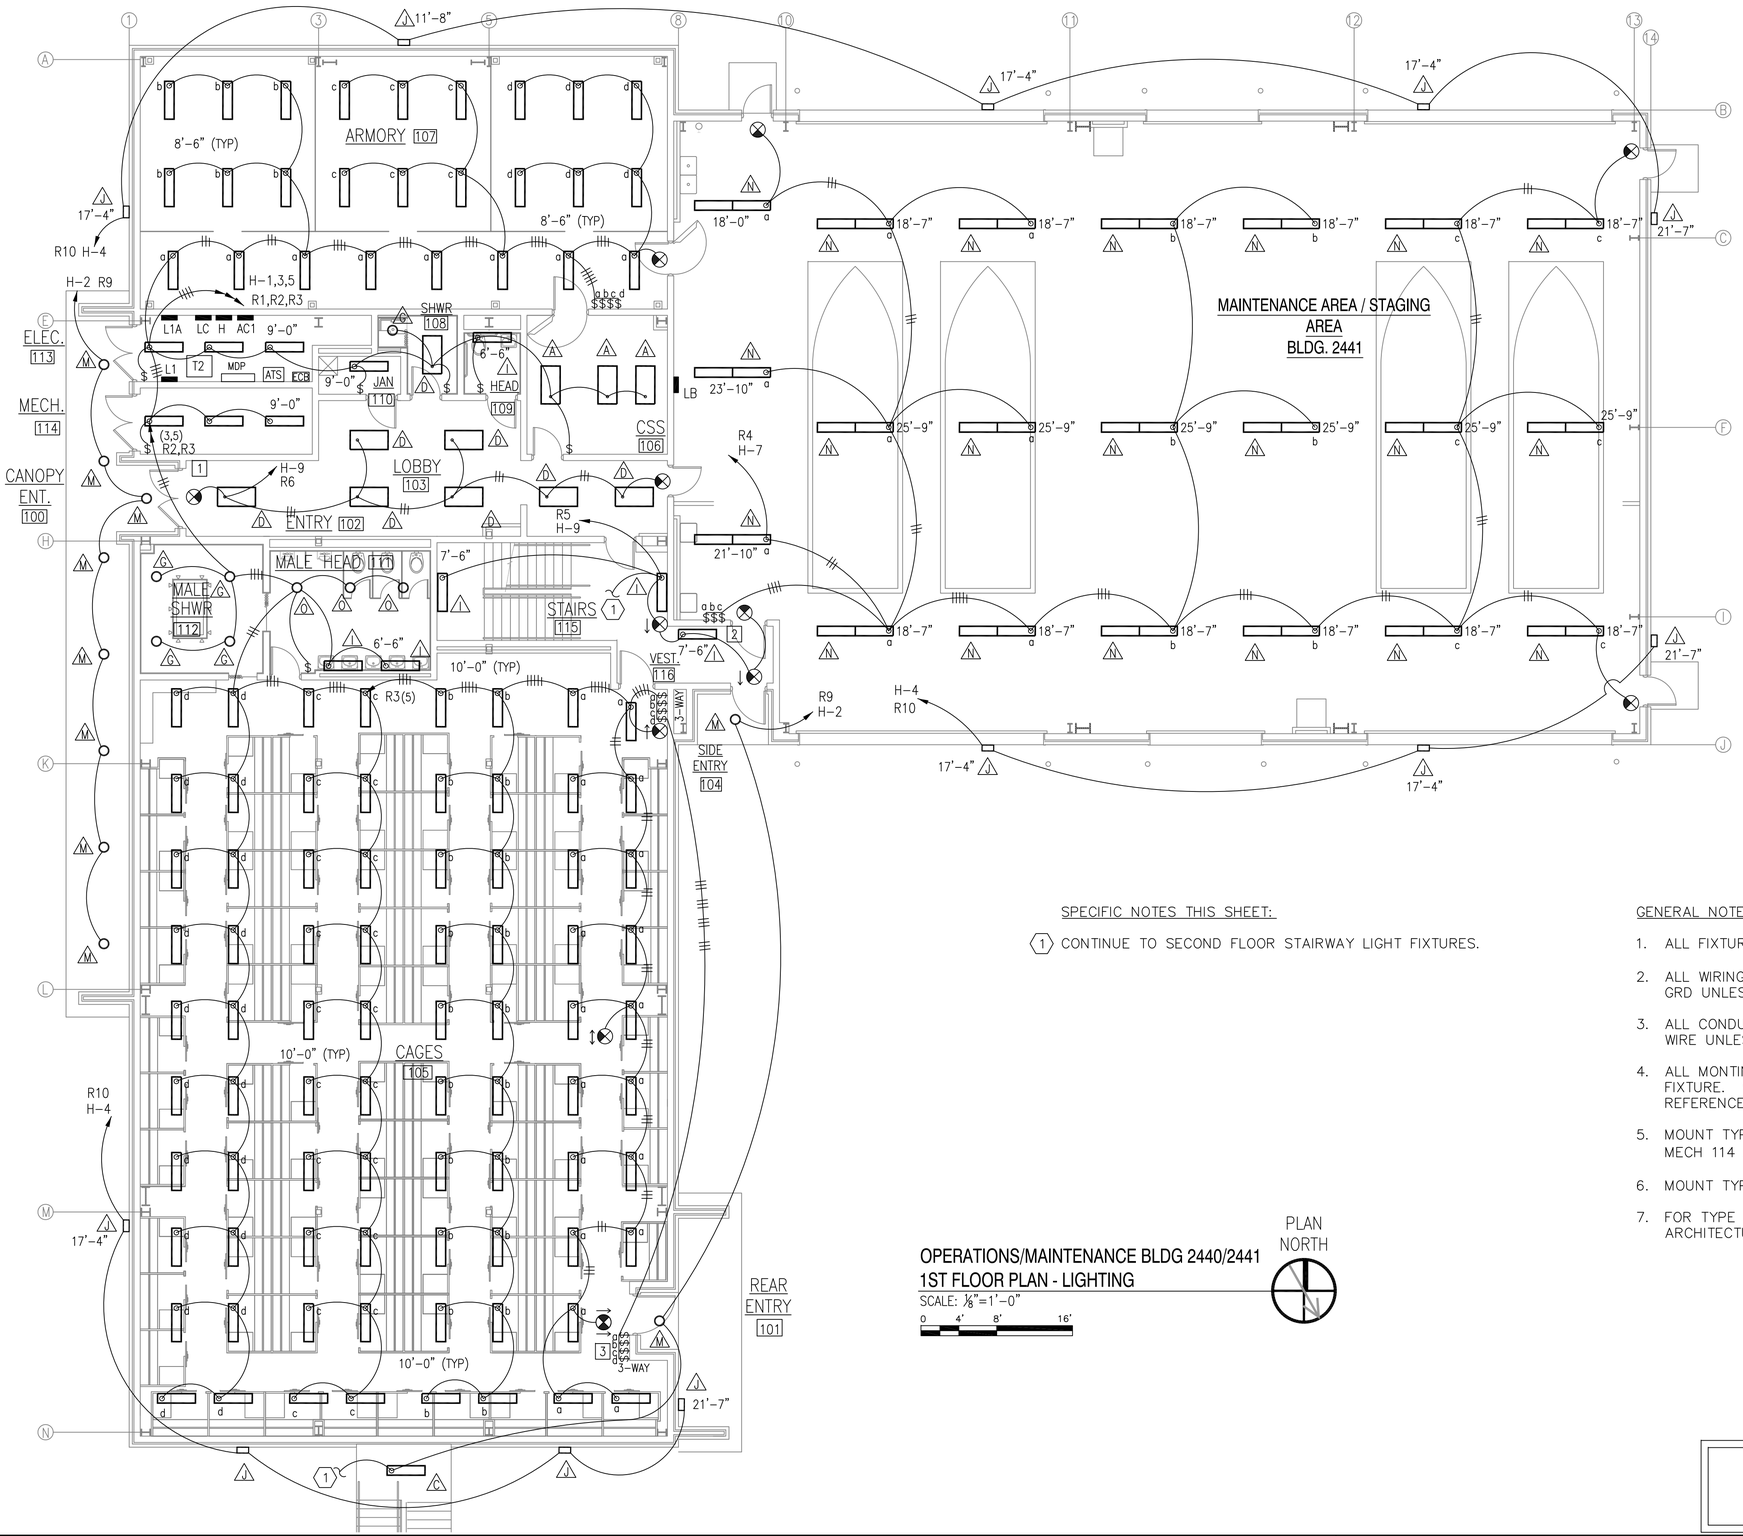

SPECIFIC NOTES THIS SHEET:

(1) CONTINUE TO SECOND FLOOR STAIRWAY LIGHT FIXTURES.

GENERAL NOTES THIS SHEET:

1. ALL FIXTURES TYPE E UNLESS NOTED OTHERWISE.
2. ALL WIRING SHALL BE 3/4"C: 2-#12 AWG AND 1-#12 GRD UNLESS NOTED OTHERWISE.
3. ALL CONDUIT SHALL CONTAIN MINIMUM #12 AWG GROUND WIRE UNLESS NOTED OTHERWISE.
4. ALL MONTING HEIGHTS SHOWN ARE TO BOTTOM OF FIXTURE. WHERE MOUNTING HEIGHTS FOR FIXTURES VARY, REFERENCE DIMENSION NEXT TO FIXTURE.
5. MOUNT TYPE E FIXTURES IN CAGES 105, ELEC 113, AND MECH 114 AT 10'-0" AFF.
6. MOUNT TYPE E FIXTURES IN ARMORY 107 AT 8'-6" AFF.
7. FOR TYPE I FIXTURES IN HEAD 109 AND 111, REFERENCE ARCHITECTURAL ELEVATIONS FOR MOUNTING HEIGHT.

OPERATIONS/MAINTENANCE BLDG 2440/2441
1ST FLOOR PLAN - LIGHTING
SCALE: 1/8"=1'-0"
0 4' 8' 16'

PLAN NORTH

RECORD DRAWING
LETTER DATED
5-27-10

DATE	DESCRIPTION	SYM	APPR
5-27-10	AS-BUILT REVISIONS		

NAVFAC

SCHLAFLY ENGINEERING LLC
121 SOUTH GENOIS STREET
NEW ORLEANS LA 70119
PHONE 504-415-3347
FAX 504-482-7943
M. KIMBALL SCHLAFLY, P.E.
LA REG 27699
SEPTEMBER 4, 2009

STATE OF LOUISIANA
M. KIMBALL SCHLAFLY
REG. No. 27699
REGISTERED PROFESSIONAL ENGINEER
IN
ELECTRICAL ENGINEERING
SEAL

DES: K. SCHLAFLY | DRW: K. SCHLAFLY
REVIEWED BY: R. WILTSE
PM/DM: T. ARTRIP
CHIEF ENG/ARCH: P. DAMMON

DEPARTMENT OF THE NAVY
NAVAL FACILITIES ENGINEERING COMMAND
IPT SOUTH ATLANTIC
JOHN C. STENNIS SPACE CENTER

NAVAL FACILITIES ENGINEERING COMMAND
NAVAL FACILITIES ENGINEERING COMMAND SOUTHEAST
NAVAL AIR STATION JACKSONVILLE
MISSISSIPPI

SOF RIVERINE AND COMBATANT CRAFT OPERATIONS FACILITY

BLDG 2440/2441 1ST FLOOR - LIGHTING

CODE ID. NO. N4412	SIZE D
SCALE:	AS SHOWN
MAXIMO NO.	######
STA. PROJ. NO.	P-210
WORK ORDER NO.	510247
CONSTR. CONTR. NO.	N62467-05-D-0096
NAVFAC DRAWING NO.	15026757
SHEET	110 OF 132

E3.1

DRAWFORM REVISION: 01 JAN 2009

REVDATE: FILE NAME: C:\Schlafly ENGR\08010 SOF Riverine\Drawings\Elec 5-As-builts\E3.1.dwg LAYOUT NAME: E3.1 PLOTTED: Friday, May 28, 2010 - 3:08pm