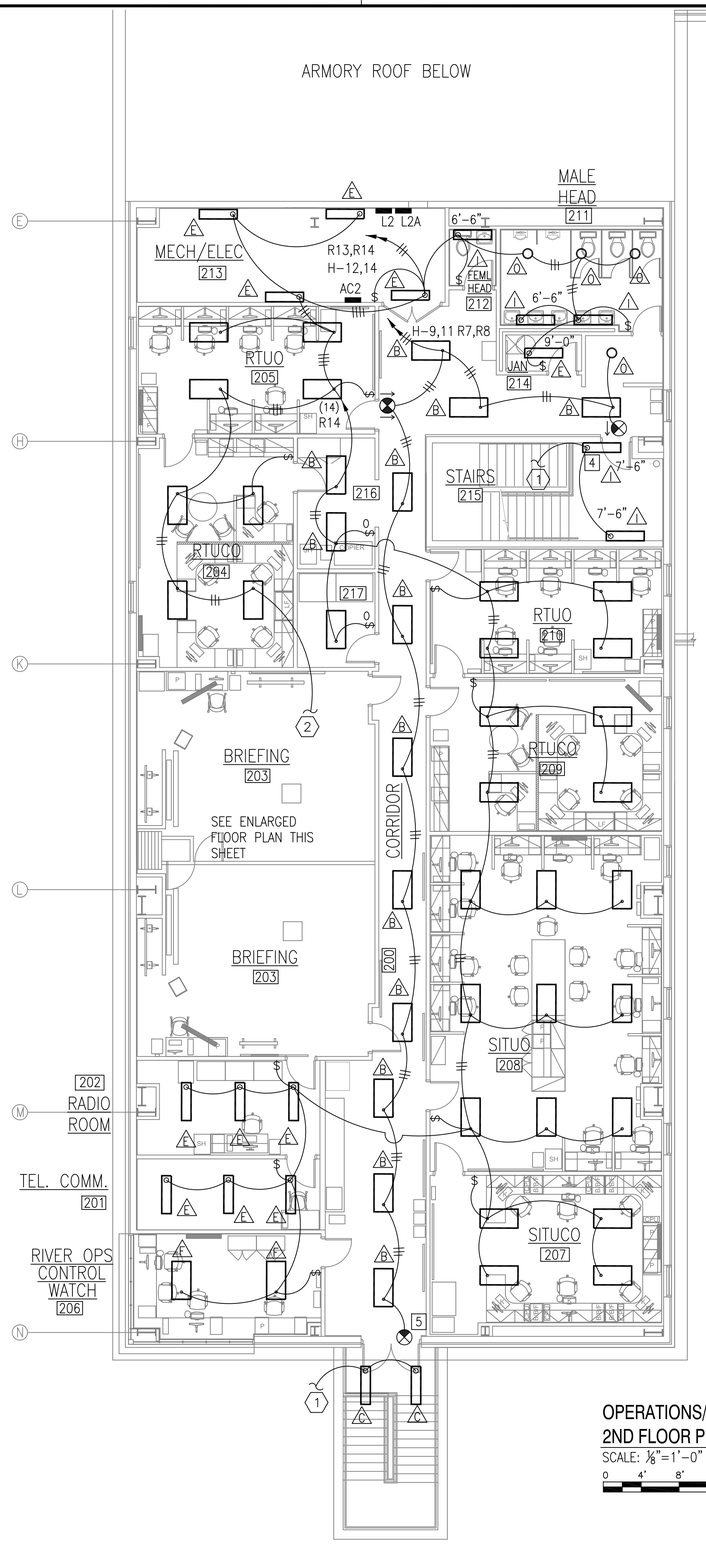

OPERATIONS/MAINTENANCE BLDG 2440/2441
2ND FLOOR PLAN - LIGHTING
SCALE: $\frac{1}{8}$"=1'-0"
0 4' 8' 16'

PLAN NORTH

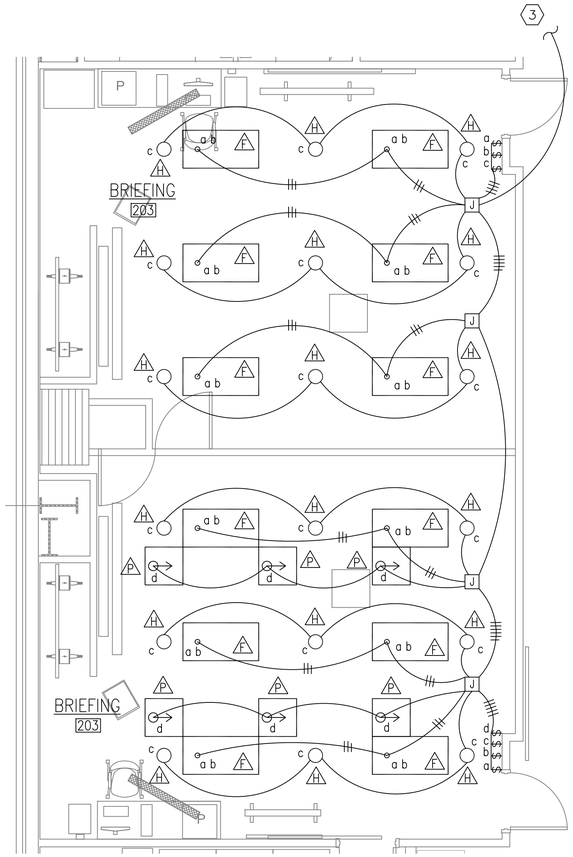

ENLARGED FLOR PLAN - BRIEFING ROOM 203
LIGHTING
SCALE: $\frac{1}{4}$"=1'-0"
0 2' 4' 8'

PLAN NORTH

GENERAL NOTES THIS SHEET:

1. ALL FIXTURES TYPE A UNLESS NOTED OTHERWISE.
2. ALL WIRING SHALL BE 3/4"C: 2-#12 AWG AND 1-#12 GRD UNLESS NOTED OTHERWISE.
3. ALL CONDUIT SHALL CONTAIN MINIMUM #12 AWG GROUND WIRE UNLESS NOTED OTHERWISE.
4. MOUNT TYPE E FIXTURES IN MECH/ELEC 213 AT 10'-0" AFF.
5. IN BRIEFING ROOM 203, PROVIDE THE FOLLOWING LIGHT SWITCHES:

   $_a$ 20A, 1P, TOGGLE

   $_b$ 20A, 1P, TOGGLE

   $_c$ 20A, 1P, DIMMER FOR MARK 10 POWERLINE BALLAST

   $_d$ 20A, 1P, TOGGLE

SPECIFIC NOTES THIS SHEET:

(1) CONTINUE TO FIRST FLOOR STAIRWAY LIGHT FIXTURES.

(2) SEE ENLARGED PLAN THIS SHEET FOR CONTINUATION.

(3) CONTINUE TO ROOM 204.

RECORD DRAWING
LETTER DATED
5-27-10

AS-BUILT REVISIONS

DESCRIPTION	DATE	APPR
	5-27-10	

NAVFAC

SCHLAFLY ENGINEERING LLC
121 SOUTH GENOIS STREET
NEW ORLEANS LA 70119
PHONE 504-415-3347
FAX 504-482-7943
M. KIMBALL SCHLAFLY, P.E.
LA REG 27699

SEPTEMBER 4, 2009

STATE OF LOUISIANA
M. KIMBALL SCHLAFLY
REG. No. 27699
REGISTERED PROFESSIONAL ENGINEER
IN
ELECTRICAL ENGINEERING
SEAL

DES: K. SCHLAFLY | DRW: K. SCHLAFLY
REVIEWED BY: R. WILTSE
PM/DM: T. ARTRIP
CHIEF ENG/ARCH: P. DAMMON

DEPARTMENT OF THE NAVY
NAVAL FACILITIES ENGINEERING COMMAND SOUTHEAST
IPT SOUTH ATLANTIC
NAVAL FACILITIES ENGINEERING COMMAND
NAVAL AIR STATION JACKSONVILLE
JOHN C. STENNIS SPACE CENTER
MISSISSIPPI

SOF RIVERINE AND COMBATANT CRAFT OPERATIONS FACILITY

BLDG 2440 2ND FLOOR PLAN - LIGHTING

CODE ID. NO. N4412	SIZE D
SCALE:	AS SHOWN
MAXIMO NO,	######
STA. PROJ. NO.	P-210
WORK ORDER NO.	510247
CONSTR. CONTR. NO.	N62467-05-D-0096
NAVFAC DRAWING NO.	15026758
SHEET	111 OF 132

E3.2

DRAWFORM REVISION: 01 JAN 2009

REV/DATE: FILE NAME: C:\Schlafly ENGR 08010 SOF Riverine Drawings Elec 5-As-builts E3.1.dwg LAYOUT NAME: E3.2 PLOTTED: Friday, May 28, 2010 - 3:09pm