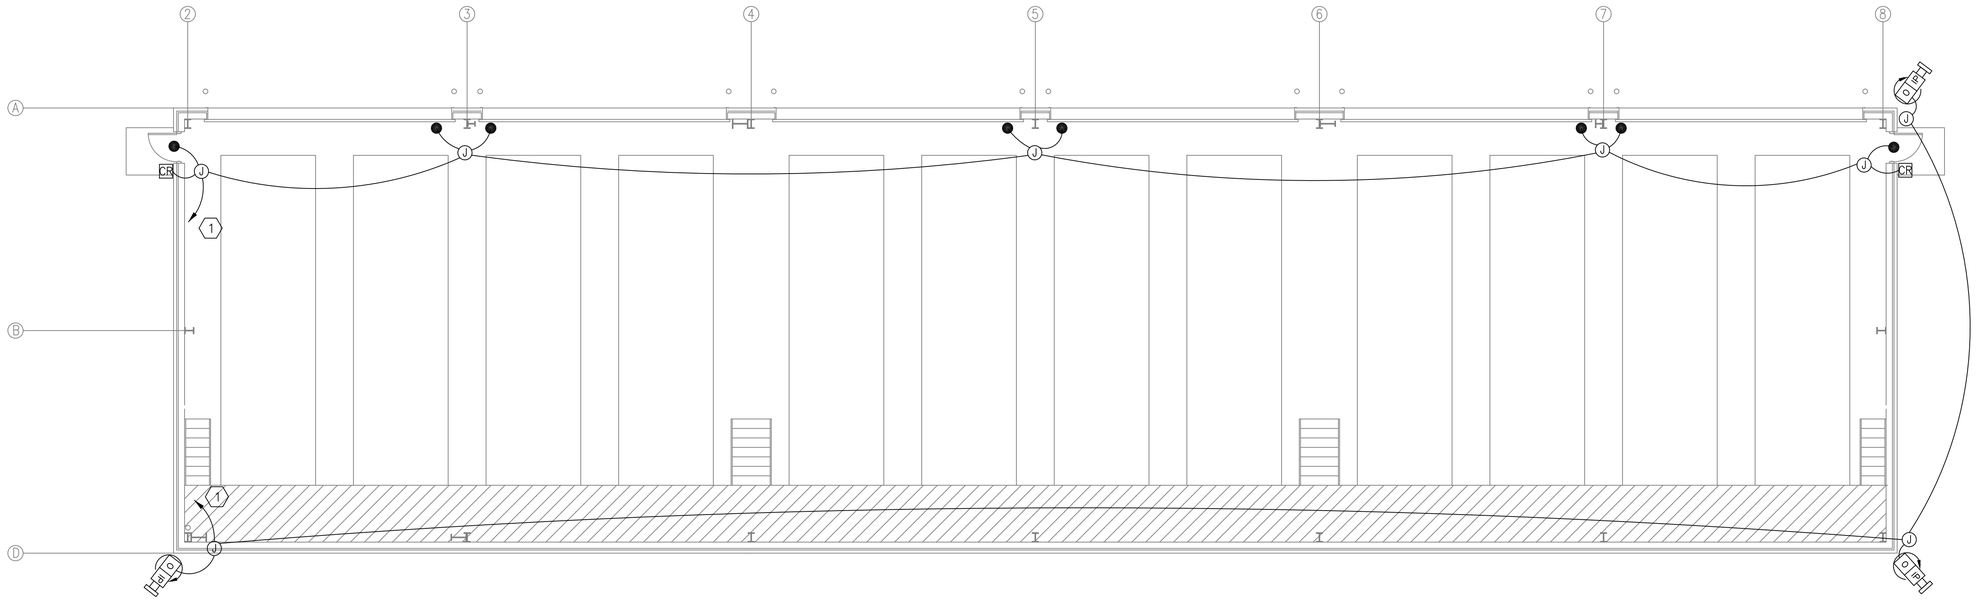

BOAT STORAGE BLDG. 2442
FLOOR PLAN - INTEGRATED SECURITY
SCALE: 1/8"=1'-0"

0 4' 8' 16'

PLAN NORTH

SPECIFIC NOTES THIS SHEET:

(1) ROUTE CONDUIT TO TELECOMMUNICATIONS BOX. REFERENCE INTEGRATED SECURITY DRAWINGS FOR FURTHER INFORMATION.

RECORD DRAWING
LETTER DATED
5-27-10

AS-BUILT REVISIONS	DESCRIPTION	DATE	APPR
		5-27-10	

NAVFAC

SCHLAFLY ENGINEERING LLC
121 SOUTH GENOIS STREET
NEW ORLEANS LA 70119
PHONE 504-415-3347
FAX 504-482-7943

M. KIMBALL SCHLAFLY, P.E.
LA REG 27699

SEPTEMBER 4, 2009

STATE OF LOUISIANA
M. KIMBALL SCHLAFLY
REG. No. 27699
REGISTERED PROFESSIONAL ENGINEER
IN
ELECTRICAL ENGINEERING
SEAL

DES: K. SCHLAFLY | DRW: K. SCHLAFLY
REVIEWED BY: R. WILTSE
PM/DM: T. ARTRIP
CHIEF ENG/ARCH: P. DAMMON

DEPARTMENT OF THE NAVY
NAVAL FACILITIES ENGINEERING COMMAND
IPT SOUTH ATLANTIC
JOHN C. STENNIS SPACE CENTER
NAVAL FACILITIES ENGINEERING COMMAND SOUTHEAST
NAVAL AIR STATION JACKSONVILLE
MISSISSIPPI

SOF RIVERINE AND COMBATANT CRAFT OPERATIONS FACILITY

BLDG. 2442 FLOOR PLAN - SECURITY

CODE ID. NO. N4412	SIZE D
SCALE:	1/8"=1'-0"
MAXIMO NO,	######
STA. PROJ. NO.	P-210
WORK ORDER NO.	510247
CONSTR. CONTR. NO.	N62467-05-D-0096
NAVFAC DRAWING NO.	15026769
SHEET	122 OF 132

E6.3

DRAWFORM REVISION: 01 JAN 2009

REVDATE: FILE NAME: C:\Schlafly ENGR 08010 SOF Riverine Drawings Elec 5-As-builts E6.1.dwg LAYOUT NAME: E6.3 PLOTTED: Friday, May 28, 2010 - 3:33pm