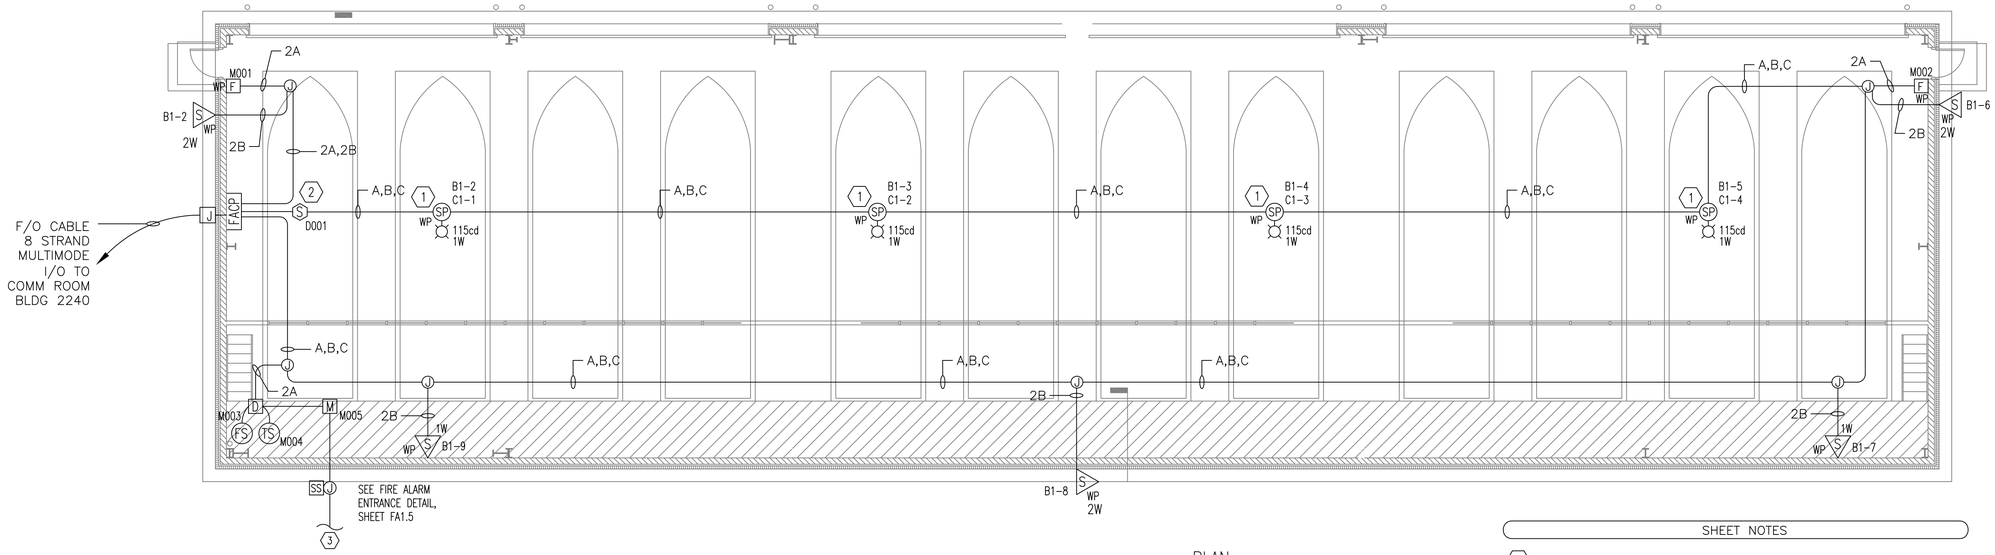

PLAN NORTH

BOAT STORAGE BLDG. 2442
FLOOR PLAN - FIRE ALARM

SCALE: ⅛"=1'-0"

0 4' 8' 16'

SHEET NOTES

1. MOUNT CEILING MOUNTED SPEAKERS ON BOTTOM OF 8" BEAM 22' A.F.F.
2. MOUNT SMOKE DETECTOR FOR FACP ON THE WALL ABOVE AND WITHIN 6 FEET FROM THE TOP OF THE CONTROL UNIT. (NFPA 72 2007, A.4.4.5(2))
3. ROUTE CONDUIT TO PIV. SEE FIRE ALARM SITE PLAN, SHEET FA1.4 FOR EXACT LOCATION.

BLDG 2442 SPEAKER WATTAGE CALCULATION
DAA-5025

SPEAKER CIRCUIT B1:
6@1W = 6W
3@2W = 6W
TOTAL = 12W

TOTAL = 12W
50W AVAILABLE, 76% SPARE CAPACITY

NICET CERTIFICATION
LARRY K. COOK
LEVEL IV / CERTIFICATION #75228
FIRE ALARM PROTECTION / FIRE ALARM SYS
EXPIRATION DATE: MARCH 01,2011

AS-BUILT
6-4-2010

APPR	DATE	DESCRIPTION	SYM
	2/26/2010	REVISED PER URS AND NAVFAC COMMENTS	

NAVFAC

SEAL

DES:	DRW:
REVIEWED BY: R. WILTSE	
PM/DM: T. ARTRIP	
CHIEF ENG/ARCH: P. DAMMON	

DEPARTMENT OF THE NAVY
NAVAL FACILITIES ENGINEERING COMMAND SOUTHEAST
NAVAL FACILITIES ENGINEERING COMMAND
NAVAL AIR STATION JACKSONVILLE
LPT SOUTH ATLANTIC
JOHN C. STENNIS SPACE CENTER
MISSISSIPPI

SOF RIVERINE AND COMBATANT CRAFT OPERATIONS FACILITY

BLDG. 2442 FLOOR PLAN - FIRE ALARM

CODE ID. NO. N4412	SIZE D
SCALE:	1/8"=1'-0"
MAXIMO NO.	######
STA. PROJ. NO.	P-210
WORK ORDER NO.	510247
CONSTR. CONTR. NO.	N62467-05-D-0096
NAVFAC DRAWING NO.	######-##-#-####
SHEET	XXX OF XXX

FA1.3

DRAWFORM REVISION: 01 JAN 2009

REVDATE: FILE NAME: C:\Schlafly ENGR\08010 SOF Riverine\Drawings\Elec\5-As-builts\ACC\10-06-04\FAS Drawings as-builts.dwg LAYOUT NAME: FA1.3 PLOTTED: Wednesday, June 09, 2010 - 1:03pm