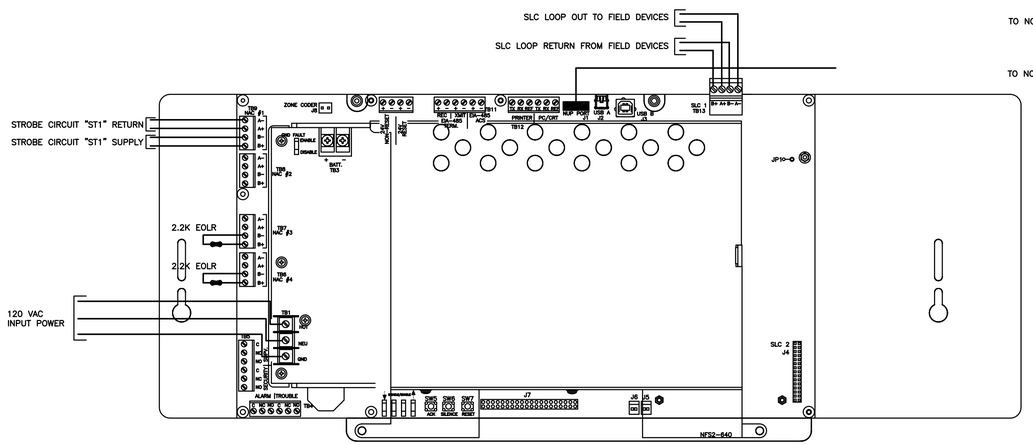

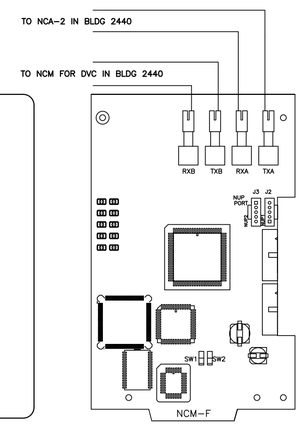

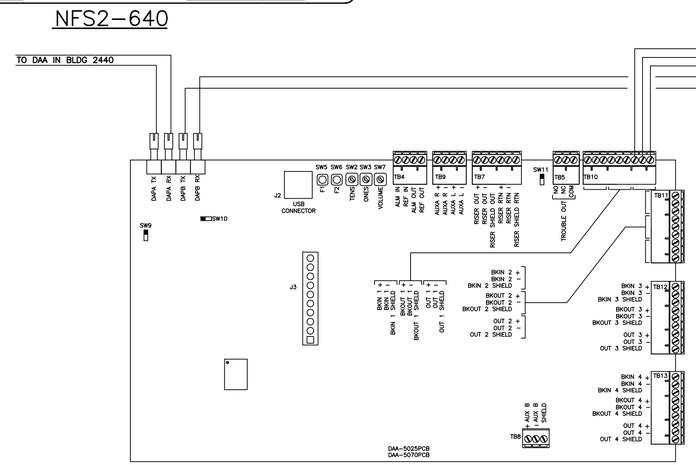

DAA-5025
(BACKUP AMPLIFIER)

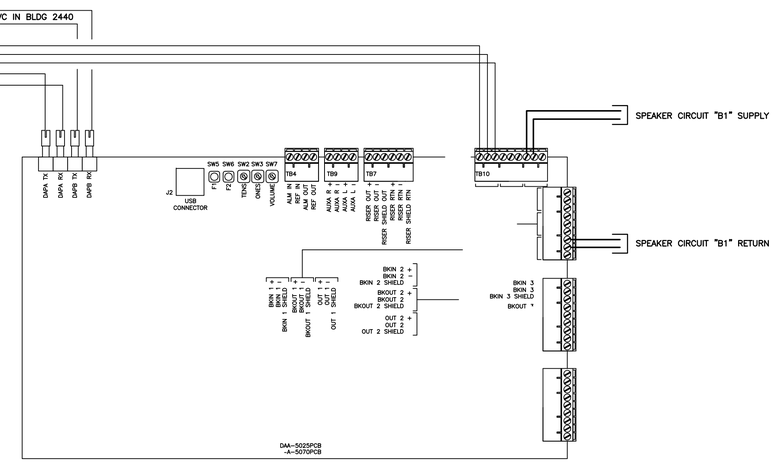

DAA-5025
(PRIMARY AMPLIFIER)

1 FA1.8 FA1.8 BLDG 2442 FACP WIRING DIAGRAM
SCALE: NOT TO SCALE

NICET CERTIFICATION
LARRY K. COOK
LEVEL IV / CERTIFICATION #75228
FIRE ALARM PROTECTION / FIRE ALARM SYS
EXPIRATION DATE: MARCH 01,2011

AS-BUILT
6-4-2010

SYM	DESCRIPTION	DATE	APPR
	REVISED PER URS AND NAVFAC COMMENTS	2/26/2010	

SEAL

DES: | DRW:
REVIEWED BY: R. WILTSE
PM/DM: T. ARTRIP
CHIEF ENG/ARCH: P. DAMMON

DEPARTMENT OF THE NAVY
NAVAL FACILITIES ENGINEERING COMMAND
IPT SOUTH ATLANTIC
NAVAL FACILITIES ENGINEERING COMMAND SOUTHEAST
NAVAL AIR STATION JACKSONVILLE
JOHN C. STENNIS SPACE CENTER MISSISSIPPI
SOF RIVERINE AND COMBATANT CRAFT OPERATIONS FACILITY
FIRE ALARM DEVICE CONNECTION DETAILS

CODE ID. NO. N4412	SIZE D
SCALE:	1/8"=1'-0"
MAXIMO NO.	######
STA. PROJ. NO.	P-210
WORK ORDER NO.	510247
CONSTR. CONTR. NO.	N62467-05-D-0096
NAVFAC DRAWING NO.	######-##-#-####
SHEET	XXX OF XXX

FA1.8

DRAWFORM REVISION: 01 JAN 2009

REVDATE: FILE NAME: C:\Schlafly ENGR\38010 SOF Riverine\Drawings\Elec\5-As-builts\ACC\10-06-04\FAS Drawings as-builts.dwg LAYOUT NAME: FA1.8 PLOTTED: Wednesday, June 09, 2010 - 1:01pm