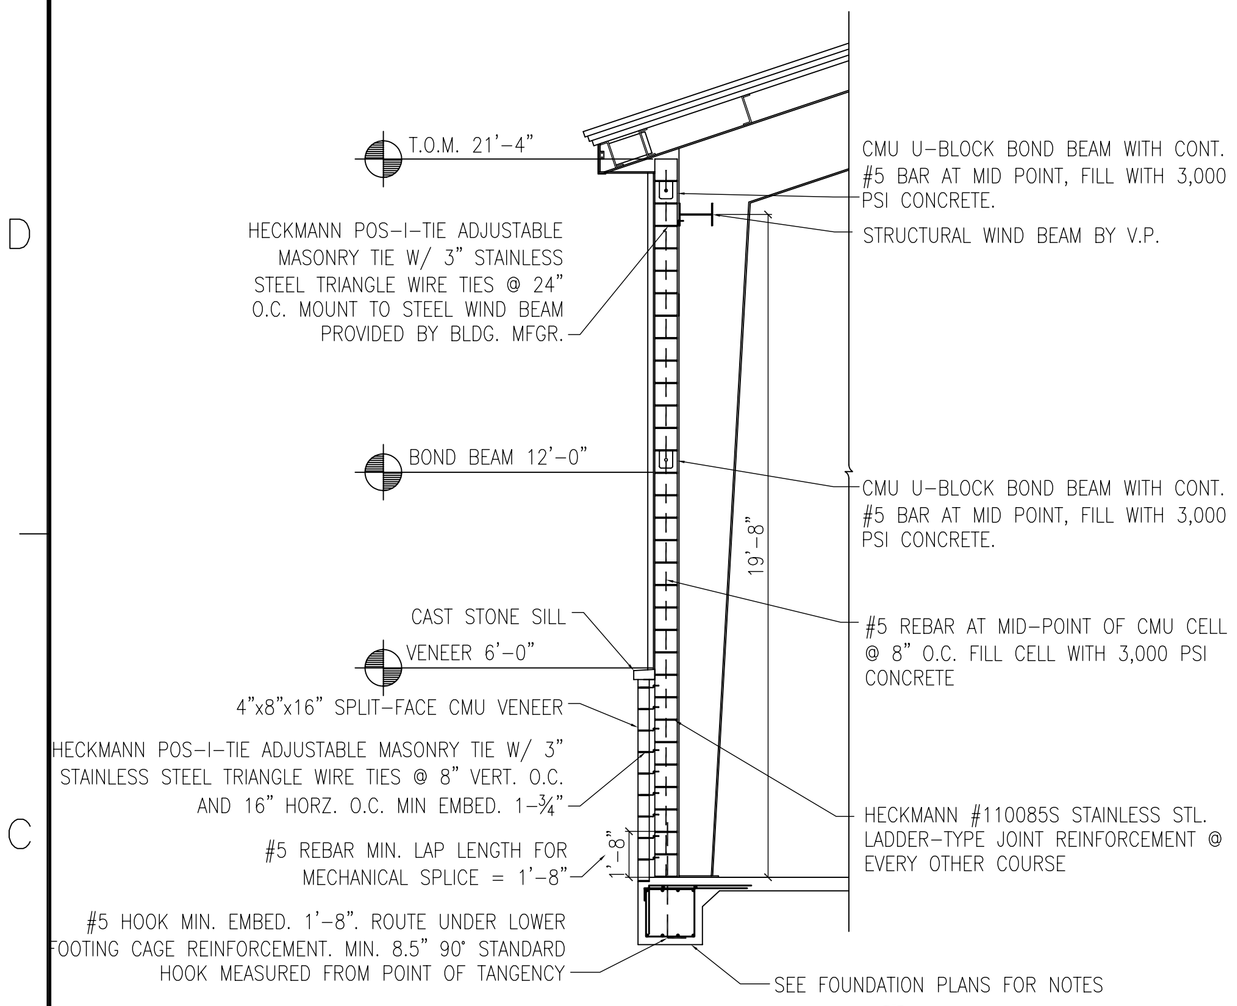

SECTION W / S3.2
SCALE: N.T.S.

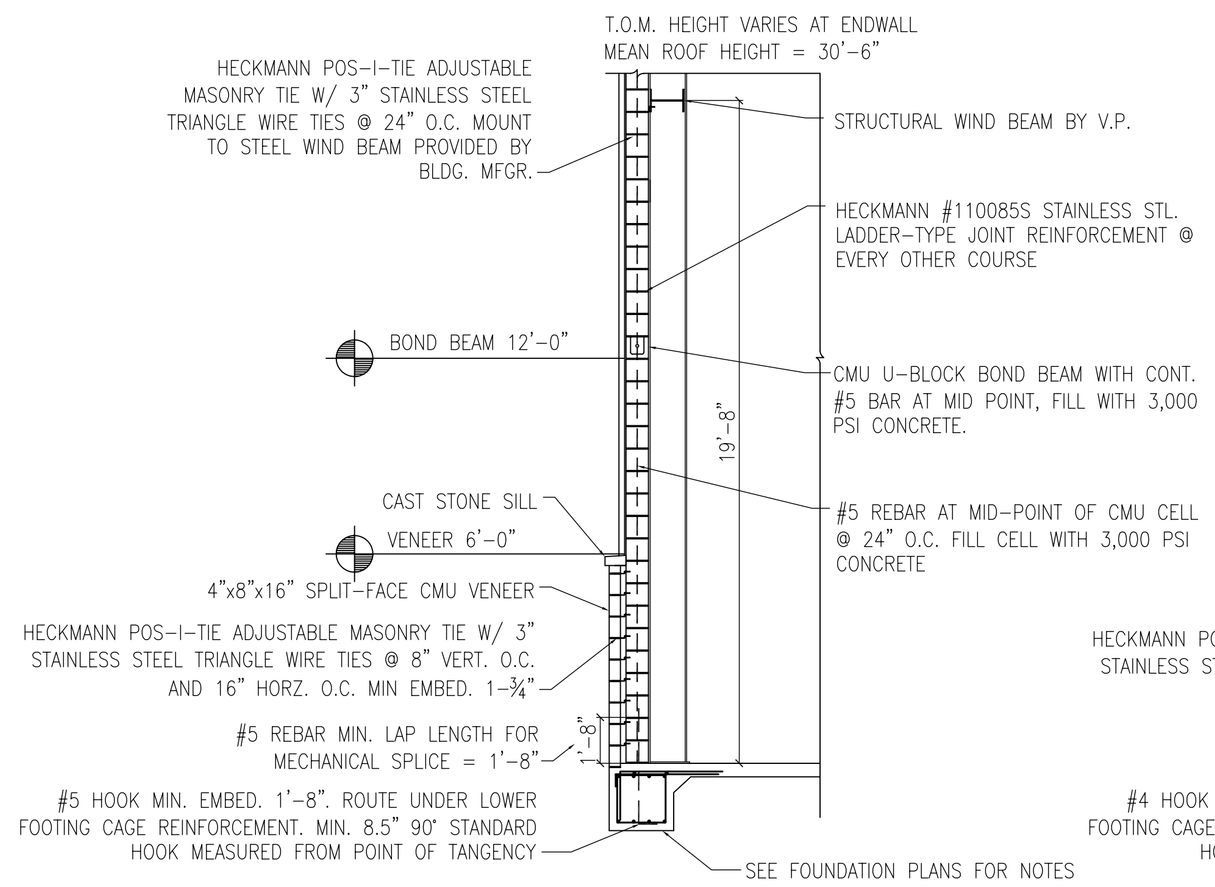

SECTION X / S3.2
SCALE: N.T.S.

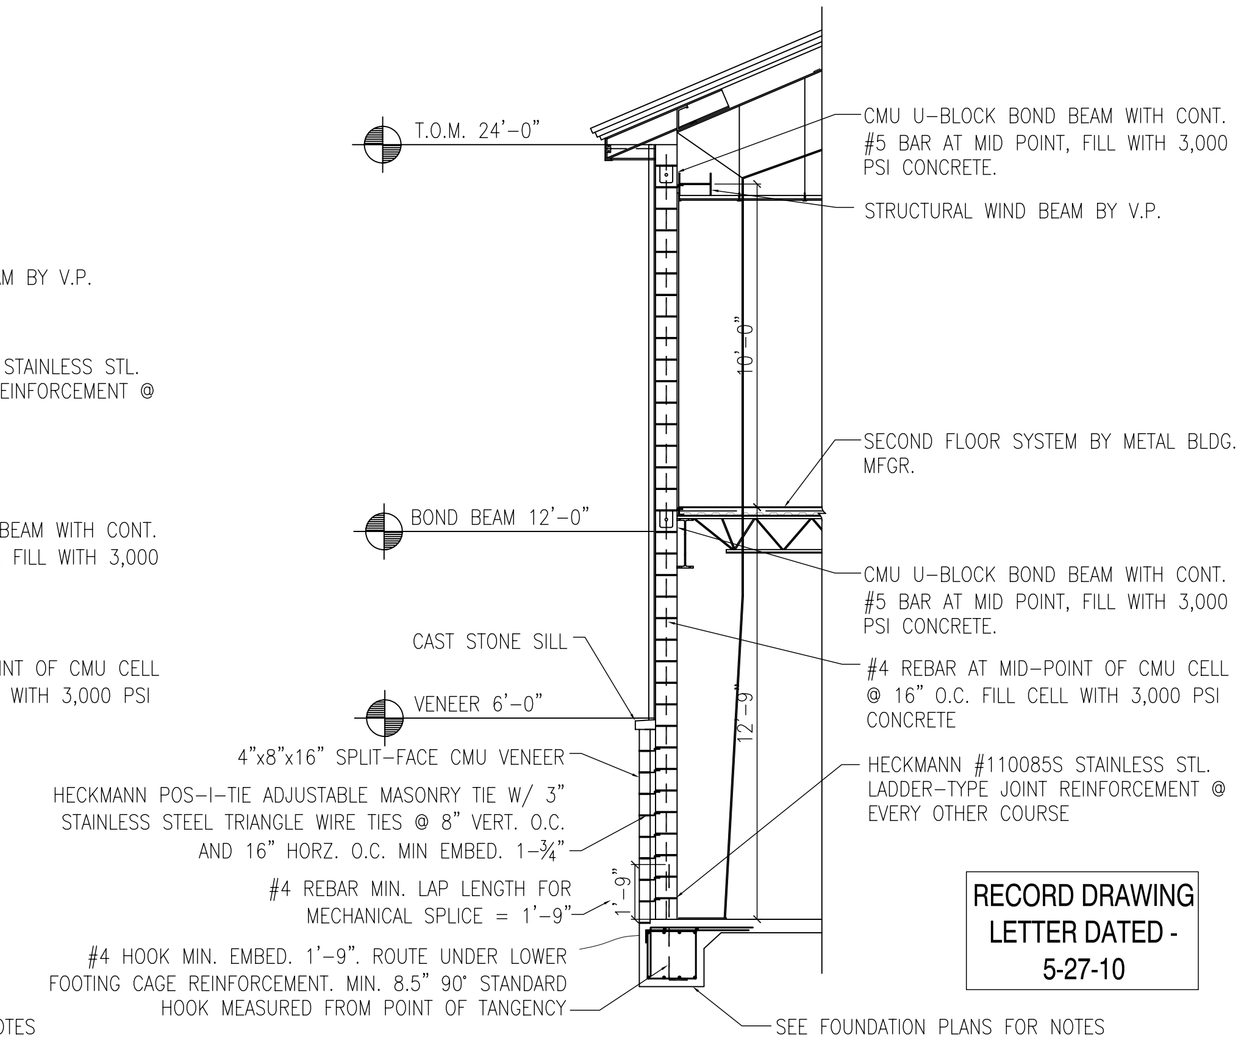

SECTION Y / S3.2
SCALE: N.T.S.

RECORD DRAWING
LETTER DATED -
5-27-10

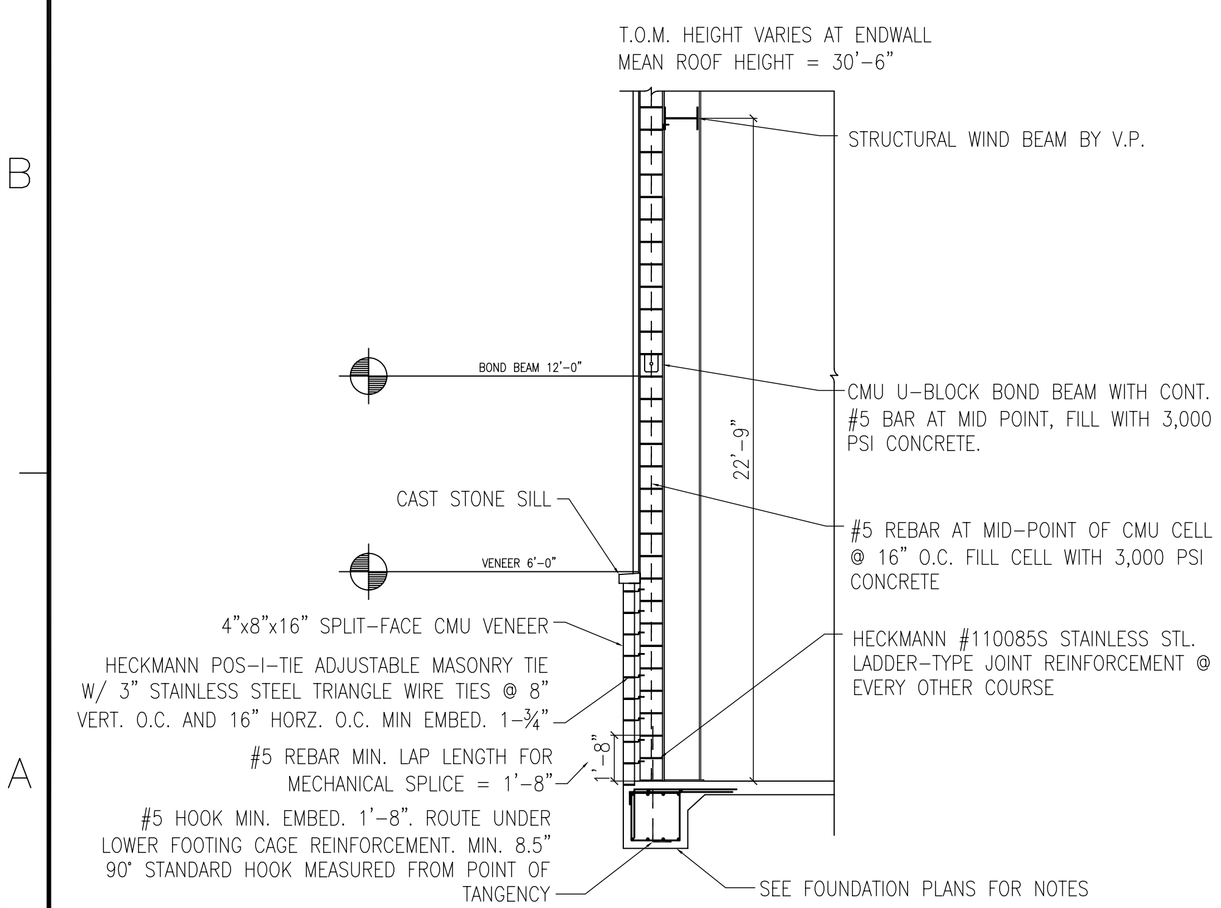

SECTION Z / S3.2
SCALE: N.T.S.

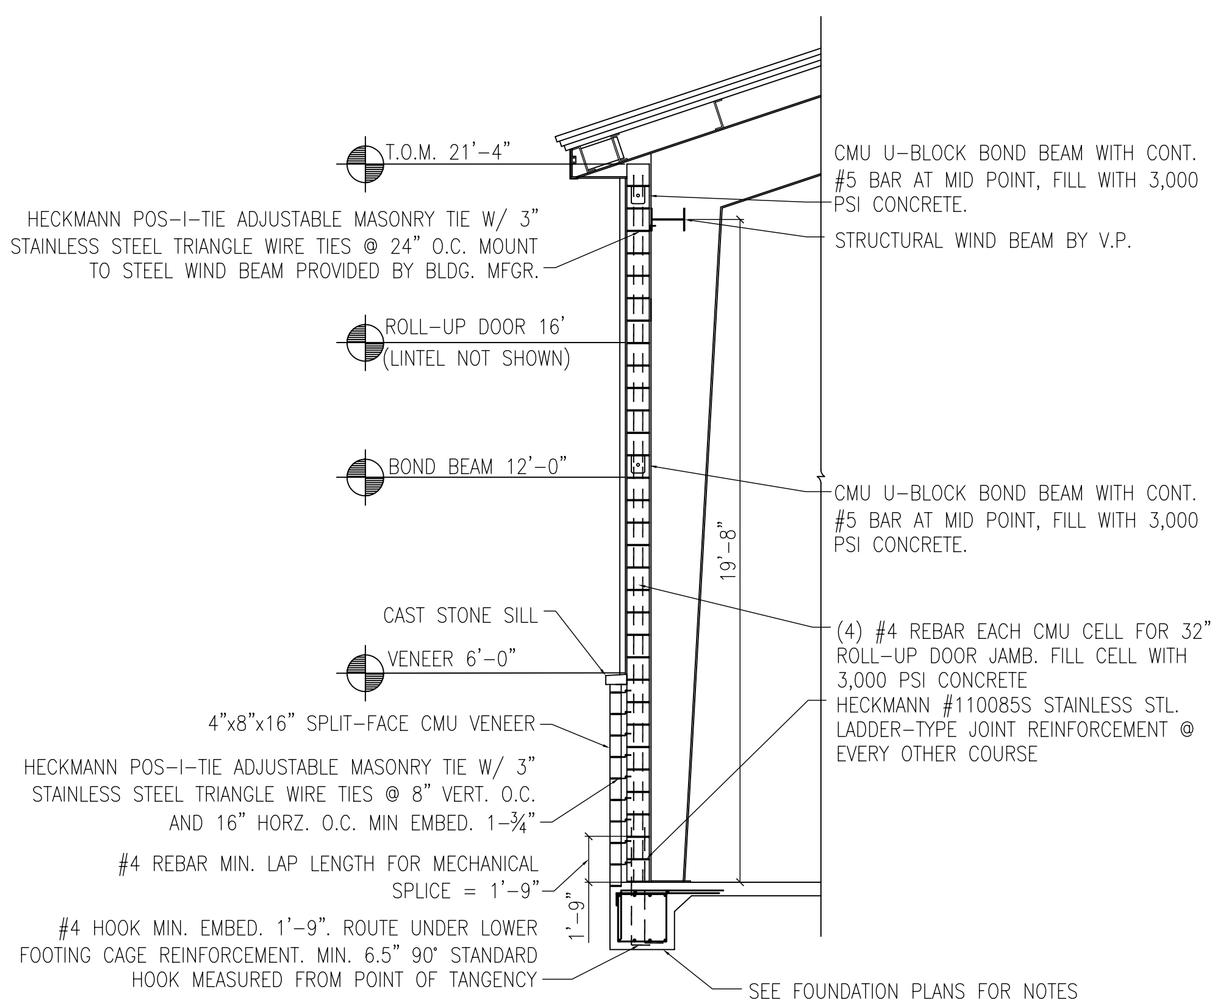

SECTION AA / S3.2
SCALE: N.T.S.

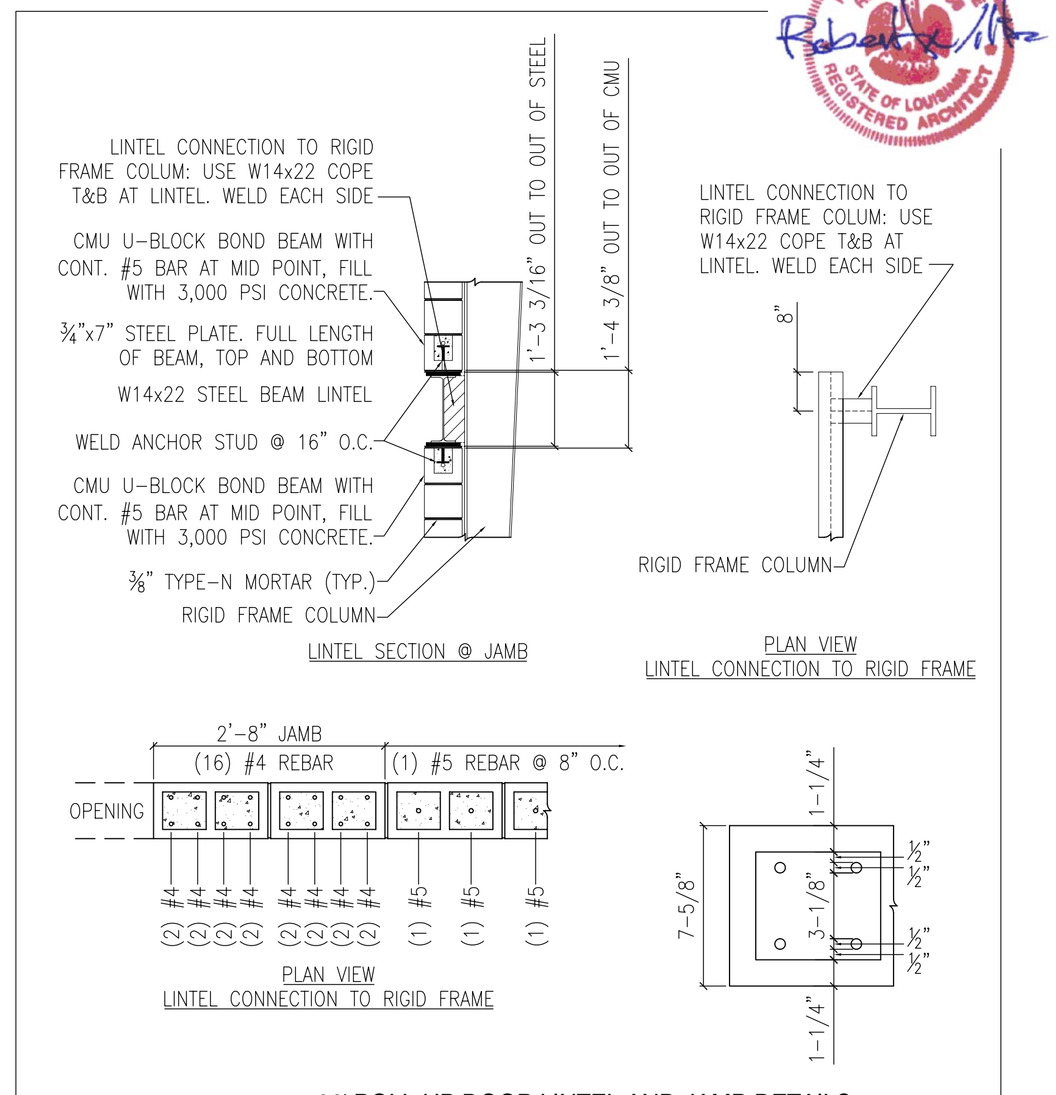

26' ROLL-UP DOOR LINTEL AND JAMB DETAILS

SCALE: N.T.S.

SYM	AS-BUILT DESCRIPTION	DATE	APPR
		4-27-10	RW

NAVFAC

DAMMON ENGINEERING, INC.
CHIEF ENGINEER EMMETT DAMMON, P.E. — CHIEF ARCHITECT ROBERT WILTSE
1095 FLORIDA AVENUE
SLIDELL, LA 70458
(985) 649-5832
SEPTEMBER 4, 2009

ROBERT LEE WILTSE REG. NO. 2736 STATE OF LOUISIANA REGISTERED ARCHITECT

EMMETT G. DAMMON LICENSED PROFESSIONAL ENGINEER 9652 STATE OF MISSISSIPPI

DES: R. WILTSE | DRW: J. TIFFANY
REVIEWED BY: R. WILTSE
PM/DM: T. ARTRIP
CHIEF ENG/ARCH: P. DAMMON

DEPARTMENT OF THE NAVY
NAVAL FACILITIES ENGINEERING COMMAND SOUTHEAST
NAVAL FACILITIES ENGINEERING COMMAND
NAVAL AIR STATION JACKSONVILLE
JOHN C. STENNIS SPACE CENTER MISSISSIPPI
PT GULF COAST

SOF RIVERINE AND COMBATANT CRAFT OPERATIONS FACILITY - PRE-FINAL

BLDG. 2440 / 2441 MASONRY DETAILS

CODE ID. NO. N4412 | SIZE D
SCALE: AS SHOWN
MAXIMO NO. #####
STA. PROJ. NO. P-210
WORK ORDER NO. 510247
CONSTR. CONTR. NO. N62467-05-D-0096
NAVFAC DRAWING NO. 15026726
SHEET 79 OF 132

S3.3

DRAWFORM REVISION: 01 JAN 2009

REVDATE: