Covering Schedule

Id	Qty	Type	Length	Gage	OP	Fin.	Color	Direction
#1	11	FP12	TBD	22	1	A	TBD	Left to Right
#2	11	FP12	TBD	22	1	A	TBD	Left to Right
#3	14	FP12	TBD	22	1	A	TBD	Left to Right
#4	3	FP12	TBD	22	1	A	TBD	Left to Right
#5	3	FP12	TBD	22	1	A	TBD	Left to Right
#6	27	FP12	TBD	22	1	A	TBD	Left to Right
#7	2	FP12	TBD	22	1	A	TBD	Left to Right
#8	2	FP12	TBD	22	1	A	TBD	Left to Right

Oper. Code:1=SQ,SQ
Finish:A=AEP
Color:TBD=To Be Determined
NOTE: Panels to be FIELD SLOPE CUT

Trim Schedule

Id	Parts	Color	Details
T1	HEADER TRIM	TBD	WC24A2(Similar)
T2	SILL TRIM	TBD	See pg.
T3	CORNER TRIM	TBD	See pg.
T4	PURLIN CLOSURES & TRIM	TBD	RC80A2,RC80A3,RC80C1,RC80C4,RC80D4,WC12A1(Similar)
T5	JAMB TRIM	TBD	WC24A1(Similar)
T6	BOTTOM OF PANEL FLASHING	TBD	

1

8

PLEASE VERIFY
1. Panel color
2. Trim color

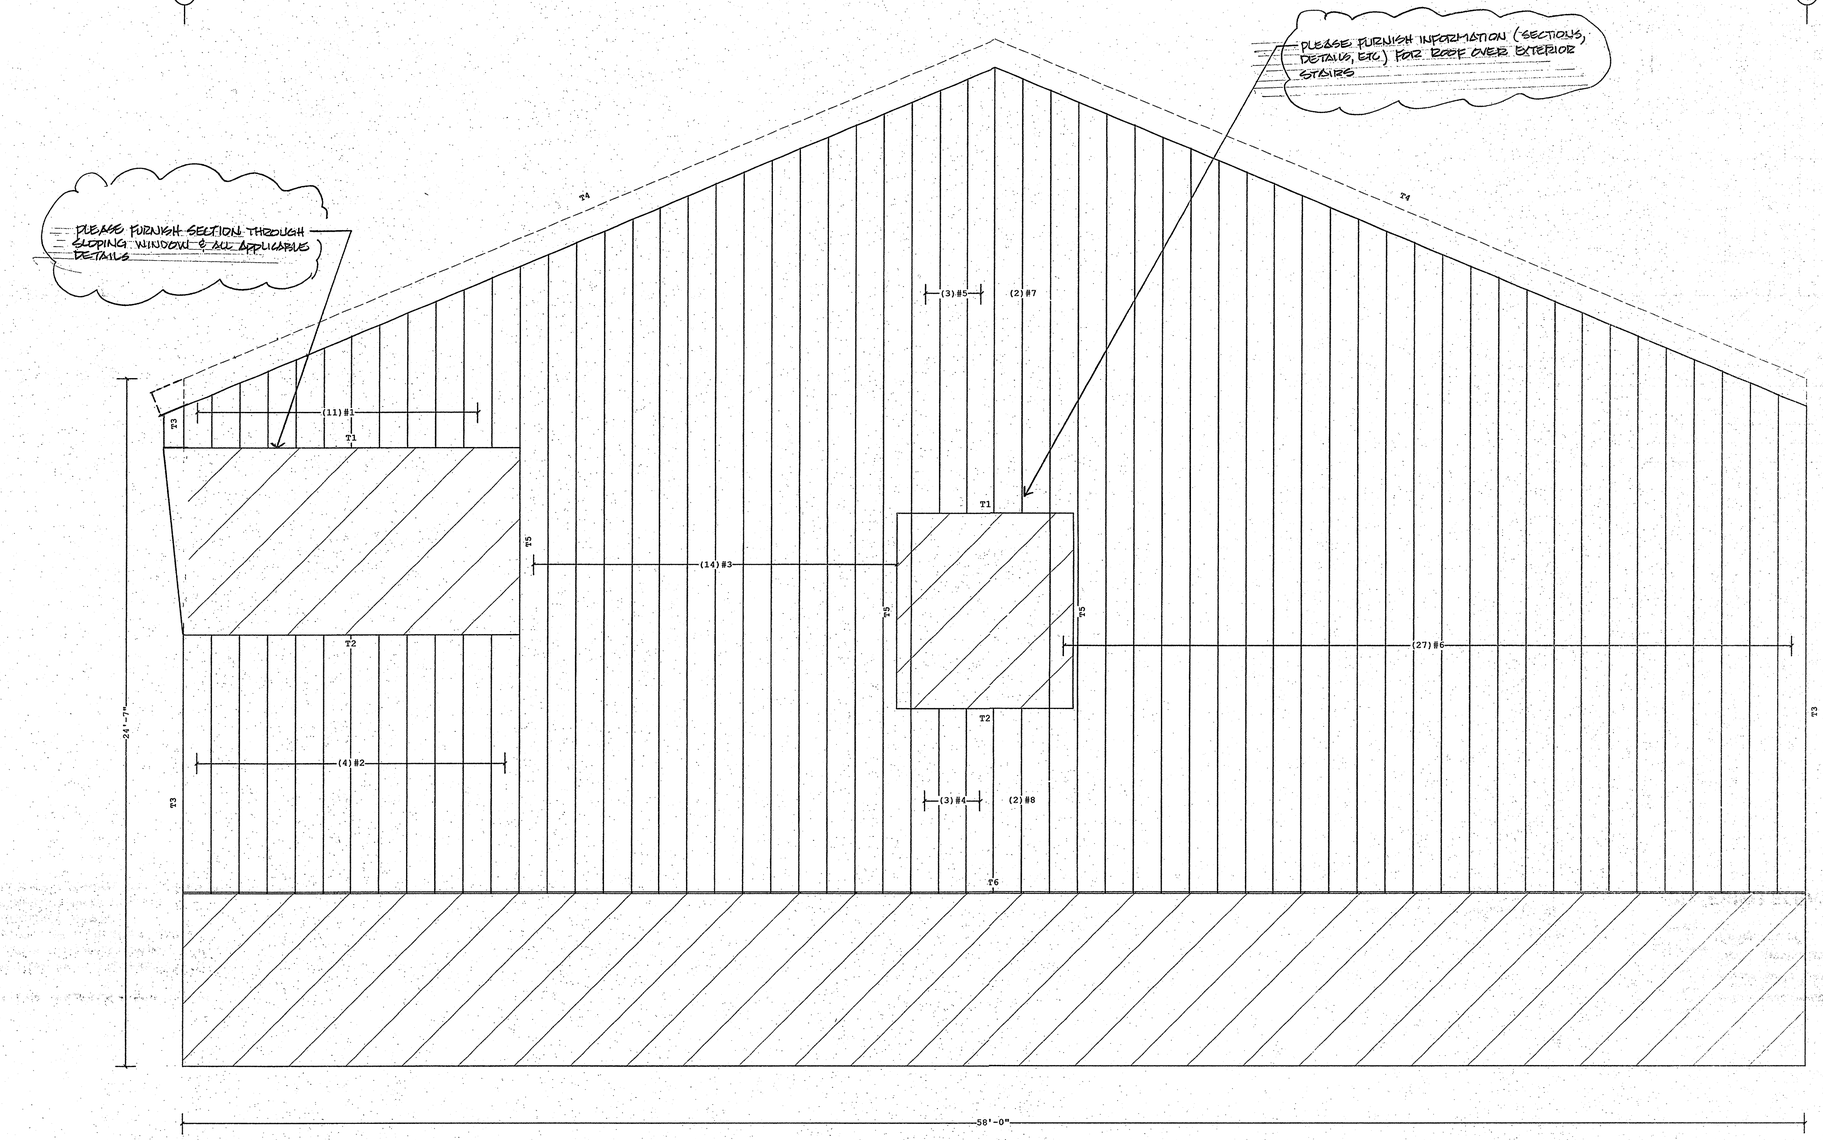

COVERING ELEVATION AT O

Shape Name = Operations Building, Wall = 1

1. PRE-DRILLING 1/8 DIAMETER HOLES FOR WALL STRUCTURAL FASTENERS MAY BE REQUIRED AT 11 GAGE GIRTS, NESTED GIRTS, GIRT LAP LOCATIONS, AND/OR SECONDARY STRUCTURAL BEAMS
2. WALL SHEETS ARE AN INTEGRAL PART OF THE STRUCTURAL SYSTEM, REMOVAL OR ALTERATION WITHOUT PRIOR AUTHORIZATION IS PROHIBITED.
3. PANELS SHOWN WITH A LENGTH LESS THAN 1-0, 5-0 FOR SSR, MAY HAVE TO BE FIELD CUT.
4. SEE JOB DETAILS FOR SHEETING AND TRIM FASTENER SPECIFICATION.

THE VP ENGINEER'S SEAL APPLIES ONLY TO THE WORK PRODUCT OF VP AND DESIGN AND PERFORMANCE REQUIREMENTS SPECIFIED BY VP. THE VP ENGINEER'S SEAL DOES NOT APPLY TO THE PERFORMANCE OR DESIGN OF ANY OTHER PRODUCT OR COMPONENT FURNISHED BY VP EXCEPT TO ANY DESIGN OR PERFORMANCE REQUIREMENTS SPECIFIED BY VP.

THIS DRAWING, INCLUDING THE INFORMATION HEREON, REMAINS THE PROPERTY OF VP BUILDINGS.
IT IS PROVIDED SOLELY FOR ERECTING THE BUILDING DESCRIBED IN THE APPLICABLE PURCHASE ORDER AND SHALL NOT BE MODIFIED, REPRODUCED OR USED FOR ANY OTHER PURPOSE WITHOUT PRIOR WRITTEN APPROVAL OF VP BUILDINGS.

THE GENERAL CONTRACTOR AND/OR ERECTOR IS SOLELY RESPONSIBLE FOR ACCURATE, GOOD QUALITY WORKMANSHIP IN ERECTING THIS BUILDING IN CONFORMANCE WITH THIS DRAWING, DETAILS REFERENCED IN THIS DRAWING, ALL APPLICABLE VP ERECTION GUIDES, AND INDUSTRY STANDARDS PERTAINING TO PROPER ERECTION, INCLUDING THE CORRECT USE OF TEMPORARY BRACING.

VP Buildings
3200 Players Club Circle Memphis TN 38125

REV	DATE	BY	DESCRIPTION

NTS

COVERING ELEVATION AT O

BUILDER Broadmoor, LLC
CUSTOMER John F. Stennis Space Center
LOCATION Stennis Space Center, Mississippi
PROJECT Riverine and Combatant Craft Operations Facility
BUILDERS PO#

VP BUILDINGS
VARCO PRUDEN
A BlueScope Steel Company
VPC VERSION: 7.10

JOENO 08-26914
DATE 2/12/2009
DRAWNCHECK MMM
PAGE 35