


Covering Schedule  
 Id Qty Type Start Length Gage OP Fin. Color Direction  
 #47 58 FP12 TBD 22 1 A TBD Left to Right  
 Oper. Code:1=SQ,SQ  
 Finish:A=AEP  
 Color:TBD=To Be Determined

Trim Schedule  
 Id Parts Color Details  
 T1 BOTTOM OF PANEL FLASHING TBD RC38F1  
 T2 DOWNSPOUTS TBD See pg.  
 T3 OUTSIDE CORNER TBD WC11A1(Similar),WC11A4(Similar)  
 T4 TOP OF PANEL @ CANOPY TBD

**\*\*PLEASE VERIFY\*\***  
 1. Panel color  
 2. Trim color

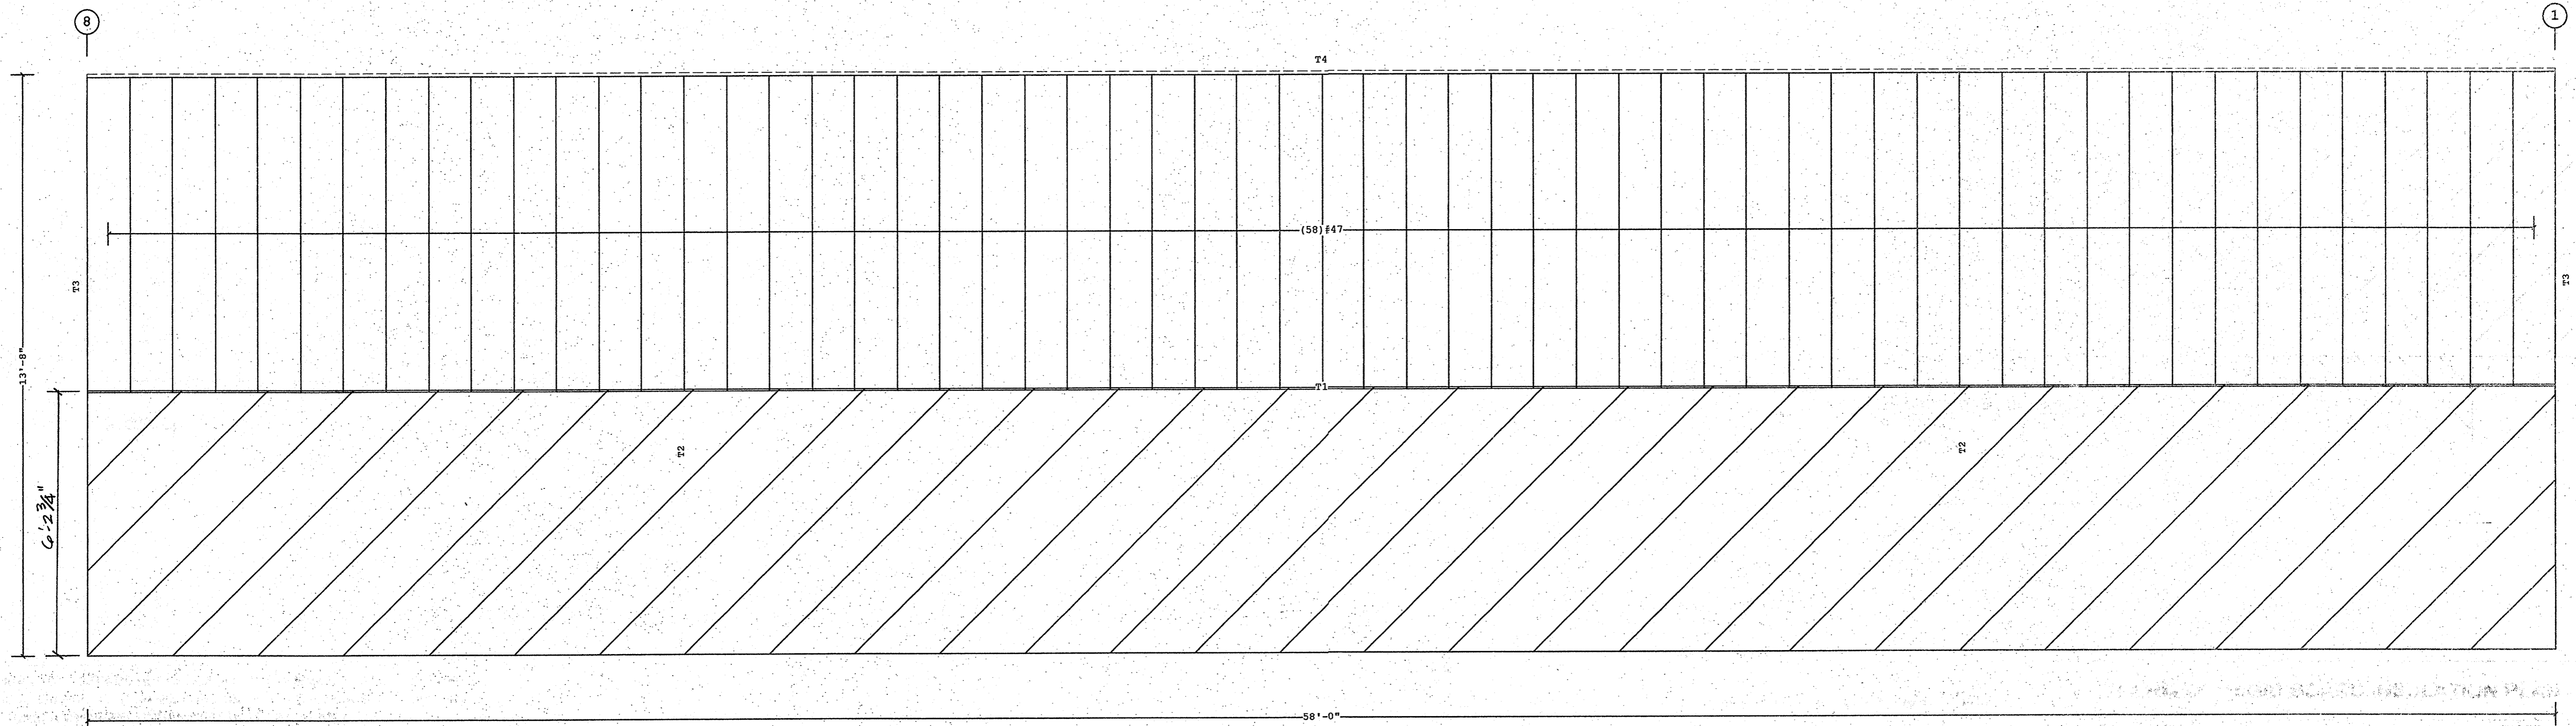

COVERING ELEVATION AT A

Shape Name = Operations Building Lean-to, Wall = 2

- PRE-DRILLING 1/8 DIAMETER HOLES FOR WALL STRUCTURAL FASTENERS MAY BE REQUIRED AT 11 GAGE GIRTS, NESTED GIRTS, GIRT LAP LOCATIONS, AND/OR SECONDARY STRUCTURAL BEAMS
- WALL SHEETS ARE AN INTEGRAL PART OF THE STRUCTURAL SYSTEM. REMOVAL OR ALTERATION WITHOUT PRIOR AUTHORIZATION IS PROHIBITED.
- PANELS SHOWN WITH A LENGTH LESS THAN 1-0, 5-0 FOR SSR, MAY HAVE TO BE FIELD CUT.
- SEE JOB DETAILS FOR SHEETING AND TRIM FASTENER SPECIFICATION.

THE VP ENGINEER'S SEAL APPLIES ONLY TO THE WORK PRODUCT OF VP AND DESIGN AND PERFORMANCE REQUIREMENTS SPECIFIED BY VP. THE VP ENGINEER'S SEAL DOES NOT APPLY TO THE PERFORMANCE OR DESIGN OF ANY OTHER PRODUCT OR COMPONENT FURNISHED BY VP EXCEPT TO ANY DESIGN OR PERFORMANCE REQUIREMENTS SPECIFIED BY VP.


THIS DRAWING, INCLUDING THE INFORMATION HEREON, REMAINS THE PROPERTY OF VP BUILDINGS. IT IS PROVIDED SOLELY FOR ERECTING THE BUILDING DESCRIBED IN THE APPLICABLE PURCHASE ORDER AND SHALL NOT BE MODIFIED, REPRODUCED OR USED FOR ANY OTHER PURPOSE WITHOUT PRIOR WRITTEN APPROVAL OF VP BUILDINGS. THE GENERAL CONTRACTOR AND/OR ERECTOR IS SOLELY RESPONSIBLE FOR ACCURATE, GOOD QUALITY WORKMANSHIP IN ERECTING THIS BUILDING IN CONFORMANCE WITH THIS DRAWING, DETAILS REFERENCED IN THIS DRAWING, ALL APPLICABLE VP ERECTION GUIDES, AND INDUSTRY STANDARDS PERTAINING TO PROPER ERECTION, INCLUDING THE CORRECT USE OF TEMPORARY BRACING.

VP Buildings  
 3200 Players Club Circle Memphis TN 38125

REV	DATE	BY	DESCRIPTION

COVERING ELEVATION AT A - ARMORY(LEAN-TO)

BUILDER	Broadmoor, LLC
CUSTOMER	John F. Stennis Space Center
LOCATION	Stennis Space Center, Mississippi
PROJECT	Riverine and Combatant Craft Operations Facility
BUILDERS PO#	

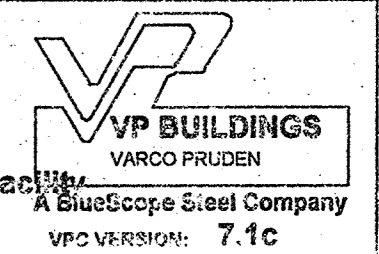

JOB#	03-23314
DATE	2/12/2009
DRAWING CHECK	BWMM
PAGE	39