


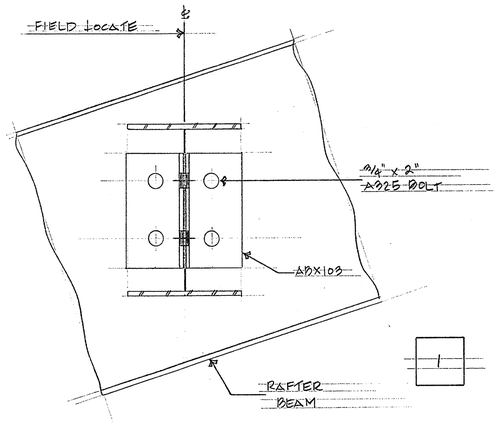


PRIMARY AND ROOF BRACING PLAN

4 SBX114
3 (2)ABX101
2 1'-8"
1 1'-7"
Dimension Key

Shape Name = Operations Building, Shape = Operations Building Lean-to

1. USE 1/2 X 1 1/2 A325 SNUG TIGHTENED BOLTS FOR PURLIN TO FRAME, GIRT TO FRAME, AND GIRT TO CLIP CONNECTIONS UNLESS NOTED OTHERWISE.
2. SLOT REINFORCEMENT PLATES NEED NOT BE LOCATED ON THE SAME SIDE OF THE WEB AS THE HILLSIDE WASHER.

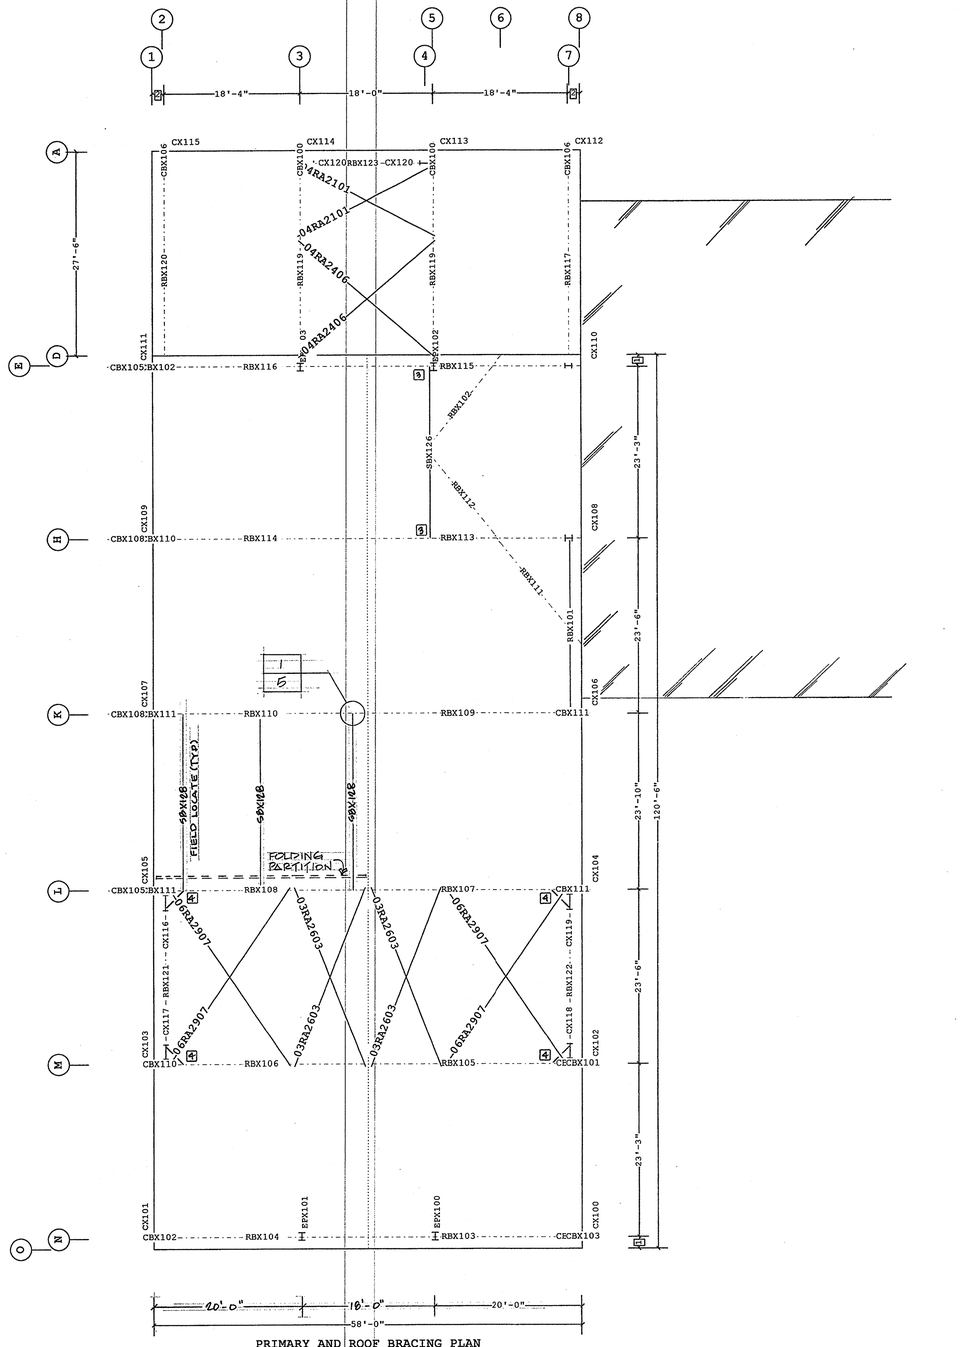THE VP ENGINEER'S SEAL APPLIES ONLY TO THE WORK PRODUCT OF VP AND DESIGN AND PERFORMANCE REQUIREMENTS SPECIFIED BY VP. THE VP ENGINEER'S SEAL DOES NOT APPLY TO THE PERFORMANCE OR DESIGN OF ANY OTHER PRODUCT OR COMPONENT FURNISHED BY VP EXCEPT TO ANY DESIGN OR PERFORMANCE REQUIREMENTS SPECIFIED BY VP.

THIS DRAWING, INCLUDING THE INFORMATION HEREON, REMAINS THE PROPERTY OF VP BUILDINGS.

IT IS PROVIDED SOLELY FOR ERECTING THE BUILDING DESCRIBED IN THE APPLICABLE PURCHASE ORDER AND SHALL NOT BE MODIFIED, REPRODUCED OR USED FOR ANY OTHER PURPOSE WITHOUT PRIOR WRITTEN APPROVAL OF VP BUILDINGS.

THE GENERAL CONTRACTOR AND/OR ERECTOR IS SOLELY RESPONSIBLE FOR ACCURATE, GOOD QUALITY WORKMANSHIP IN ERECTING THIS BUILDING IN CONFORMANCE WITH THIS DRAWING, DETAILS REFERENCED IN THIS DRAWING, ALL APPLICABLE VP ERECTION GUIDES, AND INDUSTRY STANDARDS PERTAINING TO PROPER ERECTION, INCLUDING THE CORRECT USE OF TEMPORARY BRACING.

STEPHEN L. CARD REGISTERED PROFESSIONAL ENGINEER PE. 11895 STATE OF MISSISSIPPI 4/23/09

VP Buildings
3200 Players Club Circle Memphis TN 38125

| REV | DATE | BY | DESCRIPTION |
|---|---|---|---|
| | | | |
| | | | |
| | | | |
| | | | |

NTS

PRIMARY AND ROOF BRACING PLAN

BUILDER Broadmoor, LLC
CUSTOMER John F. Stennis Space Center
LOCATION Stennis Space Center, Mississippi
PROJECT Riverine and Combatant Craft Operations Facility
BUILDERS PO#

VP BUILDINGS VARCO PRUDEN
A BlueScope Steel Company
VSC VERSION: 7.1e

JOBNO 08-28914 EP1
DATE 16 APR 09
DRAWN/CHECK PCD
PAGE 5 OF 8