


20' Deep

A - N 00°07'00" W 1637.02'  
(T - N 00°41'49" W 1637.02')

Walkway around Pond  
↓

24' wide Drive

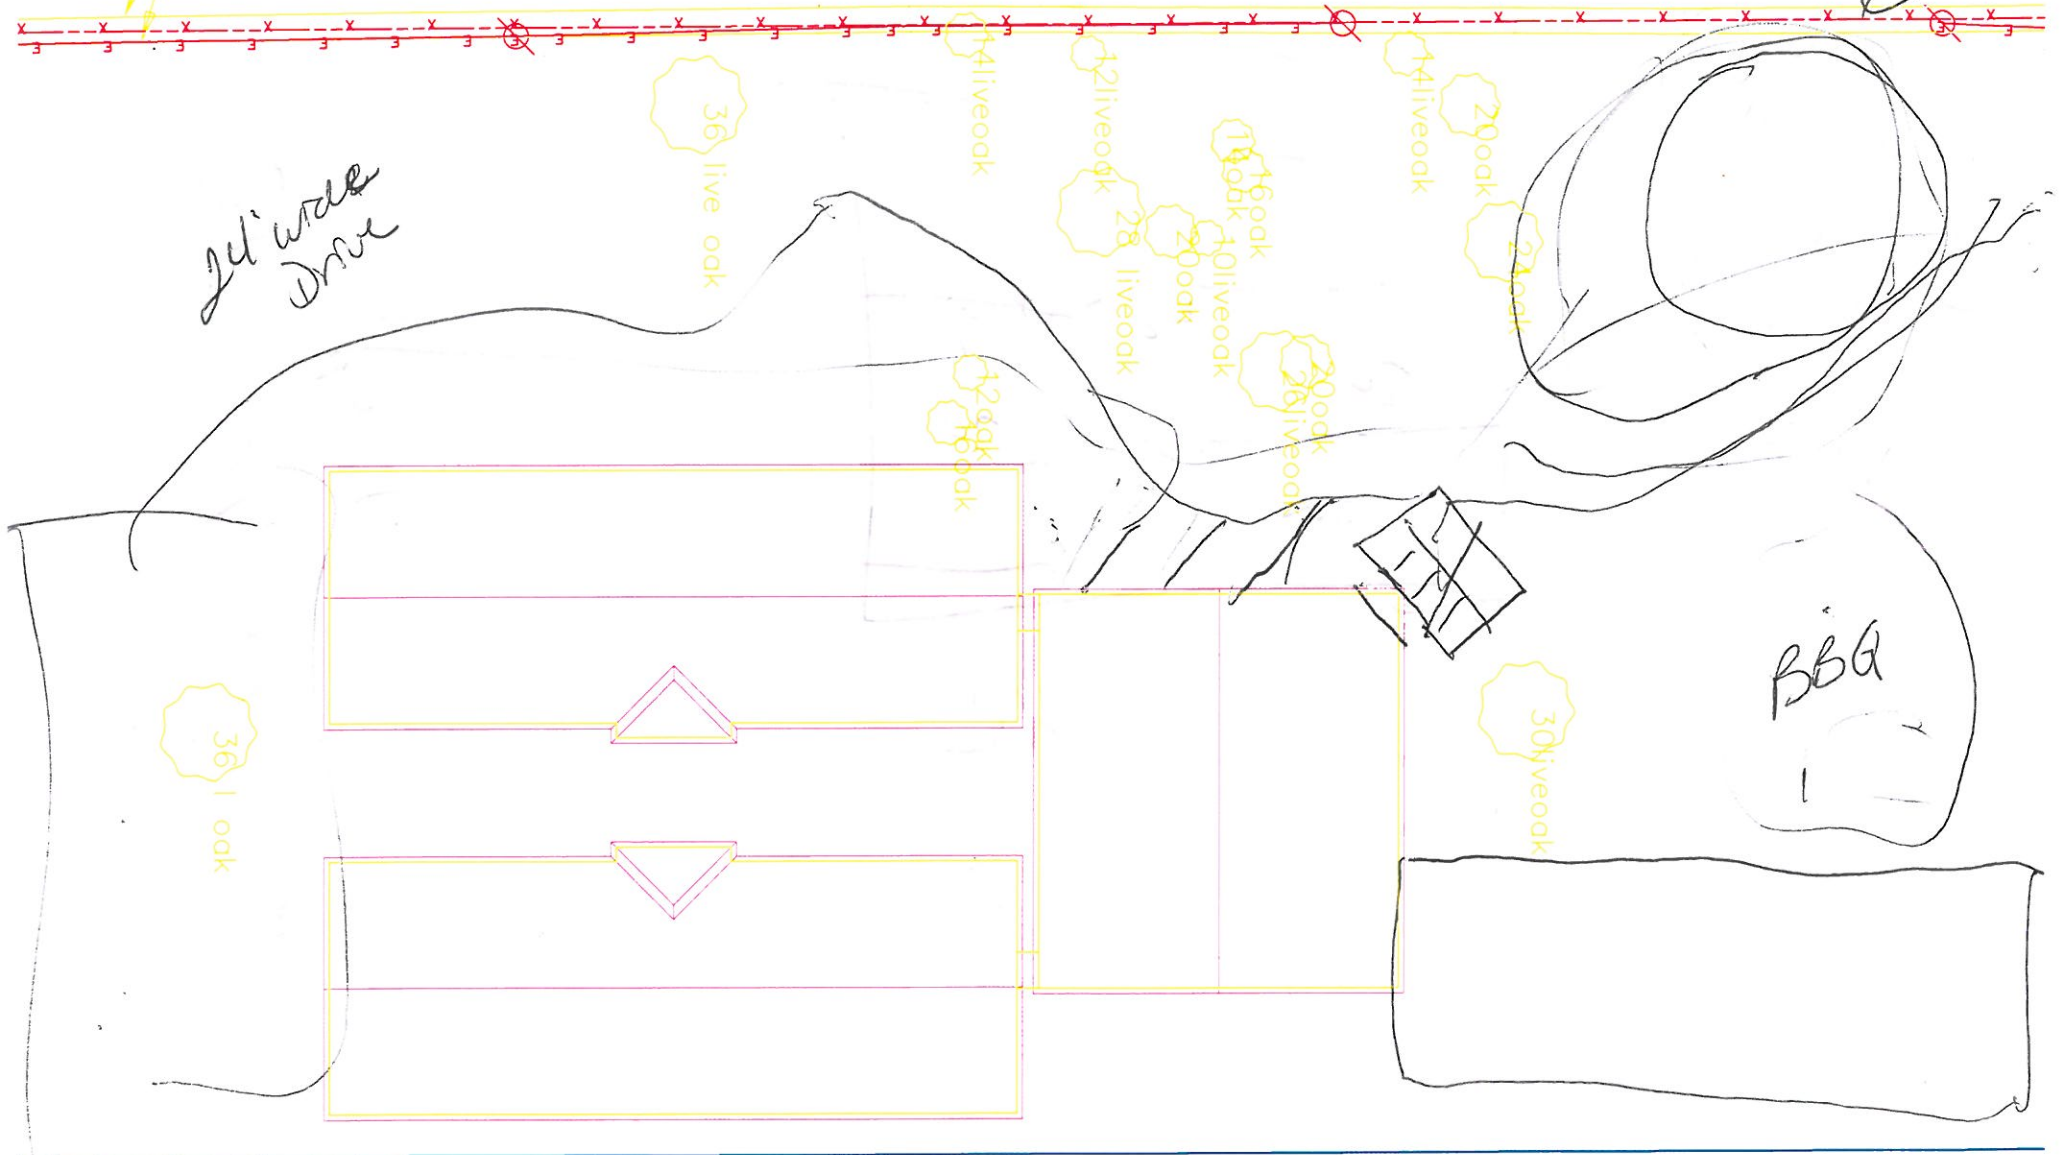

CENTERLINE

(T - S 00°43'44" E 1395.27')  
S 00°07'00" E 1204.70'