


NEW SEALED  
CEILING SYSTEM,  
SEE REFLECTED  
CEILING PLAN

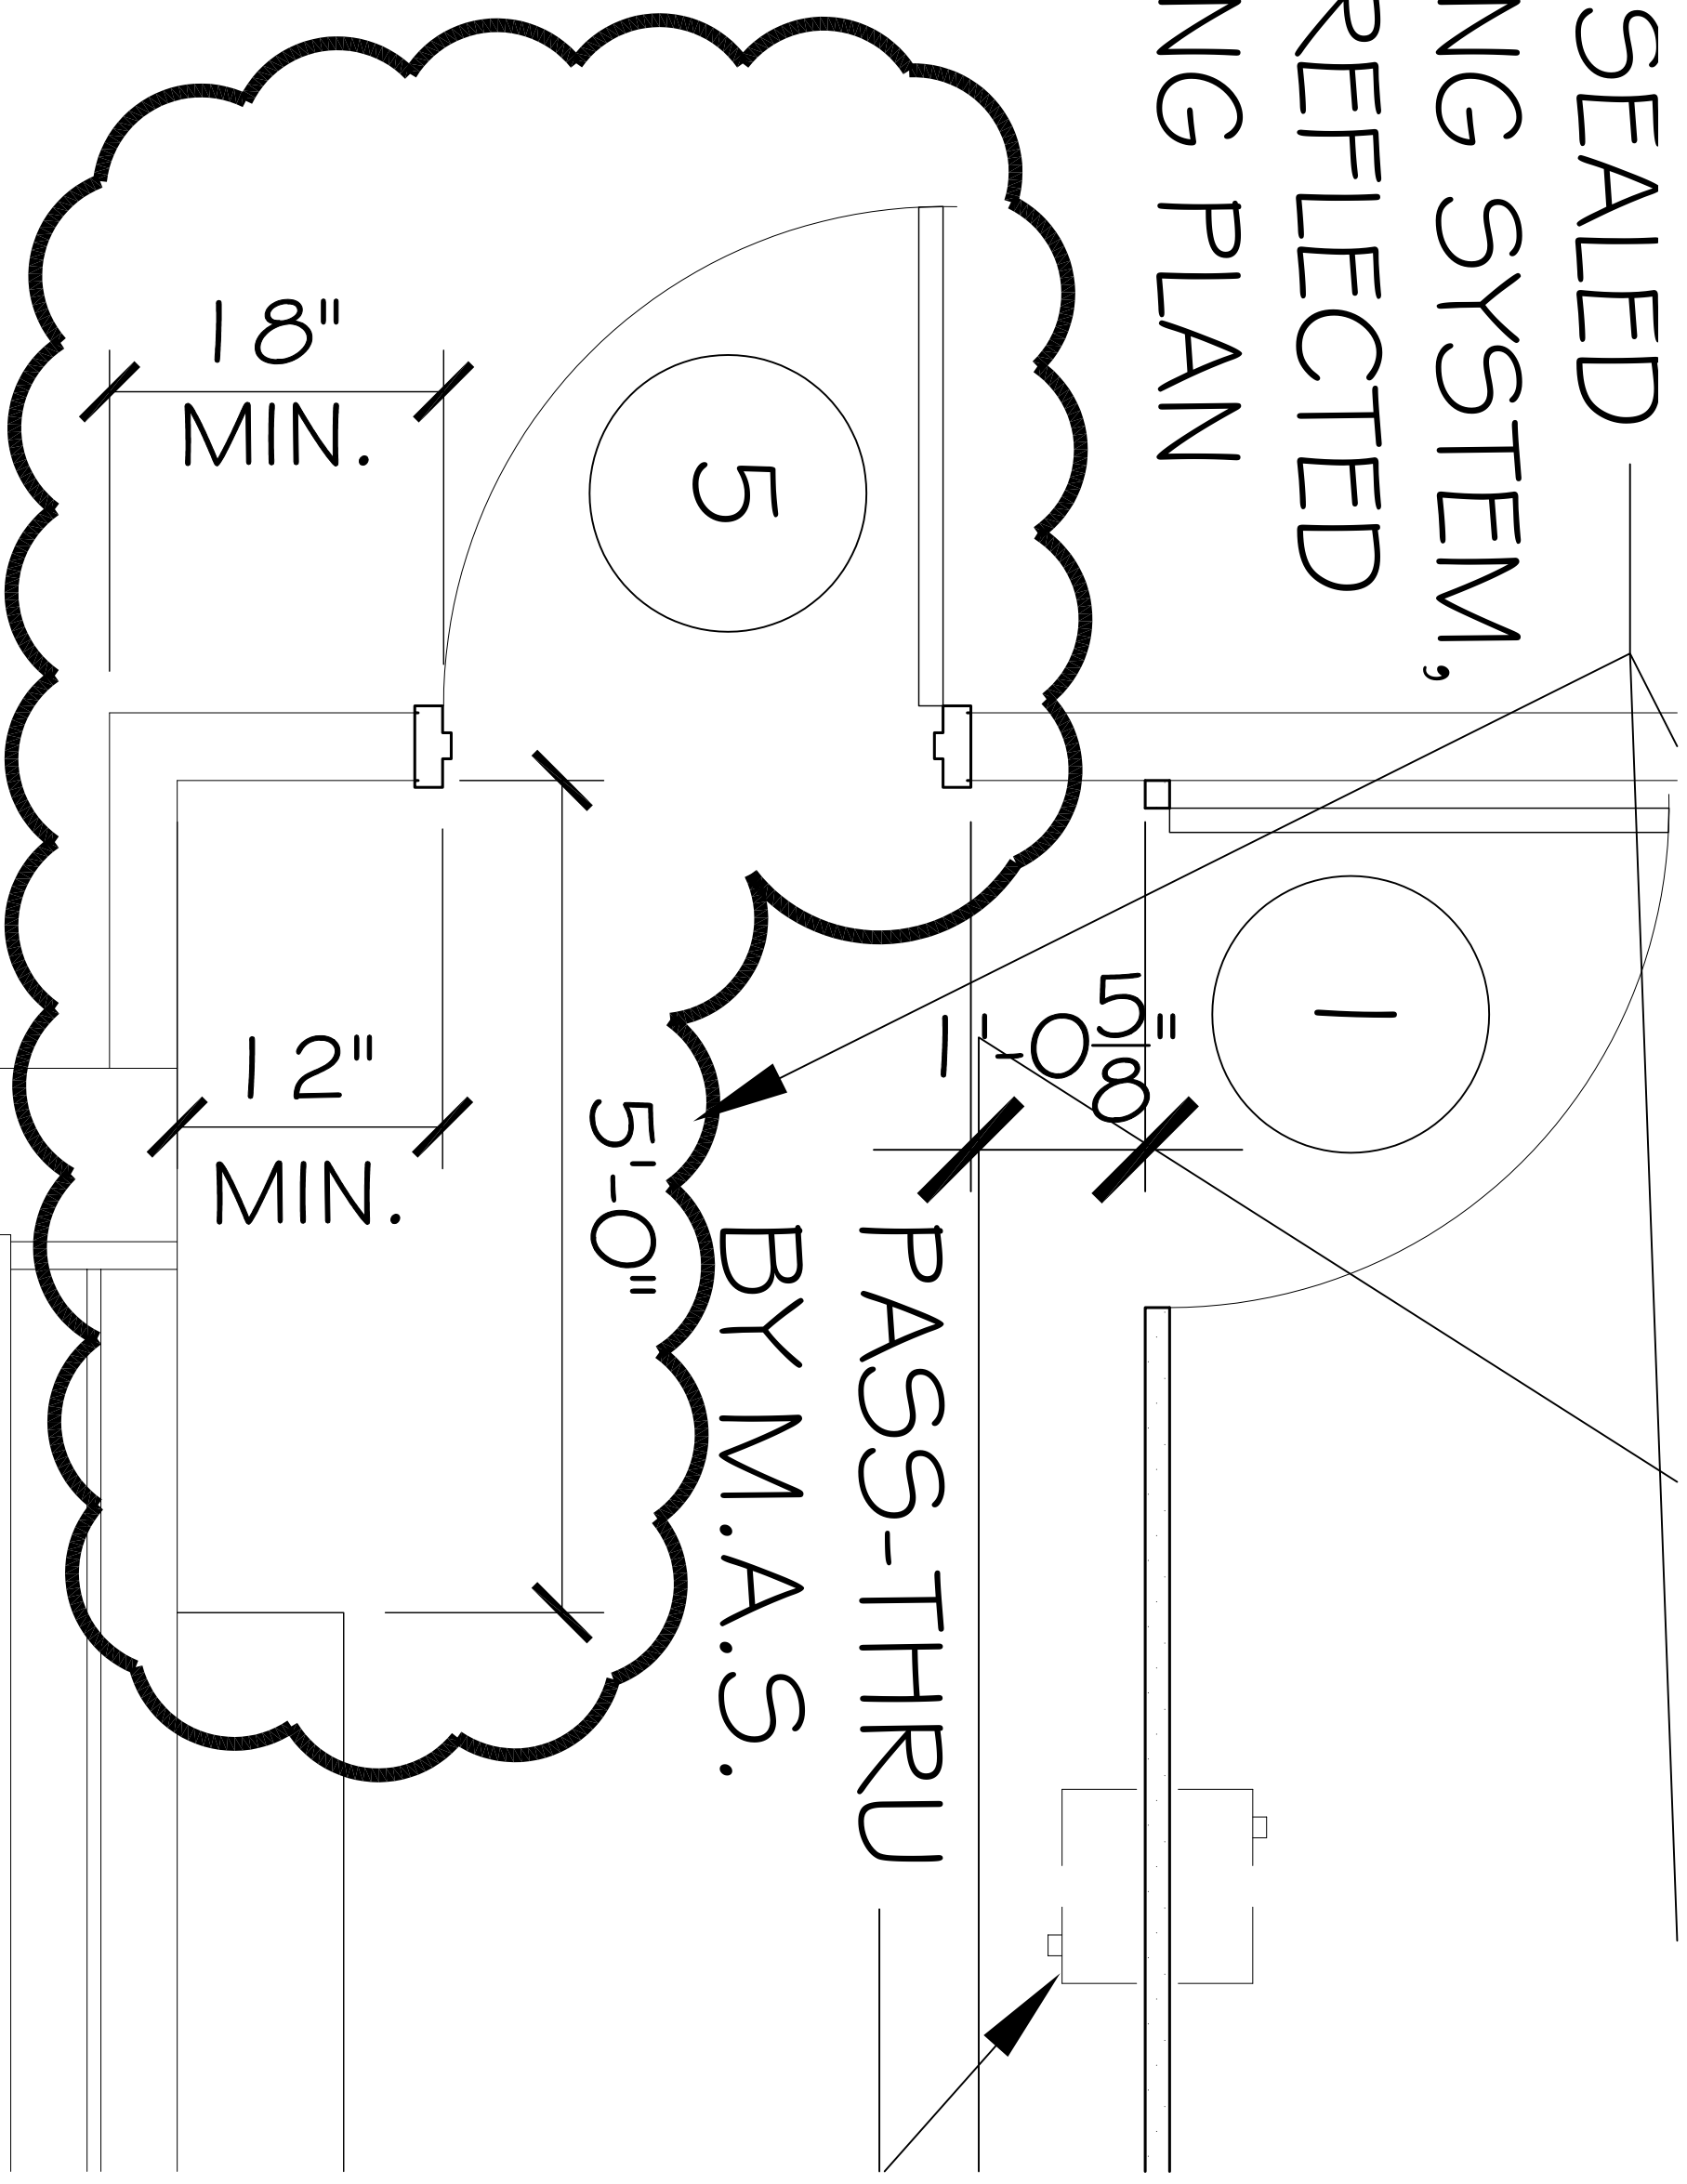

NEW PANEL WALL-"A"  
PROVIDED BY M.A.S.