

## ROOM FINISH SCHEDULE

NAME	FLOOR	BASE	WALL	CEILING	REMARKS
100 PAINTING	V.C.T.	CERAMIC TILE	CARPET	CONC. W/SEALER	
101 JUNEX RESTROOM		VINYL BASE	CERAMIC TILE	NONE	
102 RECEPTION/BUSINESS		NONE	GYP. BD. PAINTED	CERAMIC TILE TO 42" HT.	
103 TREATMENT 1				M.R. GYP. BD.	
104 TREATMENT 2					
105 COOR/DOR					
106 TREATMENT 3					
107 TREATMENT 4					
108 FUTURE TREATMENT					
109 FLOOR					
110 MEN'S RESTROOM					
111 WOMEN'S RESTROOM					
112 JANITOR					
113 OFFICE					
114 PRIVATE OFFICE					
115 PANTRY					
116 HALL					
117 STRILIZATION ROOM					
118 EQUIPMENT CLOSET					
119 DENTAL LAB					
120 CLOSET					
121 CLOSET					
122 STAFF LOUNGE					
123 HALL					
124 CLERICAL					
125 ASSOCIATES OFFICE					

## WINDOW SCHEDULE

MARK	DESCRIPTION	TYPE	FRAME	GLASS	LITES	ACCESSORIES	REMARKS
A	3'-0" x 5'-0"	ALUM. STOREFRONT					
B	3'-0" x 5'-0"	ALUMINUM HOLLOW METAL		TINTED LOW E		ALARM SCREEN SHUTTER	

## DOOR & HARDWARE SCHEDULE


MARK	DESCRIPTION	TYPE	FRAME	HINGE	LOCK	ACCESSORIES	REMARKS
1	3'0x6'8"	S. C. WOOD					
2	3'0x6'8"	H. C. WOOD					
3	3'0x6'8" C.O.	SLIDING POCKET					
4	6'0x6'8" C.O.	HOLLOW METAL					CASED OPENING
5	3'0x6'8"	HOLLOW METAL					CASED OPENING
6	3'0x6'8"	CASED OPENING					
7	PR 2'6x6'8"	WOOD					
8	6'4x6'8" C.O.	ALUMINUM					CASED OPENING
9	3'5x6'8" C.O.	BUTT 1-1/2 PR					CASED OPENING
10	3'0x6'8"	FIXED					
11	3'0x6'8"	NONE					1 HOUR RATED DOOR

### DOOR & HARDWARE NOTES:


1. ANY GLAZING TO BE LAMINATED SAFETY GLASS.
2. COORDINATE KEYING SCHEDULE WITH OWNER
3. DOOR STOPS TO BE SELECTED BY OWNER
4. WEATHER-STRIP & THRESHOLD FINISH TO COMPLEMENT OTHER HARDWARE.
5. ALL NEW EXTERIOR DOORS RATED FOR 140 MPH.

## GENERAL NOTES

1. INSULATION AND INSULATION ASSEMBLIES SHALL MEET THE REQUIREMENTS OF SECTION 7.19.
- A. CONCEALED INSULATION SHALL HAVE A FLAME SPREAD OF 0-25 AND SMOKE DEVELOPED INDEX OF 0-450. EXCEPT THAT IN COMBUSTIBLE (WOOD FRAME) CONSTRUCTION.
- B. FACING SHALL COMPLY WITH IBC 2009.
2. PROVIDE 5/8" LANDINGS, LEVEL WITH FINISHED FLOOR, OUTSIDE EXTERIOR DOORS ON WEST SIDE OF BUILDING. THRESHOLDS SHALL BE NOT MORE THAN 1/2" IN HEIGHT AND SHALL BE BEVELLED IF MORE THAN 1/4".
3. CONTRACTOR TO VERIFY ALL SITE CONDITIONS, BUILDING LOCATIONS, AND DIMENSIONS PRIOR TO CONSTRUCTION.
4. MATERIALS SHALL BE NEW AND U.L. LISTED.
5. NO WORK SHALL BE CONCEALED UNTIL APPROVED BY LOCAL INSPECTORS.
6. CONSTRUCTION SHALL COMPLY WITH ALL PARISH, STATE, AND LOCAL CODES.
7. CONTRACTOR TO GUARANTEE WORK FOR ONE YEAR.
8. CONTRACTOR SHALL FURNISH WATER AND POWER FROM EXISTING SOURCES.
9. EXTERIOR CAULKING SHALL BE THICKAL CAULK.
10. PAINT GRADE TO SHALL BE SHERWIN WILLIAMS OR EQUIVALENT. ALL WORK TO RECEIVE 3 COATS. COLOR SELECTION BY OWNER.
11. PROVIDE CLEANUP ON A REGULAR BASIS. NO TRASH STORED IN BUILDING.
12. ALL BATT INSULATION SHALL HAVE A CLASS 1X (0-25) FLAME SPREAD IN COMPLIANCE WITH APPLICABLE CODE.
13. USE 6" STUDS, OR 4" STAGGERED STUDS AT ALL PLUMBING WALLS.
14. PROVIDE GALVANIZED METAL PAN WITH DRAIN AT WATER HEATER LOCATION.
15. ALL CORNERS SHALL BE PROPERLY BRACED FOR WIND LOADS. A 49° SHEATHING SHALL BE PROVIDED EVERY 20 FEET OF WALL LENGTH.
16. INTERIOR LOCKS ON DOORS IN MEANS OF EGRESS SHALL NOT REQUIRE THE USE OF A KEY. SPECIAL KNOWLEDGE, OR SPECIAL DEVICE TO OPEN IN THE DIRECTION OF EGRESS. ALL DOORS SHALL HAVE LEVER TYPE HANDLES.
17. INTERIOR WALLS AND CEILINGS SHALL HAVE A FLAME SPREAD OF 0-200 AND A SMOKE DEVELOPMENT RATING OF 0-450.
18. ALL WORK SHALL COMPLY WITH THE LATEST EDITION OF ALL LOCAL, STATE, AND NATIONAL CODES COVERING THE TYPE OF WORK BEING PERFORMED.
19. PROVIDE PORTABLE FIRE EXTINGUISHERS IN ACCORDANCE WITH NFPA 101. SEE APPENDIX "E" OF NFPA 101 FOR DISTRIBUTION OF EXTINGUISHERS.
20. ALL FIRE WALLS SHALL EXTEND TIGHT TO ROOF DECK AND BE SEALED WITH AN APPROVED FIRE CAULK.
21. ALL ELECTRICAL, MECHANICAL, AND PLUMBING MATERIALS PENETRATING FIRE WALLS SHALL BE FIRE CAULKED. (PENETRATIONS THROUGH RATED CONSTRUCTION SHALL BE SEALED WITH A MATERIAL CAPABLE OF PREVENTING THE PASSAGE OF FLAMES AND HOT GASES WHEN TESTED IN ACCORDANCE WITH ASTM E814.)
22. SERVICE COUNTER SHALL HAVE A HCP ACCESSIBLE WRITING SURFACE. MAX. 36" FROM F.F. (ADAAG MANUAL 1998, PG 1.35)

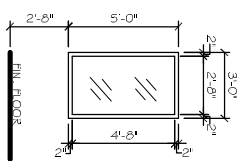

## WINDOW TYPES

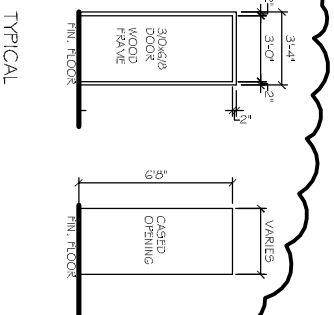

## DOOR TYPES

FINISH,  
WINDOW,  
& DOOR  
SCHEDULES

SHEET No: 11 OF 15

A-5



DAMMON  
ENGINEERING INC.  
*Architects & Engineers*

CHIEF ARCHITECT: KEVIN KINCHEN  
554 OLD SPANISH TRAIL  
SUDELL, LA 70450

dammoneengineering.com  
dammoneng@bellsouth.net  
PHONE: 985-649-5832  
FAX: 985-641-5950

OFFICE RENOVATION FOR  
DR. KRISTI SOILEAU, DDS, MED

PERIODONTAL COSMETIC AND REGENERATIVE SURGERY  
3634 COLISEUM  
NEW ORLEANS, LOUISIANA

JOB No: 2188

DATE: 11-14-2013

DRAWN BY: JTL

CHECKED BY: CKD



These plans have been prepared under my supervision and to the best of my knowledge they comply with the Orleans Parish Building Code. I will not supervise the work.

Kevin Kinchen

REVISIONS		DATE
#	DESCRIPTION	
1	REVISED SCHEDULE	