DOOR & HARDWARE SCHEDULE

NO.	SIZE	TYPE: STOREFRONT	TYPE: HOLLOW METAL	TYPE: S. C. WOOD	TYPE: H. C. WOOD	FRAME: ALUMINUM	FRAME: HOLLOW METAL	FRAME: WOOD	HINGE: BUTT	LOCK: DEADBOLT	LOCK: KEYED HANDLE	LOCK: PASSAGE	LOCK: PRIVACY	ACCESS.: PUSH PULL	ACCESS.: THRESHOLD	ACCESS.: WEATHERSTRIP	ACCESS.: CLOSER	ACCESS.: DOOR STOP	REMARKS
1	3'0x7'0	●				●			●	●	●				●	●	●		
2	3'0x7'0		●				●		●	●	●				●	●	●		
3	3'0x7'0			●				●	●			●						●	
4	3'0x7'0			●				●	●		●	●						●	
5	3'0x7'0	●			●			●	●			●						●	
6	4'0x7'0 *							●											* SEE ELEVATION, C.O.
7	9'x8'0							●											CASED OPENING
8	3'0x7'0			●	●			●	●				●					●	
9	3'0x7'0				●			●	●			●						●	
10	3'0x7'0			●	●			●	●		●		●					●	

WINDOW SCHEDULE

WINDOW (HT. x WIDTH)	TYPE: FIXED	TYPE: VERT. SLIDE	TYPE: HORIZ. SLIDE	TYPE: STOREFRONT	FRAME: ALUM	FRAME: HOLLOW METAL	FRAME: WOOD	GLASS: TINTED	GLASS: PLAIN	GLASS: INSULATED	GLASS: TEMPERED	LITES: SEE ELEVATION	LITES: NONE	ACCESS.: SCREEN	ACCESS.: SHUTTER	ACCESS.: NONE	ACCESS.: ALARM	REMARKS
(A) 3040			●						●									
(B) 3040			●						●									
(C) 9868 GLSL SLIDE									●									
(D)																		

ROOM FINISH SCHEDULE

	NAME	FLOOR: VCT	FLOOR: CERAMIC TILE	FLOOR: CARPET	FLOOR: CONC. W/SEALER	BASE: VINYL BASE	BASE: CERAMIC TILE	BASE: NONE	WALL: GYP BD. PAINTED	WALL: CERAMIC TILE	WALL: LEAD LINED PANELS	CEILING: GYP BD. PAINTED	CEILING: 24"x24" ACOUST.	CEILING: CLG. HGT	REMARKS
101	SICK WAITING	●												9'-0"	
102	WELL WAITING	●												9'-0"	
103	BUSINESS/RECEPTION	●												9'-0"	
104	HALL	●												9'-0"	
105	CORRIDOR	●												9'-0"	
106	SICK ROOM #1	●												9'-0"	
107	SICK ROOM #2	●												9'-0"	
108	SICK ROOM #3	●												9'-0"	
109	TRIAGE	●												9'-0"	
110	RESTROOM	●												9'-0"	
111	SICK ROOM #4	●												9'-0"	
112	SICK ROOM #5	●												9'-0"	
113	SICK ROOM #6	●												9'-0"	
114	CORRIDOR	●												9'-0"	
115	SUPPLIES	●												9'-0"	
116	HALL	●												9'-0"	
117	WELL WORK AREA	●												9'-0"	
118	WELL ROOM #1	●												9'-0"	
119	WELL ROOM #2	●												9'-0"	
120	WELL ROOM #3	●												9'-0"	
121	WELL ROOM #4	●												9'-0"	
122	RESTROOM	●												9'-0"	
123	KITCHEN/BREAKROOM	●												9'-0"	
124	JANITOR	●												9'-0"	
125	DATA	●												9'-0"	
126	DOCTOR'S OFFICE		●	●										9'-0"	
127	DOCTOR'S OFFICE		●	●										9'-0"	
128	HALL	●												9'-0"	
129	RESTROOM	●												9'-0"	

GENERAL NOTES

1. INSULATION AND INSULATION ASSEMBLIES SHALL MEET THE REQUIREMENTS OF SECTION 719.
   A. CONCEALED INSULATION SHALL HAVE A FLAME SPREAD OF 0-25 AND SMOKE DEVELOPED INDEX OF 0-450. EXCEPT THAT IN COMBUSTIBLE (WOOD FRAME) CONSTRUCTION.
   B. FACING SHALL COMPLY WITH IBC 2006.
2. PROVIDE 5'x5' LANDINGS, LEVEL WITH FINISHED FLOOR, OUTSIDE EXTERIOR DOORS ON WEST SIDE OF BUILDING. THRESHOLDS SHALL BE NOT MORE THAN 1/2" IN HEIGHT AND SHALL BE BEVELED IF MORE THAT 1/4".
3. CONTRACTOR TO VERIFY ALL SITE CONDITIONS, BUILDING LOCATIONS, AND DIMENSIONS PRIOR TO CONSTRUCTION.
4. MATERIALS SHALL BE NEW AND U.L. LISTED.
5. NO WORK SHALL BE CONCEALED UNTIL APPROVED BY LOCAL INSPECTORS.
6. CONSTRUCTION SHALL COMPLY WITH ALL PARISH, STATE, AND LOCAL CODES.
7. CONTRACTOR TO GUARANTEE WORK FOR ONE YEAR.
8. CONTRACTOR SHALL FURNISH WATER AND POWER FROM EXISTING SOURCES.
9. EXTERIOR CAULKING SHALL BE THIOKAL CAULK.
10. PAINT GRADE TO SHALL BE SHERWIN WILLIAMS OR EQUIVALENT. ALL WORK TO RECEIVE 3 COATS. COLOR SELECTION BY OWNER.
11. PROVIDE CLEANUP ON A REGULAR BASIS. NO TRASH STORED IN BUILDING.
12. ALL BATT INSULATION SHALL HAVE A CLASS "A" (0-25) FLAME SPREAD IN COMPLIANCE WITH APPLICABLE CODE.
13. USE 6" STUDS, OR 4" STAGGERED STUDS AT ALL PLUMBING WALLS.
14. PROVIDE GALVANIZED METAL PAN WITH DRAIN AT WATER HEATER LOCATION.
15. ALL CORNERS SHALL BE PROPERLY BRACED FOR WIND LOADS. A 48" SHEATHING SHALL BE PROVIDED EVERY 20 FEET OF WALL LENGTH.
16. FLOORING SHALL BE NON-SLIP.
17. INTERIOR LOCKS ON DOORS IN MEANS OF EGRESS SHALL NOT REQUIRE THE USE OF A KEY, SPECIAL KNOWLEDGE, OR SPECIAL DEVICE TO OPEN IN THE DIRECTION OF EGRESS. ALL DOORS SHALL HAVE LEVER TYPE HANDLES.
18. INTERIOR WALLS AND CEILINGS SHALL HAVE A FLAME SPREAD OF 0-200 AND A SMOKE DEVELOPMENT RATING OF 0-450.
19. ALL WORK SHALL COMPLY WITH THE LATEST EDITION OF ALL LOCAL, STATE, AND NATIONAL CODES COVERING THE TYPE OF WORK BEING PERFORMED.
20. PROVIDE PORTABLE FIRE EXTINGUISHERS IN ACCORDANCE WITH NFPA 101. SEE APPENDIX 'E' OF NFPA 101 FOR DISTRIBUTION OF EXTINGUISHERS.
21. ALL FIRE WALLS SHALL EXTEND TIGHT TO ROOF DECK AND BE SEALED WITH AN APPROVED FIRE CAULK.
22. ALL ELECTRICAL, MECHANICAL, AND PLUMBING MATERIALS PENETRATING FIRE WALLS SHALL BE FIRE CAULKED. (PENETRATIONS THROUGH RATED CONSTRUCTION SHALL BE SEALED WITH A MATERIAL CAPABLE OF PREVENTING THE PASSAGE OF FLAMES AND HOT GASES WHEN TESTED IN ACCORDANCE WITH ASTM-E814.)
23. SERVICE COUNTER SHALL HAVE A HCP ACCESSIBLE WRITING SURFACE, MAX. 36" FROM F.F. (ADAAG MANUAL 1998, PG 135)

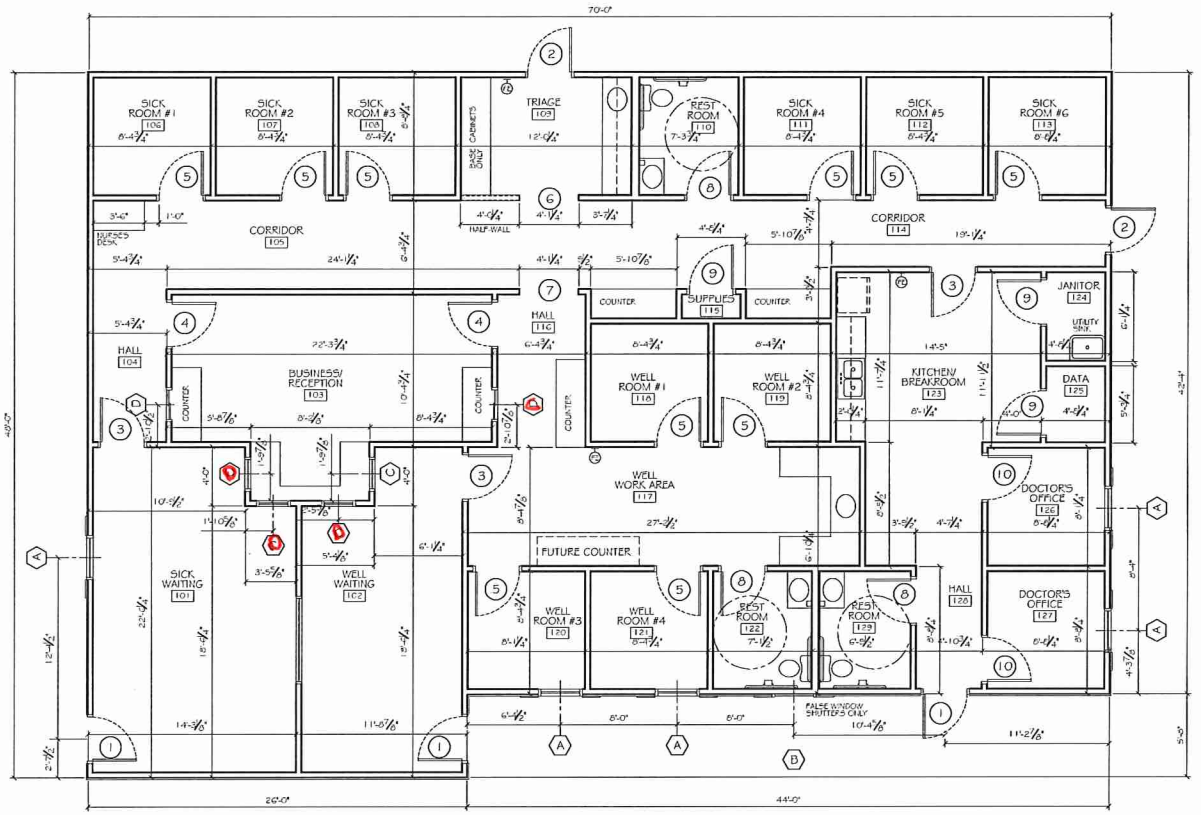

1 FLOOR PLAN
SCALE 1/4" = 1'-0"

DAMMON ENGINEERING, INC.
Architects & Engineers
www.dammoneng.com
info@dammoneng.com
P: 985.641.1010
F: 985.641.1990
Chief Architect: Kevin J. Kitchen, NCARB
Chief Engineer: Brian Hebert, PE
Mechanical: Jeff Hebert
Slidell, LA 70458

REVISIONS

#	DESCRIPTION	DATE

SEAL:

MEDICAL CLINIC FOR
D. R. HERNANDEZ
DENHAM SPRINGS, LA

JOB NO: 2216 | DATE: 03-13-14 | CHECKED BY: JTL | DRAWN BY: CC

SHEET TITLE: FLOOR PLAN

DRAWING NUMBER: A1

SHEET No: 00 of #