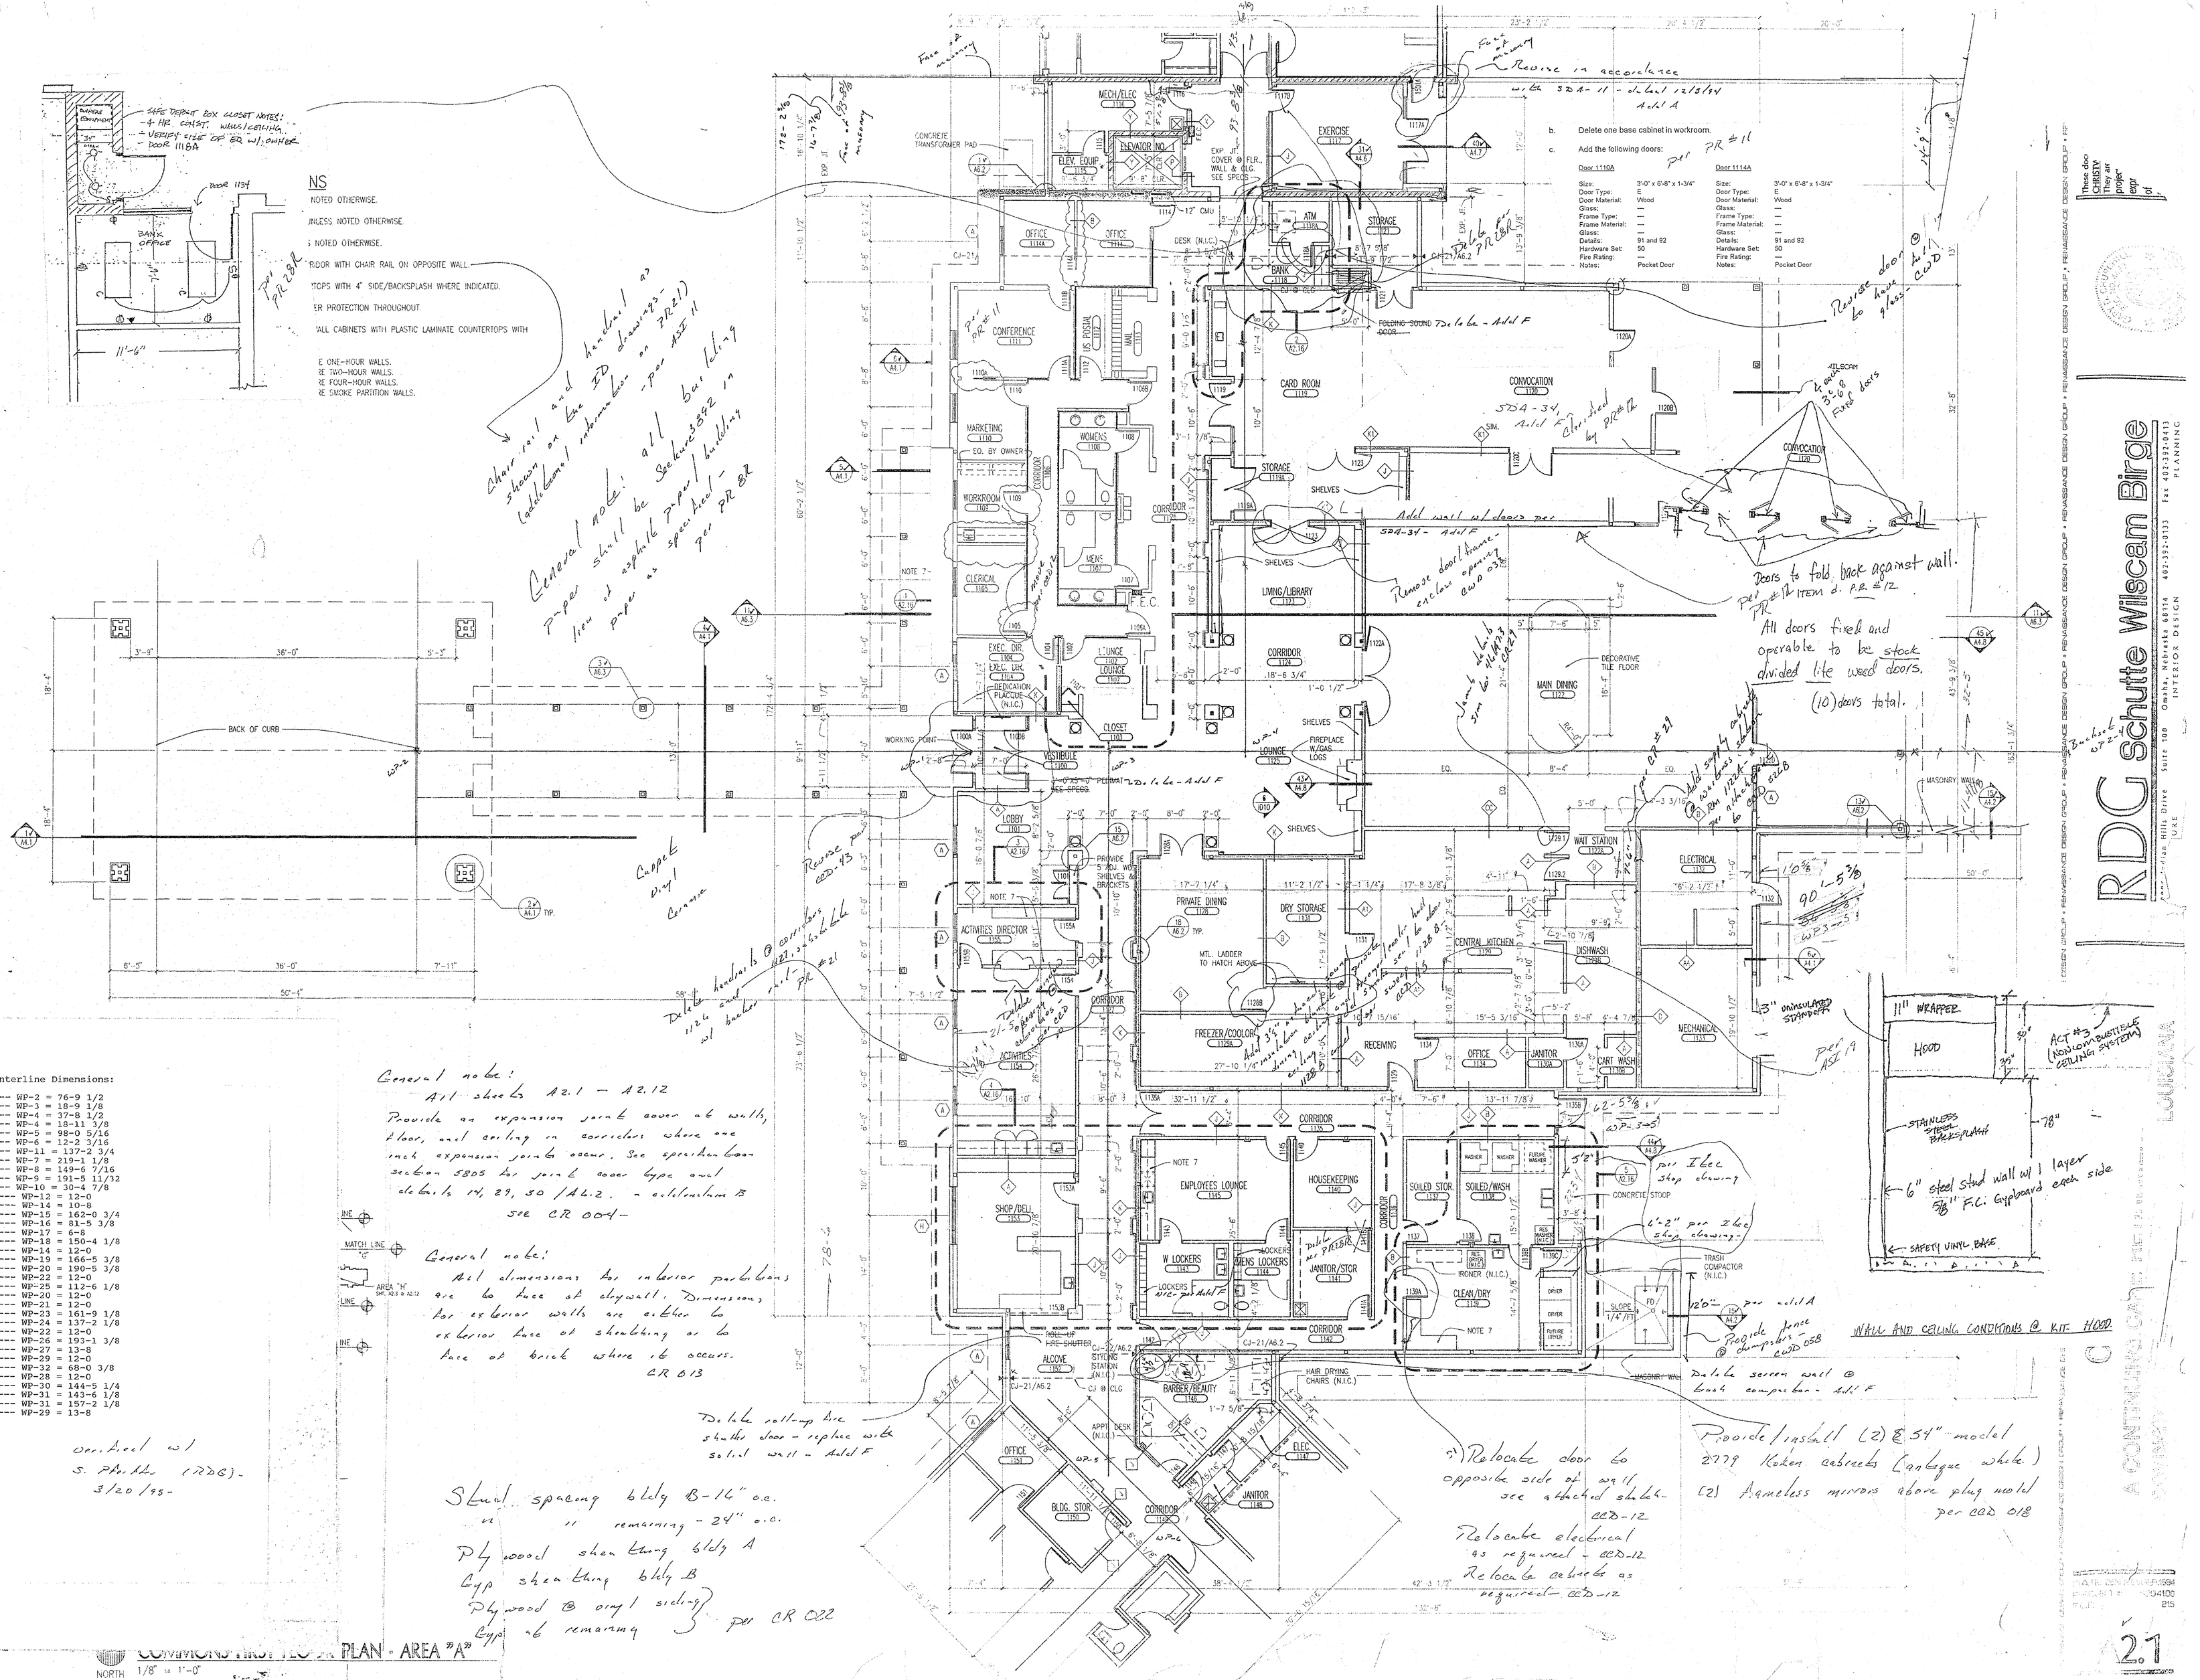
NS
NOTED OTHERWISE.
UNLESS NOTED OTHERWISE.
NOTED OTHERWISE.
RIDOR WITH CHAIR RAIL ON OPPOSITE WALL.
TOPS WITH 4" SIDE/BACKSPLASH WHERE INDICATED.
ER PROTECTION THROUGHOUT.
ALL CABINETS WITH PLASTIC LAMINATE COUNTERTOPS WITH
E ONE-HOUR WALLS.
BE TWO-HOUR WALLS.
BE FOUR-HOUR WALLS.
BE SMOKE PARTITION WALLS.
Corridor Centerline Dimensions:
WP-1 --- WP-2 = 76-9 1/2
WP-1 --- WP-3 = 18-9 1/8
WP-1 --- WP-4 = 37-8 1/2
WP-3 --- WP-4 = 18-11 3/8
WP-3 --- WP-5 = 98-0 5/16
WP-5 --- WP-6 = 12-2 3/16
WP-4 --- WP-11 = 137-2 3/4
WP-6 --- WP-7 = 219-1 1/8
WP-6 --- WP-8 = 149-6 7/16
WP-8 --- WP-9 = 191-5 11/32
WP-9 --- WP-10 = 30-4 7/8
WP-11 --- WP-12 = 12-0
WP-11 --- WP-14 = 10-8
WP-11 --- WP-15 = 162-0 3/4
WP-15 --- WP-16 = 81-5 3/8
WP-16 --- WP-17 = 6-8
WP-17 --- WP-18 = 150-4 1/8
WP-13 --- WP-14 = 12-0
WP-13 --- WP-19 = 166-5 3/8
WP-14 --- WP-20 = 190-5 3/8
WP-19 --- WP-22 = 12-0
WP-19 --- WP-25 = 112-6 1/8
WP-19 --- WP-20 = 12-0
WP-20 --- WP-21 = 12-0
WP-20 --- WP-23 = 161-9 1/8
WP-21 --- WP-24 = 137-2 1/8
WP-21 --- WP-22 = 12-0
WP-12 --- WP-26 = 193-1 3/8
WP-26 --- WP-27 = 13-8
WP-26 --- WP-29 = 12-0
WP-26 --- WP-32 = 68-0 3/8
WP-27 --- WP-28 = 12-0
WP-27 --- WP-30 = 144-5 1/4
WP-28 --- WP-31 = 143-6 1/8
WP-29 --- WP-31 = 157-2 1/8
WP-28 --- WP-29 = 13-8
b. Delete one base cabinet in workroom.
c. Add the following doors:
Door 1110A
Size: 3'-0" x 6'-8" x 1-3/4"
Door Type: E
Door Material: Wood
Glass: —
Frame Type: —
Frame Material: —
Glass: —
Details: 91 and 92
Hardware Set: 50
Fire Rating: —
Notes: Pocket Door
Door 1114A
Size: 3'-0" x 6'-8" x 1-3/4"
Door Type: E
Door Material: Wood
Glass: —
Frame Type: —
Frame Material: —
Glass: —
Details: 91 and 92
Hardware Set: 50
Fire Rating: —
Notes: Pocket Door
WRAPPER
HOOD
STAINLESS STEEL BACKSPLASH
6" steel stud wall w/ 1 layer 5/8" F.C. Gypboard each side
SAFETY VINYL BASE
ACT #3 (NON-COMBUSTIBLE CEILING SYSTEM)
WALL AND CEILING CONDITIONS @ KIT. HOOD
Provide/install (2) @ 54" model 2779 Koken cabinets (antique white.)
(2) Armless mirrors above plug mold per CCD 018
Relocate door to opposite side of wall see attached sketch CCD-12
Relocate electrical as required - CCD-12
Relocate cabinets as required - CCD-12
Delete screen wall @ trash compactor - Add F
Provide fence @ dumpsters - CCD 058
Delete rollup fire shutter door - replace with solid wall - Add F
Stud spacing bldg B-16" o.c.
" " remaining - 24" o.c.
Plywood sheathing bldg A
Gyp sheathing bldg B
Plywood @ vinyl siding
Gyp at remaining
per CR 022
Revise door hardware per CCD-43
Delete headers @ corridors 1124 and 1126 and rail per PR #21
Doors to fold back against wall. per PR #12 ITEM d. P.R. #12
All doors fixed and operable to be stock divided lite wood doors. (10) doors total.
Revise door hardware - exterior opening CCD 038
Add wall w/ doors per SDA-34 - Add F
Remove door hardware - exterior opening CCD 038
Revise door hardware to glass - CCD
Delete per PR #28
Delete per PR #28
Delete per PR #28