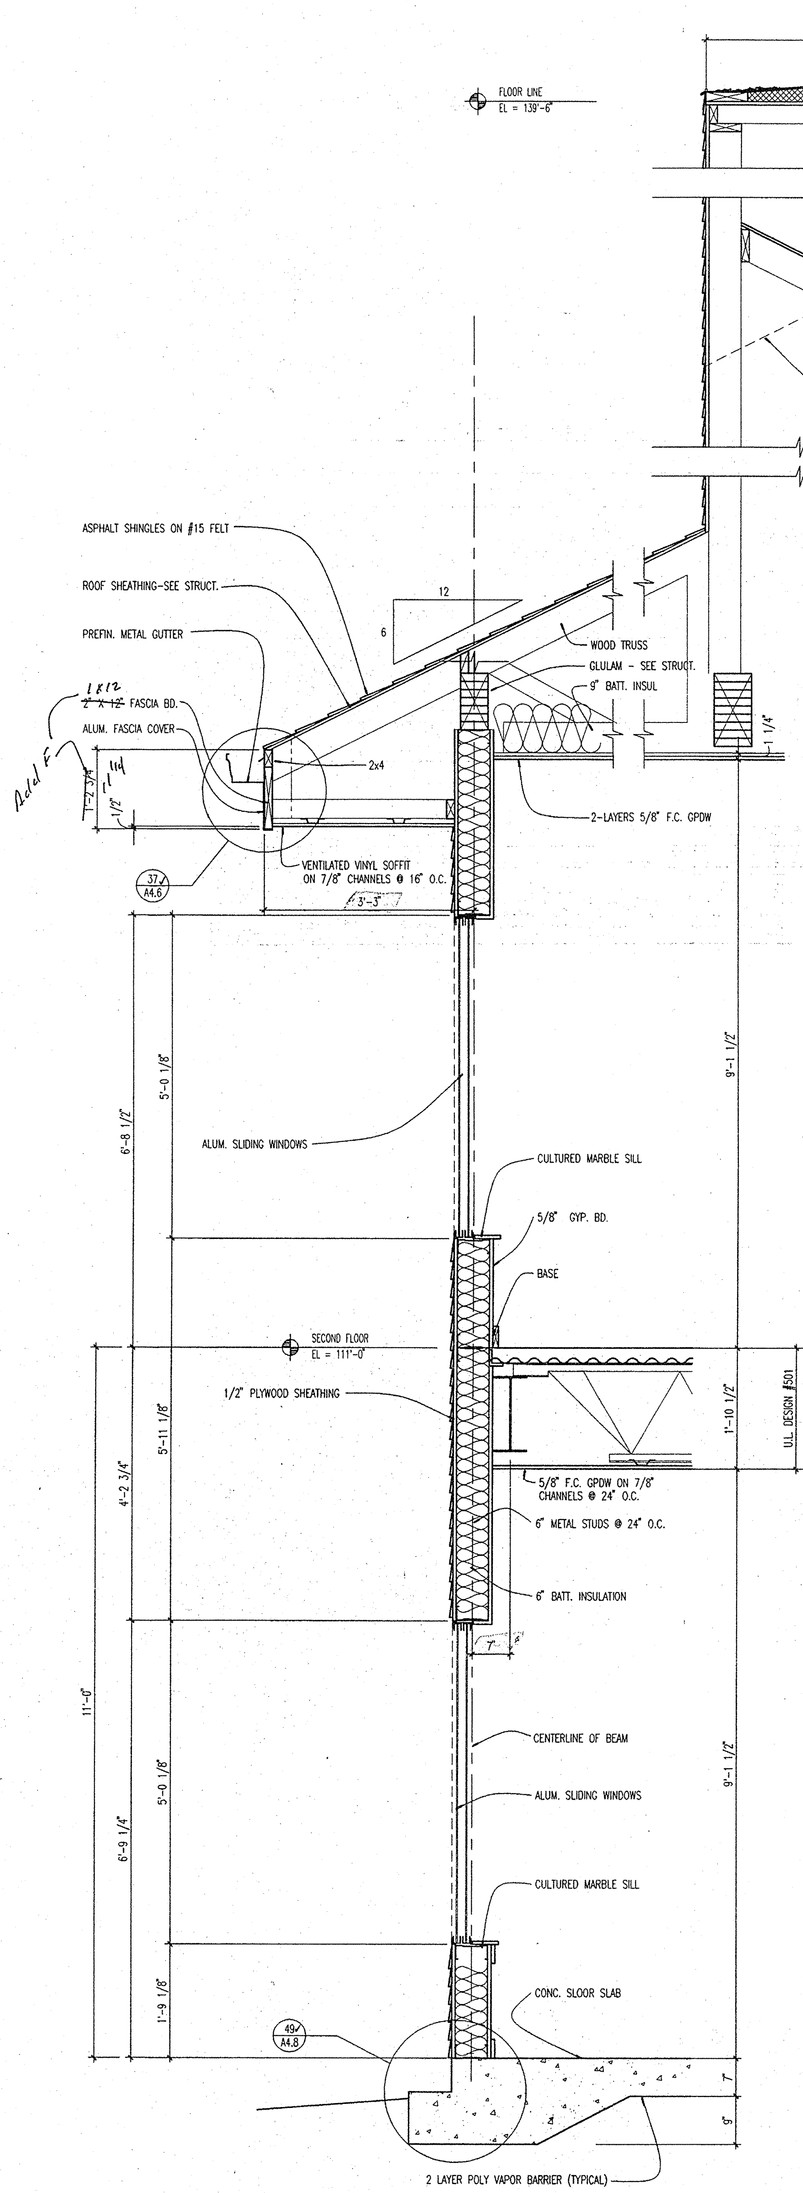

38 WALL SECTION
3/4" = 1'-0"

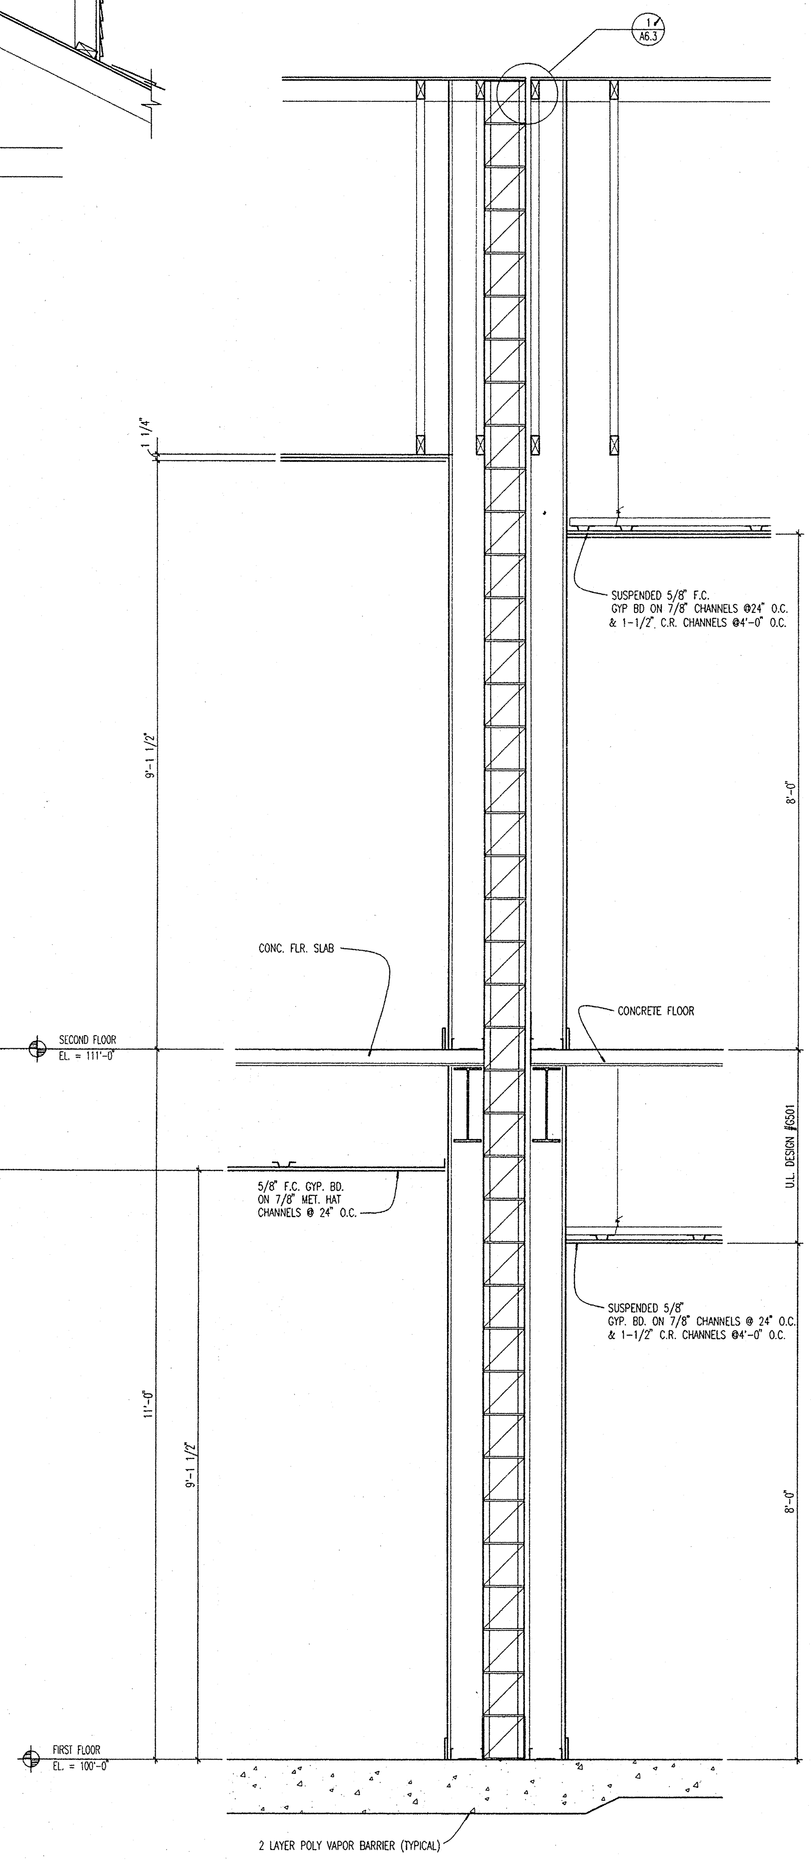

39 WALL SECTION
3/4" = 1'-0"

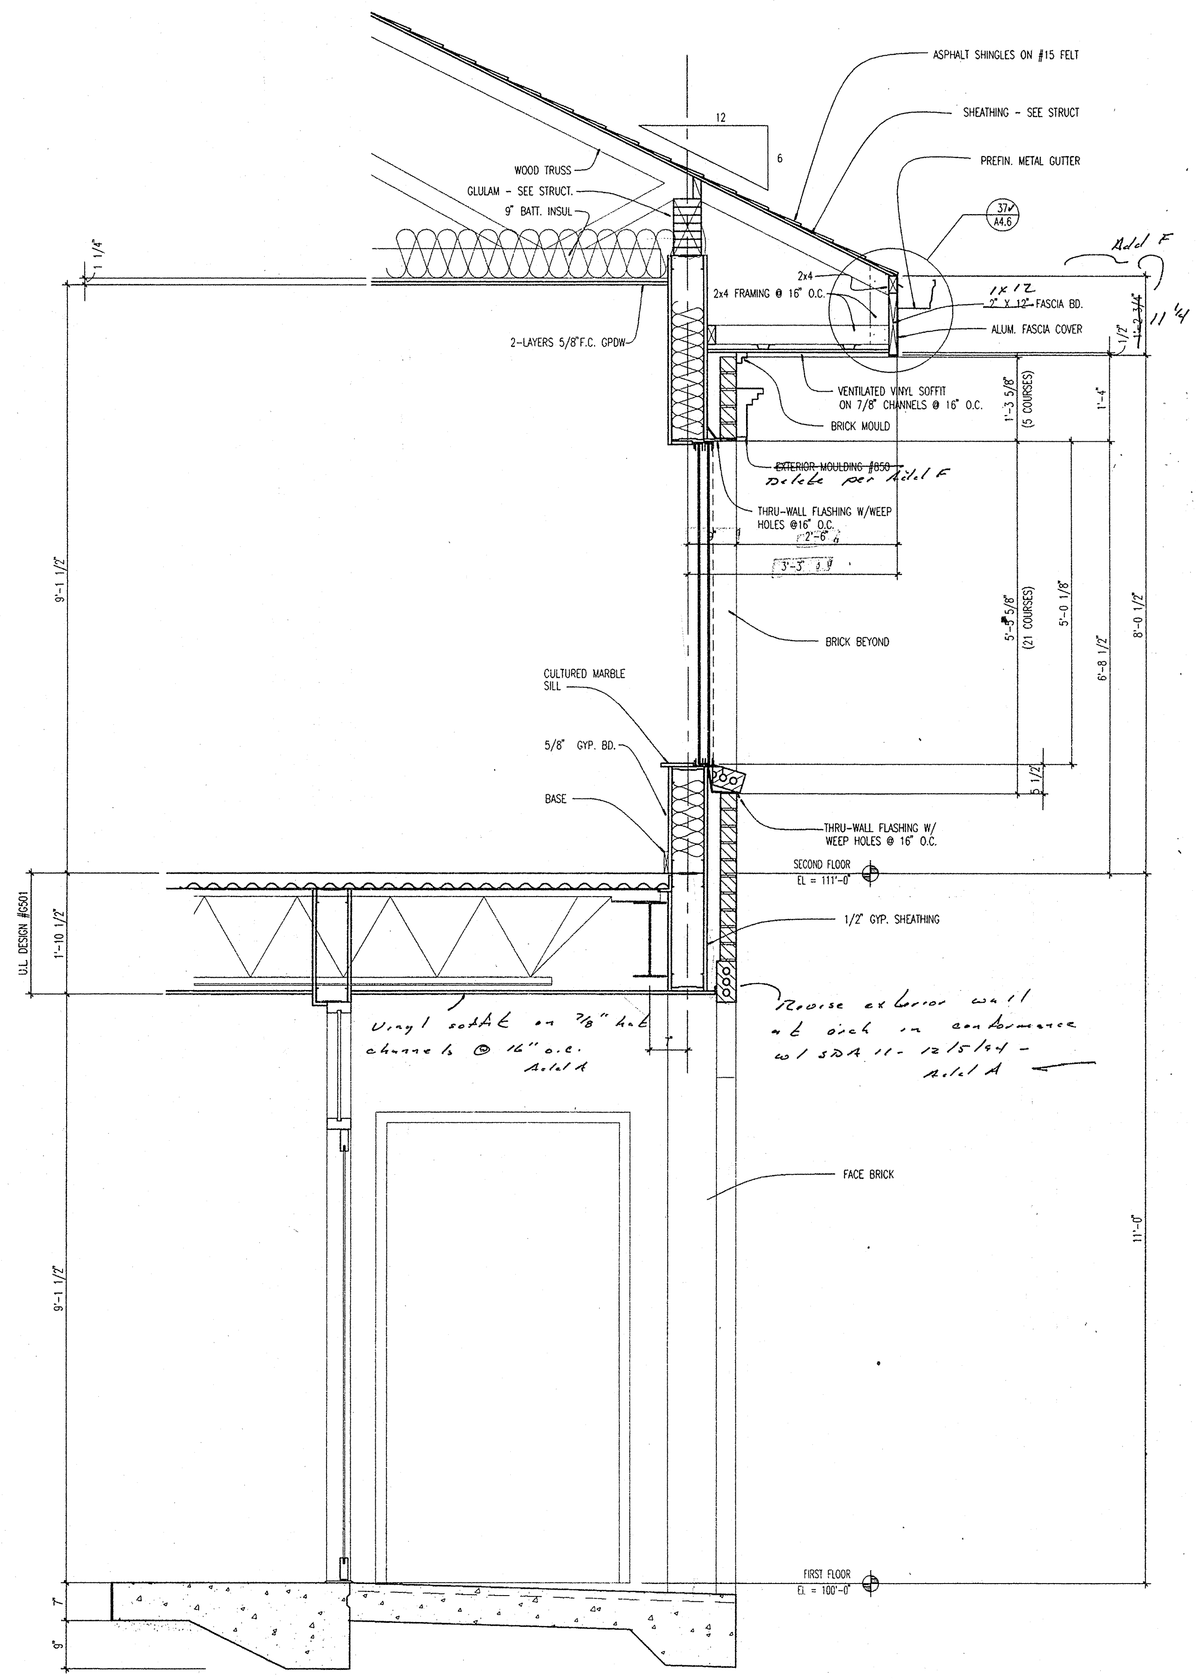

40 WALL SECTION
3/4" = 1'-0"

REFER TO STRUCTURAL PLANS FOR ALL FOOTING LOCATIONS AND REINFORCING DETAILS. DRAWINGS HERE MAY SHOW ONLY DIAGRAMMATIC REPRESENTATIONS OF STRUCTURAL ITEMS FULLY DETAILED ON STRUCTURAL DRAWINGS.

These documents have been prepared for the CHRISTWOOD RETIREMENT CENTER project. They are not suitable for use on other projects or in other locations without the express written approval and participation of RDG - Schutte, Wilscam, Birge, Inc. Reproduction is prohibited
© RDG Schutte Wilscam Birge

RDG Schutte Wilscam Birge
8805 Indian Hills Drive Suite 100 Omaha, Nebraska 68114 402-392-0111 Fax 402-392-0433
ARCHITECTURE INTERIOR DESIGN PLANNING

CHRISTWOOD
A CONTINUING CARE RETIREMENT FACILITY
COVINGTON LOUISIANA

DATE: 25NOVEMBER1994
PROJECT #: 9204100
FILE: 215

A4.7

RENAISSANCE DESIGN GROUP • RENAISSANCE DESIGN GROUP • RENAISSANCE DESIGN GROUP • RENAISSANCE DESIGN GROUP • RENAISSANCE DESIGN GROUP • RENAISSANCE DESIGN GROUP • RENAISSANCE DESIGN GROUP • RENAISSANCE DESIGN GROUP