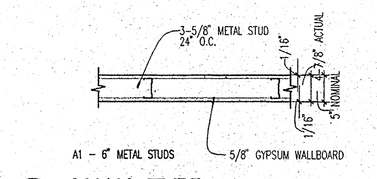

A WALL TYPE
INTERIOR PARTITION - NON RATED STC: 45
WP 1200

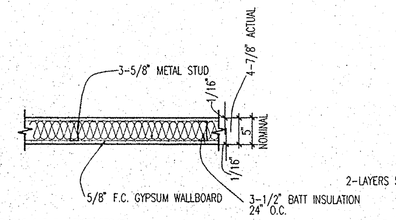

B WALL TYPE
SOUND PARTITION - 1 HOUR STC: 49
WP 1076

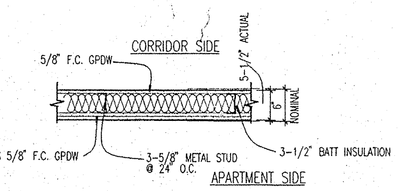

C WALL TYPE-CORRIDOR WALL
1 HOUR PARTITION STC: 54
WP 1023 MOD.
EXTEND UP TO FLOOR DECK
FIRST FLOOR ONLY

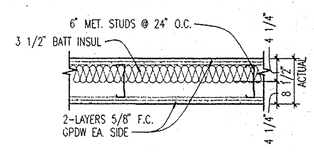

D WALL TYPE - PARTY WALL
2 HR FIRE RATED WALL STC: 54
WP 1548
EXTEND UP TO FLOOR DECK
FIRST FLOOR ONLY

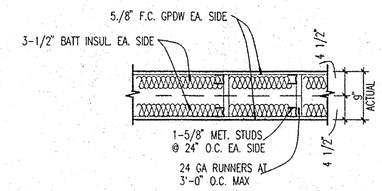

E WALL TYPE - CHASE WALL
1 HOUR STC: 54
WP 5015

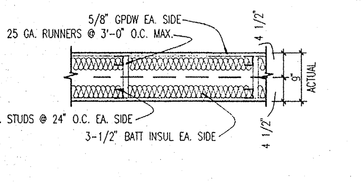

F WALL TYPE - CHASE WALL
NON-RATED STC: 54
WP 5015 WP 8005

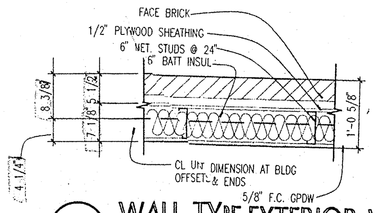

G WALL TYPE-EXTERIOR WALL
1-HOUR
WP 8005
U.L. U901

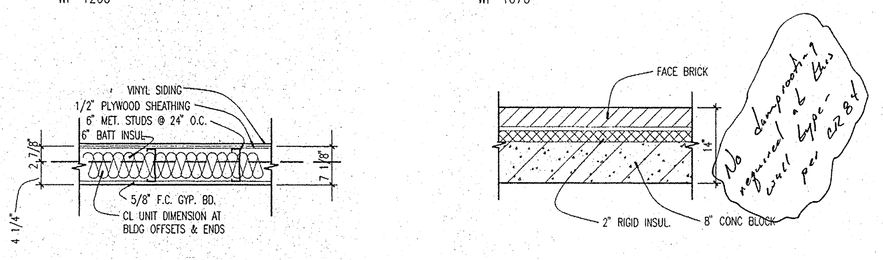

H WALL TYPE
1-HOUR

I WALL TYPE - EXTERIOR WALL
1-HOUR

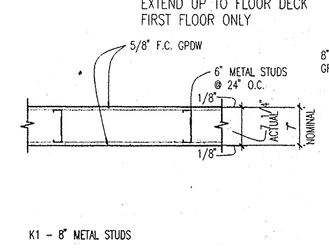

J WALL TYPE
1 HOUR WALL
WP 1200

K WALL TYPE
1 HOUR WALL
WP 1200

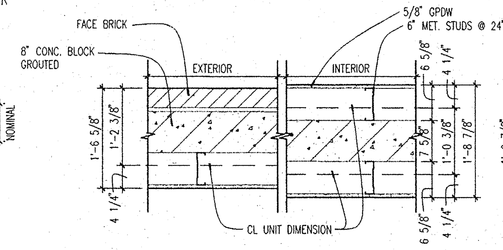

L WALL TYPE - AREA SEP. WALL
4 HOUR AREA
U.L. U901

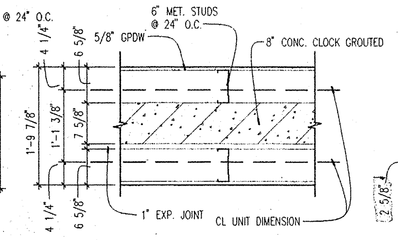

M AREA SEP. WALL W/EXP. JOINT
4 HOUR
U.L. U901
EXTEND THRU STRUCTURE
TO UNDERSIDE OF ROOF DECK

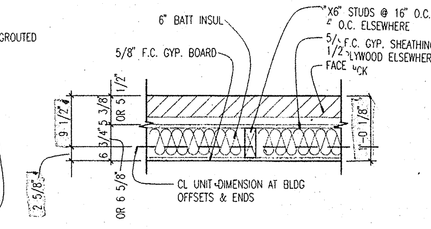

N WALL TYPE
1 HOUR EXTERIOR WALL STC: 39
WP 8130

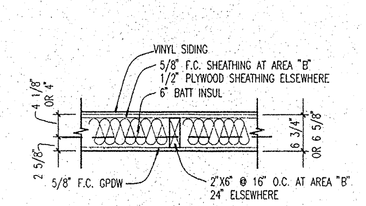

O WALL TYPE
1 HOUR EXTERIOR WALL

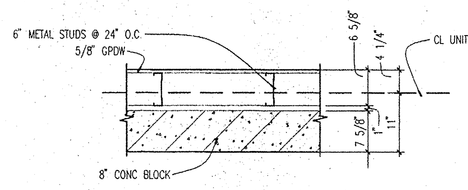

P WALL TYPE - SHAFT WALL
2 HOUR
EXTEND THRU STRUCTURE
TO UNDERSIDE OF ROOF DECK

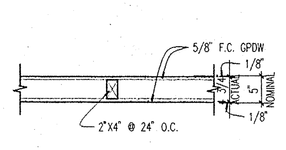

Q WALL TYPE - INTERIOR WALL
1 HOUR

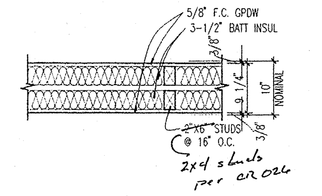

R WALL TYPE - CHASE WALL
1 HOUR STC: 50 EST.
STANDARD BLDG CODE SECTION 3106

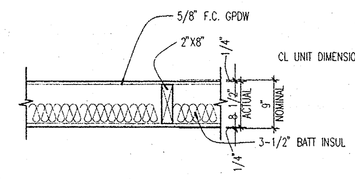

S WALL TYPE - CHASE WALL
1 HOUR STC: 35 EST.
STANDARD BLDG CODE SECTION 3106

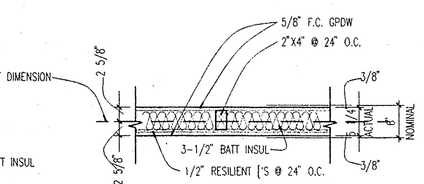

T CORRIDOR/PARTY WALL
1 HOUR STC: 54
WP 3240

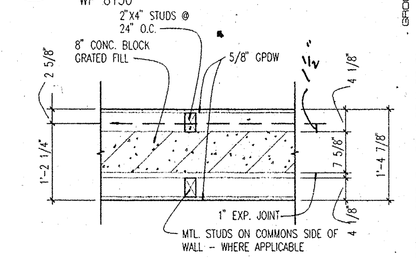

U AREA SEP. WALL
4 HOUR
U.L. U901
EXTEND THRU STRUCTURE
TO UNDERSIDE OF ROOF DECK

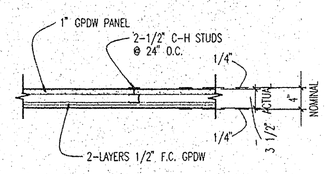

V SHAFT WALL
2 HOUR
WP 7095
EXTEND THRU STRUCTURE
TO UNDERSIDE OF ROOF DECK

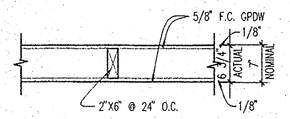

W WALL TYPE - INTERIOR WALL
1 HOUR STC: 39
WP 3510

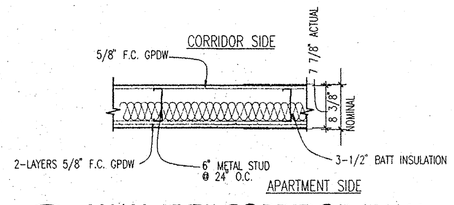

X WALL TYPE-CORRIDOR WALL
1 HOUR PARTITION STC: 54
WP 1023 MOD.
EXTEND UP TO FLOOR DECK
FIRST FLOOR ONLY

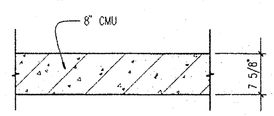

Y WALL TYPE - INTERIOR WALL

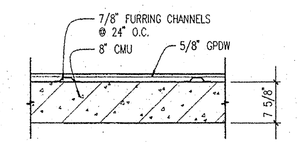

Z WALL TYPE - INTERIOR WALL

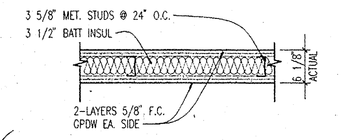

AA WALL TYPE - PARTY WALL
2 HR FIRE RATED WALL

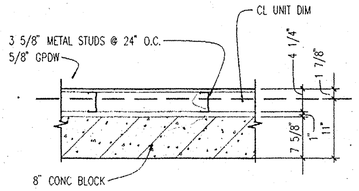

BB WALL TYPE - SHAFT WALL
2 HOUR
U.L. U901
EXTEND THRU STRUCTURE
TO UNDERSIDE OF ROOF DECK

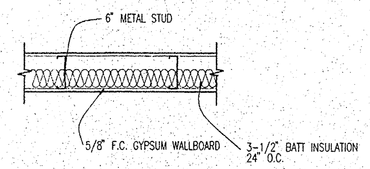

CC WALL TYPE
SOUND PARTITION - 1 HOUR STC: 49
WP 1076

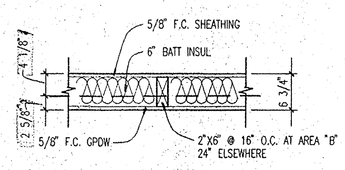

DD WALL TYPE
1 HOUR

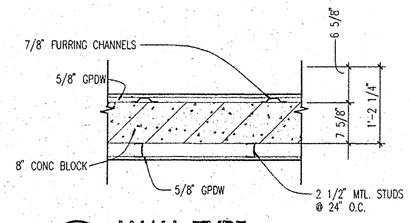

EE WALL TYPE

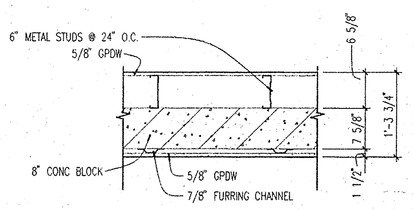

FF WALL TYPE

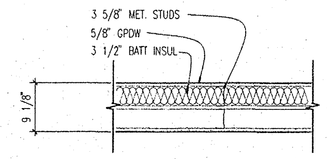

GG WALL TYPE

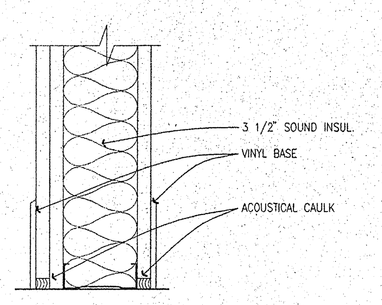

1 SOUNDWALL & FLR.
3" = 1'-0"

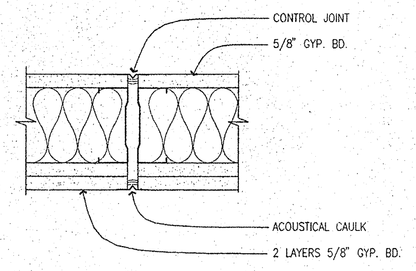

2 CONTR. JOINT @ SOUNDWALL
3" = 1'-0"

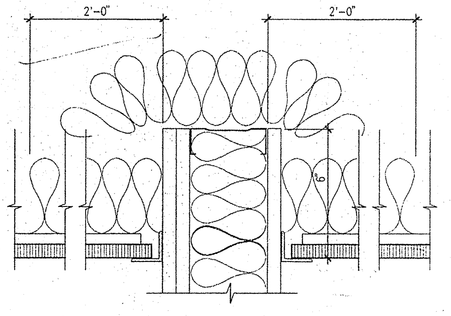

3 SOUNDWALL @ CEILING
3" = 1'-0"

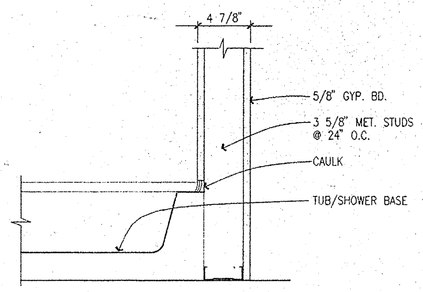

NOTE: THE ABOVE CONDITION SHALL OCCUR @ WALLS WITHIN THE APTS (WALLS OTHER THAN PARTY & CORRIDOR WALLS)

4 TUB/SHOW. BASE DETAIL
1 1/2" = 1'-0"

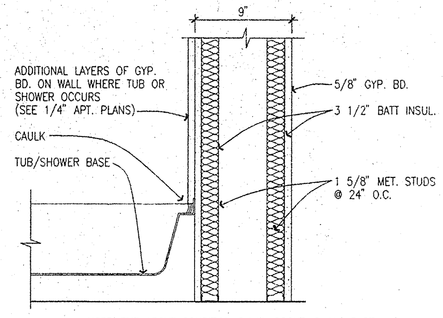

NOTE: THE ABOVE CONDITION SHALL OCCUR @ ALL PARTY & CORRIDOR WALLS UNLESS OTHERWISE NOTED.

5 TUB/SHOW. BASE DETAIL
1 1/2" = 1'-0"

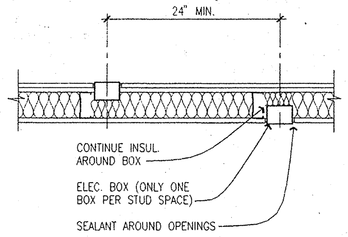

6 ELEC. BOXES @ SOUNDWALLS
1" = 1'-0"

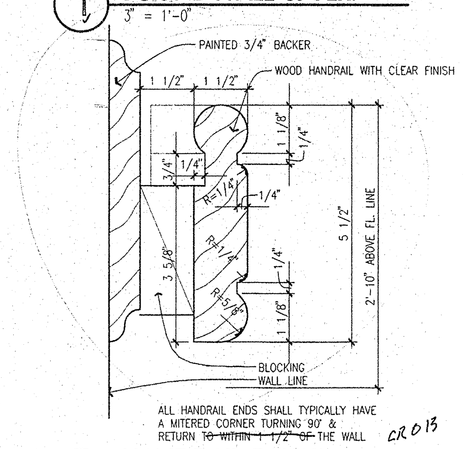

7 HANDRAIL DETAIL
NO SCALE
SEE 14/D14 FOR ADDITIONAL INFORMATION

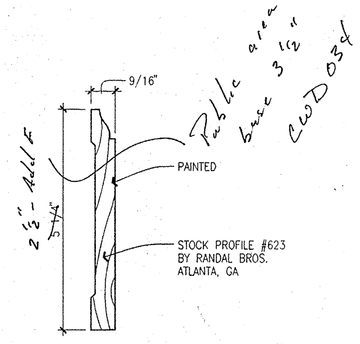

8 WOOD BASE
HALF SCALE

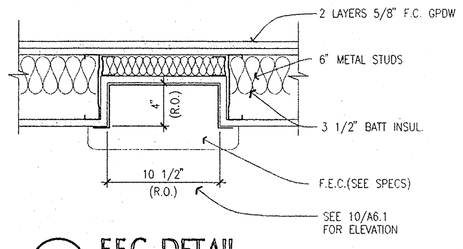

9 F.E.C. DETAIL
1 1/2" = 1'-0"

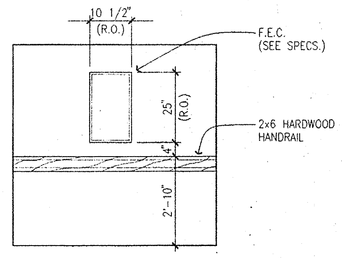

10 F.E.C. ELEVATION
NONE

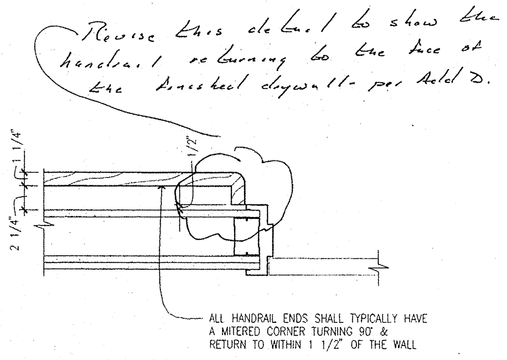

11 HANDRAIL DETAIL
1 1/2" = 1'-0"

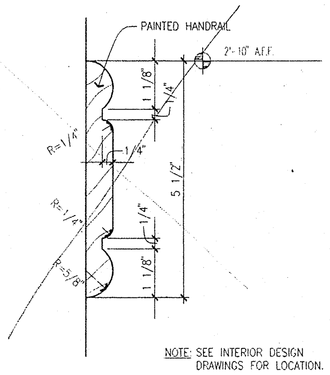

NOTE: SEE INTERIOR DESIGN DRAWINGS FOR LOCATION.

12 CHAIR RAIL
NO SCALE

These documents have been prepared for the CHRISTWOOD RETIREMENT CENTER project. They are not suitable for use on other projects or in other locations without the express written approval and participation of RDC Schutte Wilscam Birge, Inc. Reproduction is prohibited.
© RDC Schutte Wilscam Birge

RDC Schutte Wilscam Birge
8805 Indian Hills Drive Suite 100 Omaha, Nebraska 68114
ARCHITECTURE (402)392-0111 Fax (402)392-0313
PLANNING
INTERIOR

CHRISTWOOD
A CONTINUING CARE RETIREMENT FACILITY
COVINGTON LOUISIANA

DATE: 25NOVEMBER1994
PROJECT #: 9204100
FILE: 215

A6.1

REnAISSANCE DESIGN GROUP • REnAISSANCE DESIGN GROUP • REnAISSANCE DESIGN GROUP • REnAISSANCE DESIGN GROUP • REnAISSANCE DESIGN GROUP • REnAISSANCE DESIGN GROUP • REnAISSANCE DESIGN GROUP • REnAISSANCE DESIGN GROUP