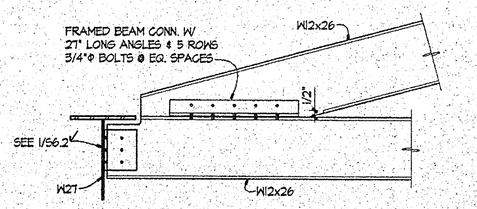

1 SECTION
3/4" = 1'-0"

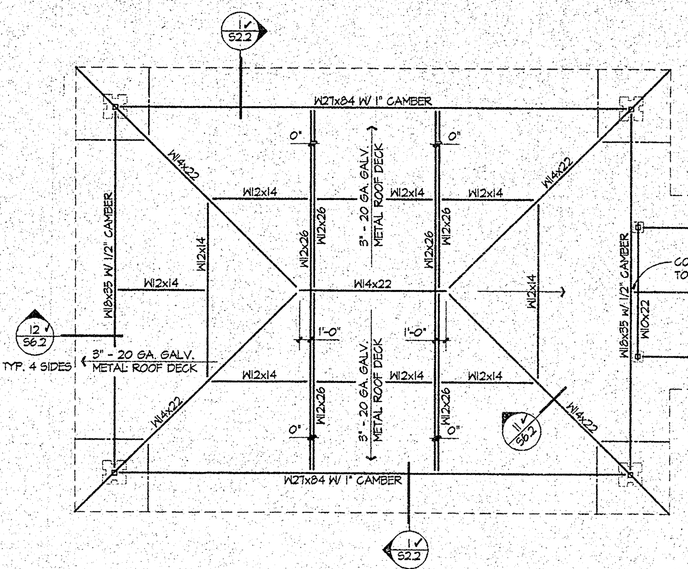

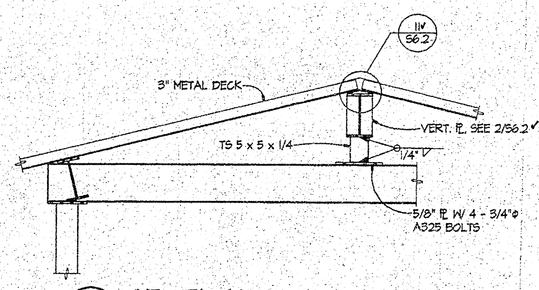

2 SECTION
1/2" = 1'-0"

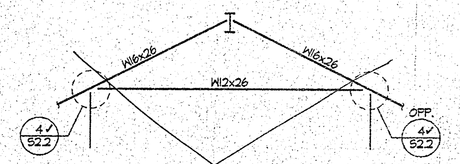

3 SECTION
1/8" = 1'-0"

Delete detail 3/S2.2 - per Add F

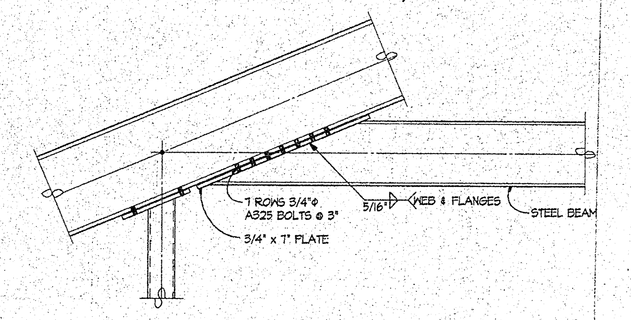

4 SECTION
3/4" = 1'-0"

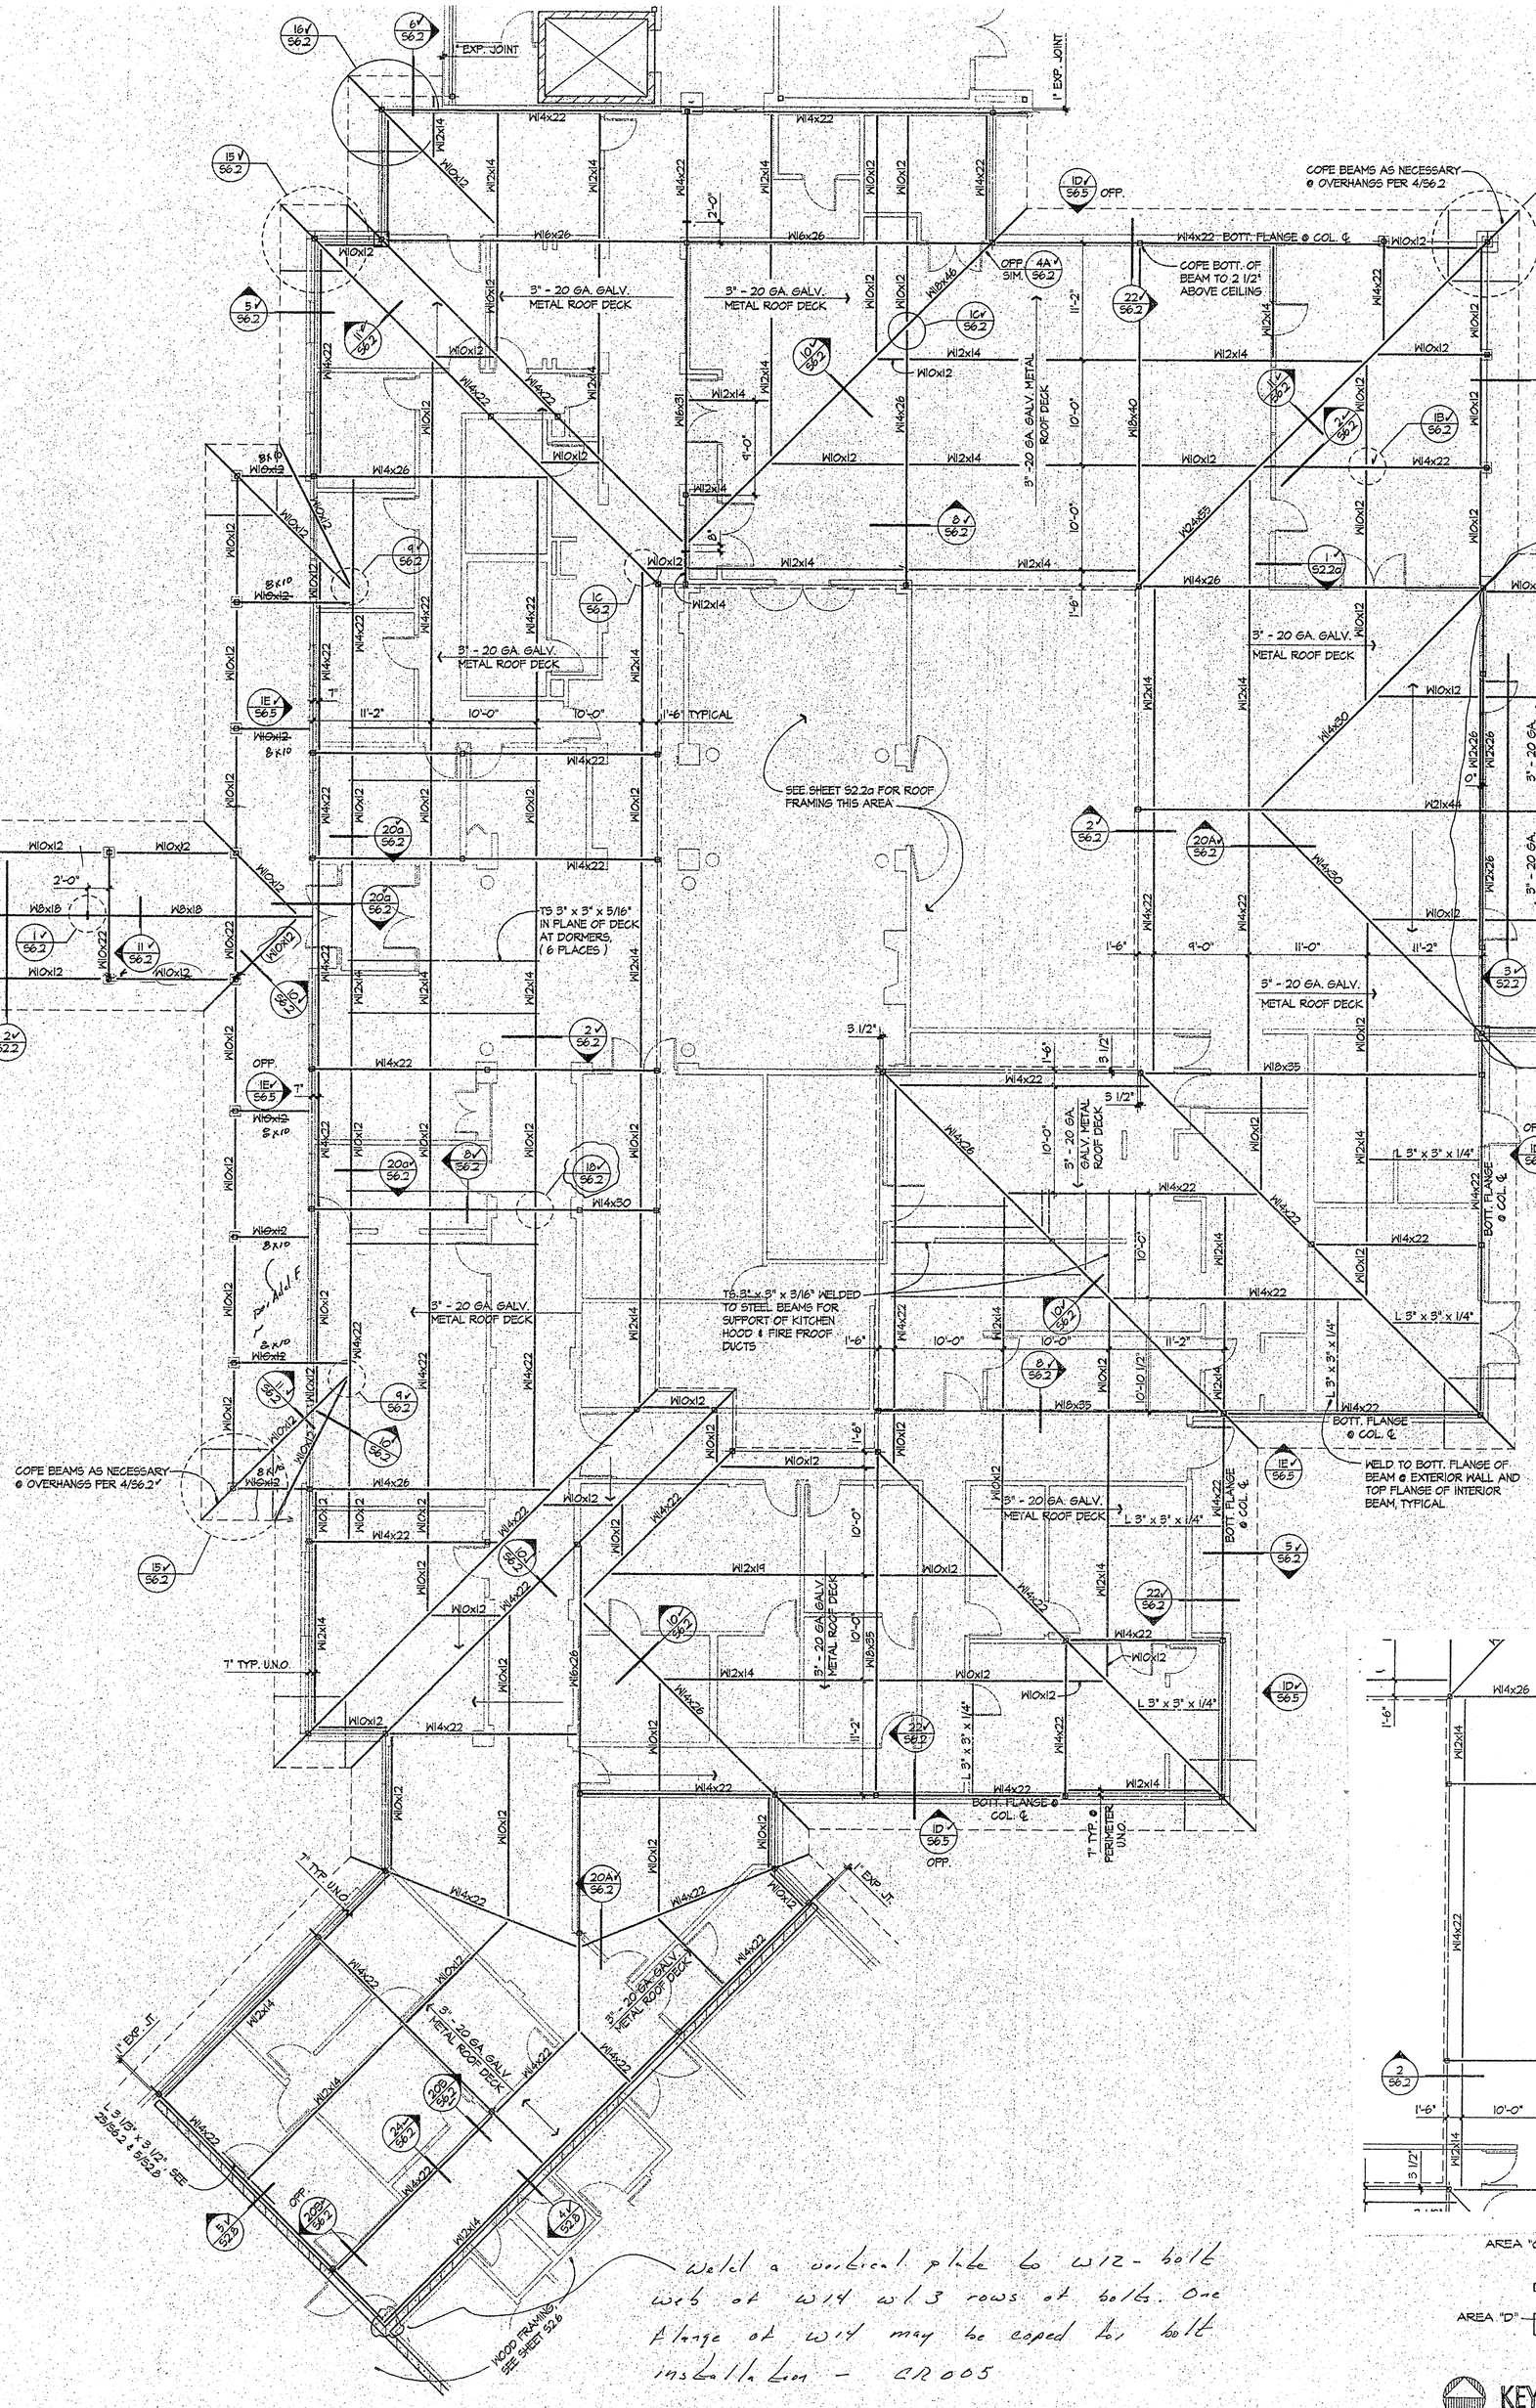

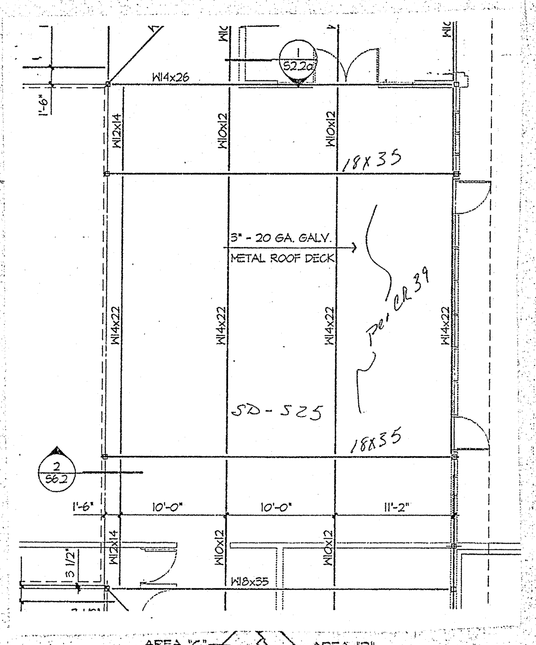

Delete roof over patio at central clerestory framing per S6-S2.5 - Add F

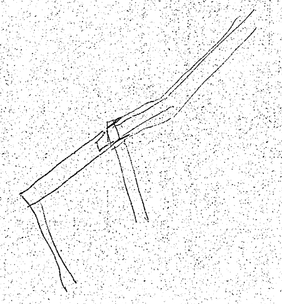

Weld a vertical plate to W12 - bolt web of W14 w/ 3 rows of bolts. One flange of W14 may be coped for bolt installation - CR005

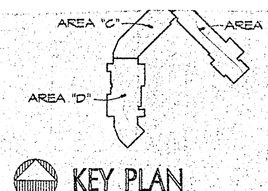

KEY PLAN
NORTH NO SCALE

COMMONS SLOPED ROOF FRAMING PLAN - AREA "A"

NORTH
1/8" = 1'-0"
NOTE : SEE STRUCTURAL NOTES ON SHEET S2.0

These documents have been prepared for the CHRISTWOOD RETIREMENT CENTER project. They are not suitable for use on other projects or in other locations without the expres written approval and participation of RDG Schutte Wilscam Birge Inc
Reproduction is prohibited.
© RDG Schutte Wilscam Birge

STATE OF LOUISIANA
NELSON J. JENKINS
Cert. No. 19815
REGISTERED PROFESSIONAL ENGINEER
III CIVIL ENGINEERING

THOMPSON, DREESSEN & DORNER, INC.
STRUCTURAL ENGINEERS

RDG Schutte Wilscam Birge
8805 Indian Hills Drive Suite 100 Omaha, Nebraska 68114 402-392-0433 Fax: 402-392-0433
ARCHITECTURE INTERIOR DESIGN PLANNING

CHRISTWOOD
A CONTINUING CARE RETIREMENT FACILITY
COVINGTON LOUISIANA

DATE: 25NOVEMBER1994
PROJECT #: 9204100
FILE: 215

S2.2

RENAISSANCE DESIGN GROUP • RENAISSANCE DESIGN GROUP • RENAISSANCE DESIGN GROUP • RENAISSANCE DESIGN GROUP • RENAISSANCE DESIGN GROUP • RENAISSANCE DESIGN GROUP • RENAISSANCE DESIGN GROUP • RENAISSANCE DESIGN GROUP • RENAISSANCE DESIGN GROUP • RENAISSANCE DESIGN GROUP • RENAISSANCE DESIGN GROUP • RENAISSANCE DESIGN GROUP