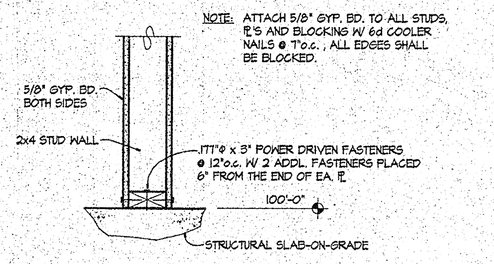

NOTE: ATTACH 5/8" GYP. BD. TO ALL STUDS, ℄'S AND BLOCKING W/ 6d COOLER NAILS @ 7"o.c., ALL EDGES SHALL BE BLOCKED.

1 SECTION
1 1/2" = 1'-0"

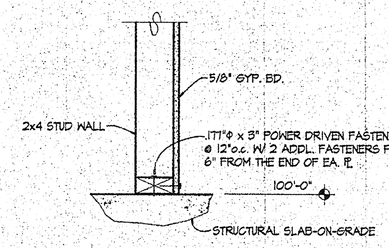

2 SECTION
1 1/2" = 1'-0"

NOTES: 1. ATTACH GYP. BD. TO ALL STUDS, ℄'S AND BLOCKING W/ 6d COOLER NAILS @ 7"o.c., ALL EDGES SHALL BE BLOCKED.

2. ATTACH 1/2" OXBOARD SHEATHING TO FACE OF WALL W/ 8d COMMON NAILS @ 6"o.c. ALONG PANEL EDGES & @ 12"o.c. ALONG INTERMEDIATE FRAMING MEMBERS. ALL EDGES SHALL BE BLOCKED.

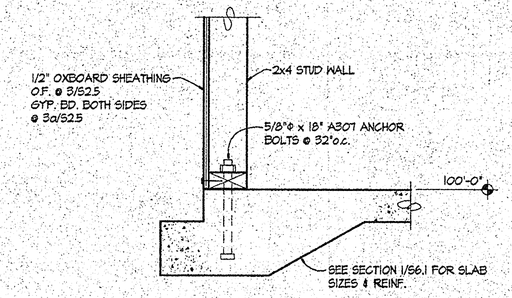

3 3a SECTION
1 1/2" = 1'-0"

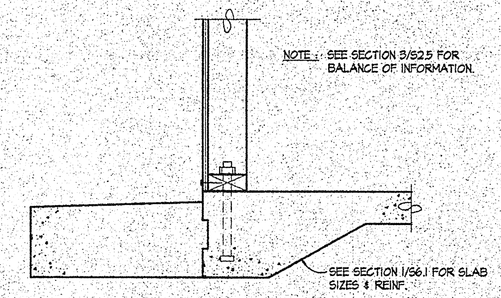

NOTE: SEE SECTION 3/S2.5 FOR BALANCE OF INFORMATION.

4 SECTION
1 1/2" = 1'-0"

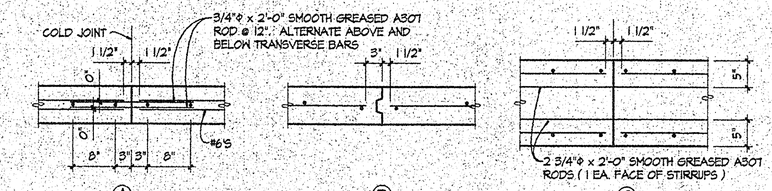

A SLAB JOINT PERPENDICULAR TO LONG DIRECTION OF SLAB

B SLAB JOINT PARALLEL TO LONG DIRECTION OF SLAB

C SLAB EDGE

NOTES: 1. WITHIN ONE WEEK OF FLOOR COVERING INSTALLATION, FILL JOINT WITH NON-SHRINK GROUT.

2. CAULK CONCRETE EXPOSED TO THE WEATHER.

SLAB CONTRACTION JOINTS

5 SECTION
3/4" = 1'-0"

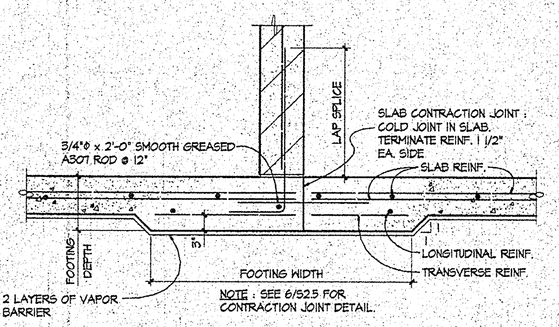

NOTE: SEE 6/S2.5 FOR CONTRACTION JOINT DETAIL.

6 SECTION
3/4" = 1'-0"

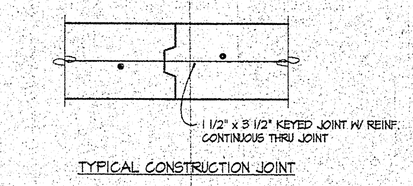

TYPICAL CONSTRUCTION JOINT

7 SECTION
1 1/2" = 1'-0"

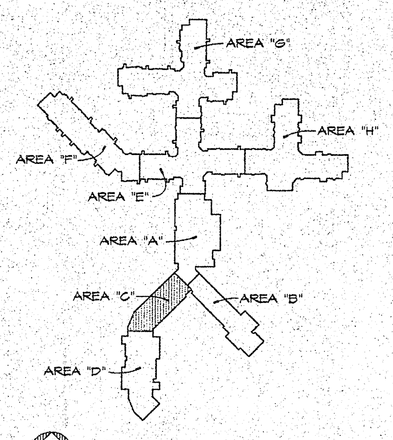

KEY PLAN
NORTH NO SCALE

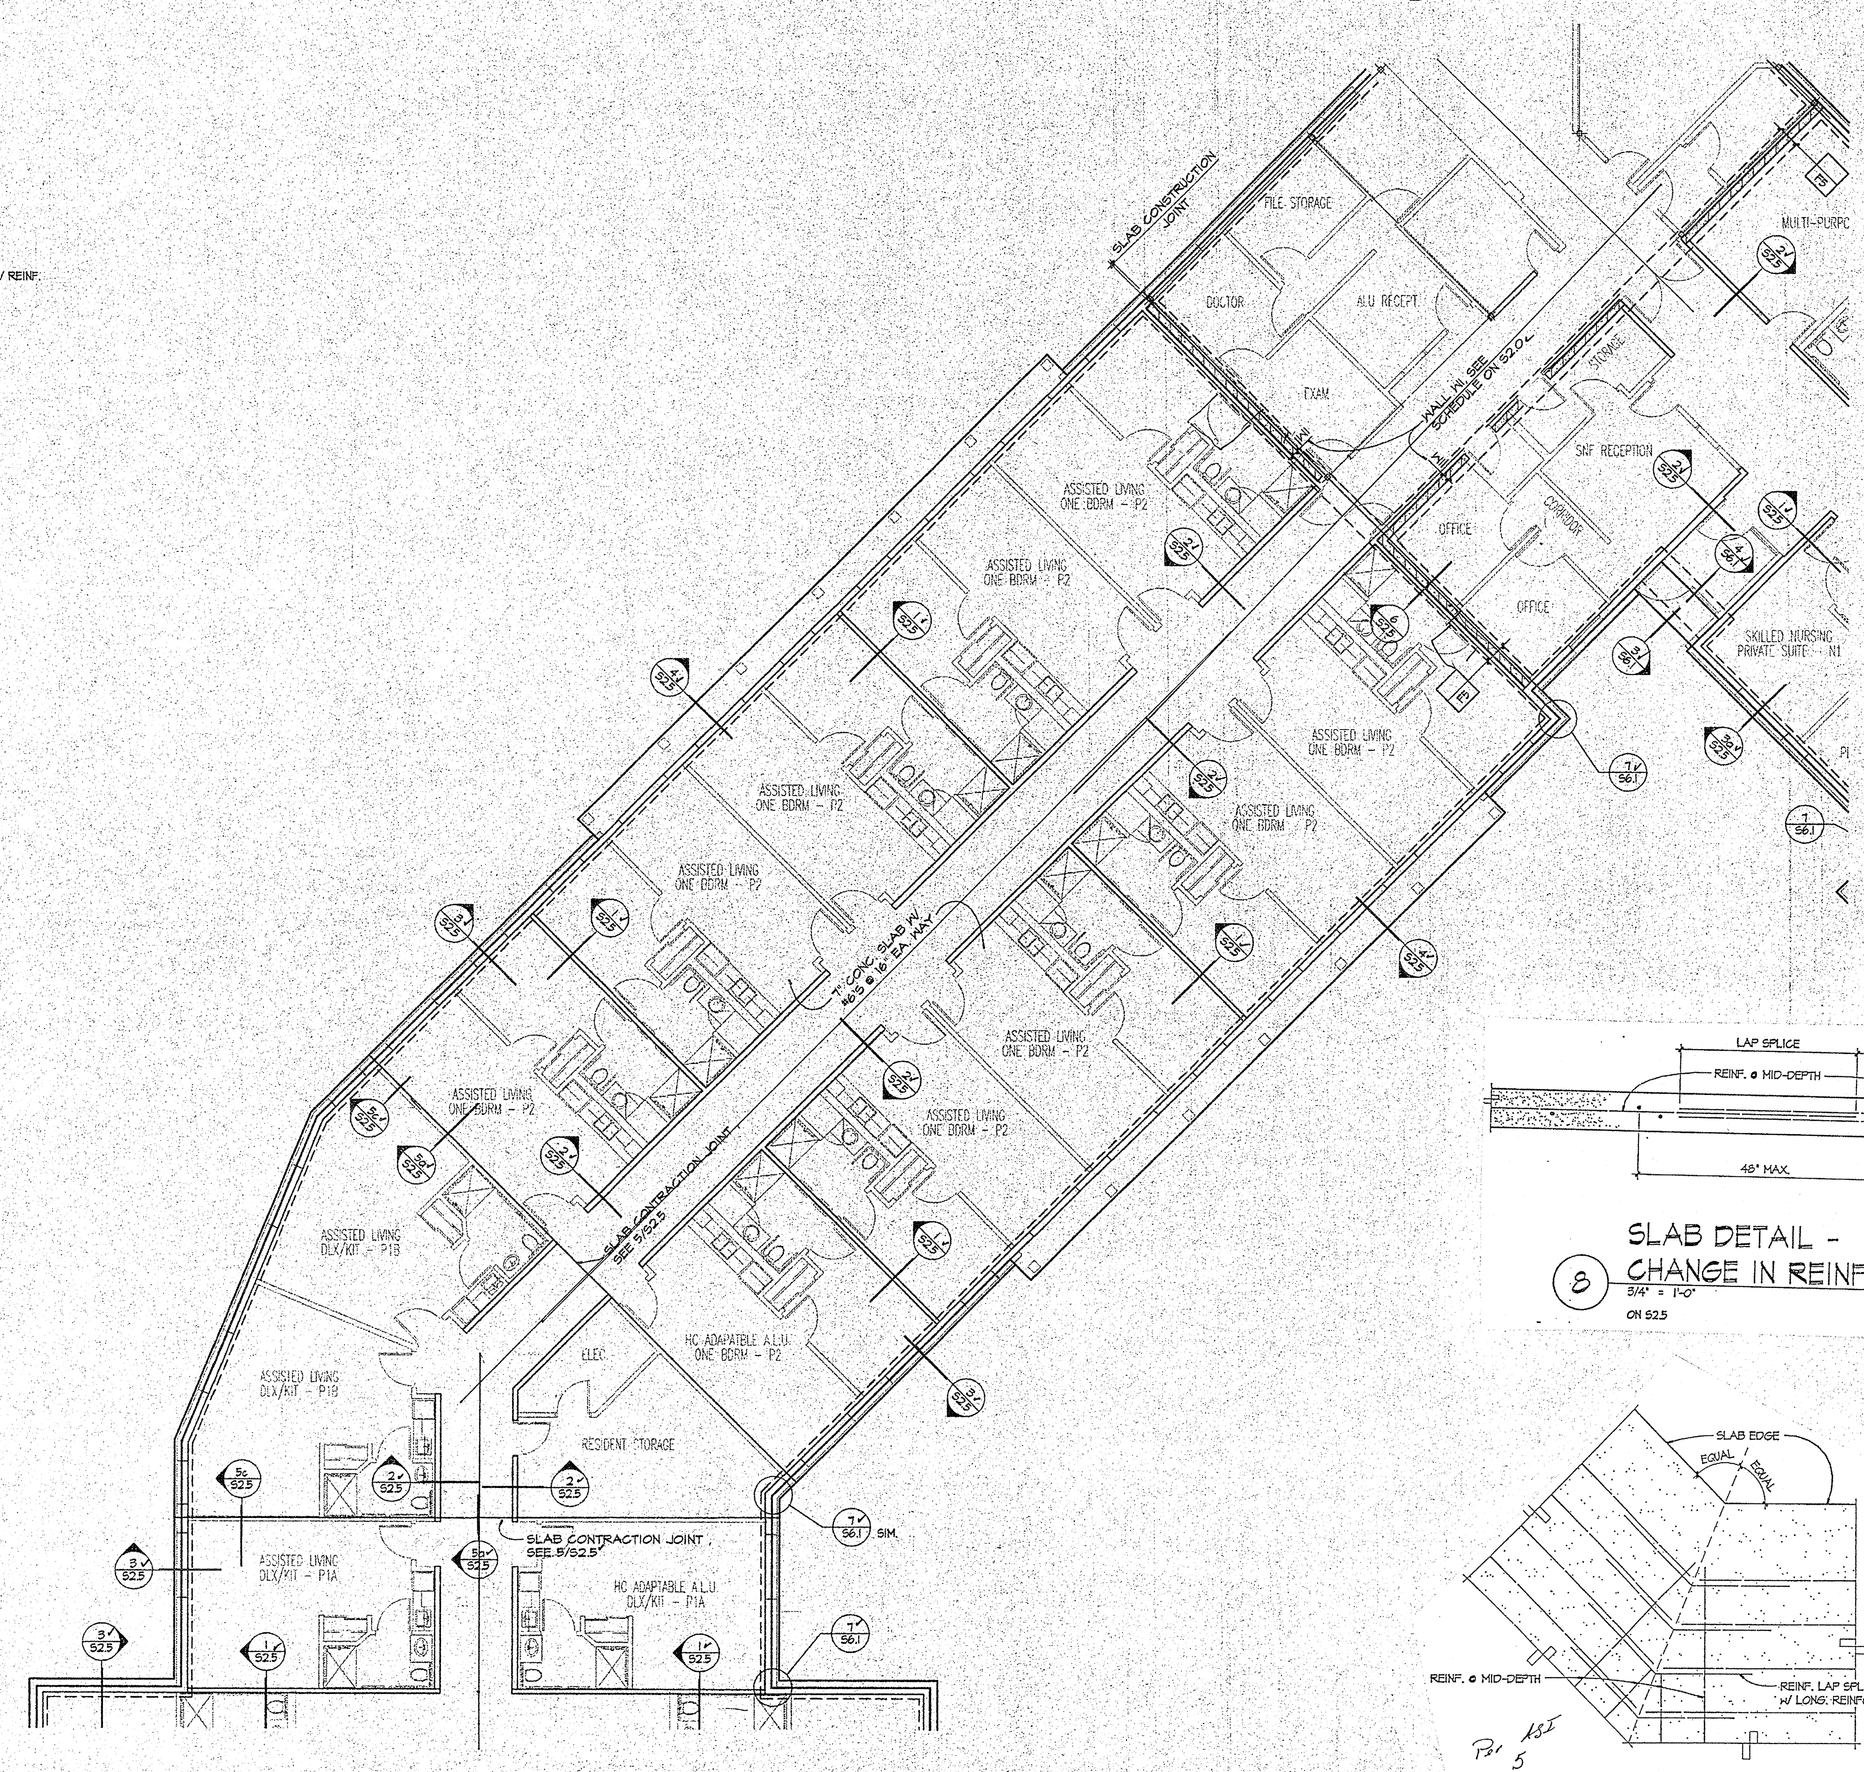

ASSISTED LIVING FOUNDATION PLAN - AREA "C"
NORTH 1/8" = 1'-0"

NOTE: SEE STRUCTURAL NOTES ON SHEET S2.0

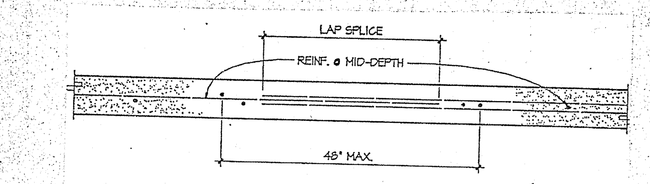

SLAB DETAIL - CHANGE IN REINF. @ 90°
8 3/4" = 1'-0"
ON S2.5

P1 ASI-5

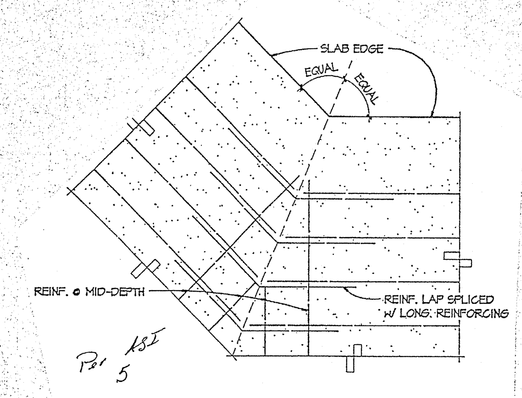

P1 ASI 5

PLAN VIEW SLAB DETAIL
9 3/4" = 1'-0"
ON S2.5

These documents have been prepared for the CHRISTWOOD RETIREMENT CENTER project. They are not to be used for any other projects or on other locations without the express written approval and participation of RDG Schutte Wilscam Birge, Inc. Reproduction is prohibited.
© RDG Schutte Wilscam Birge

STATE OF LOUISIANA
NELSON J. THOMAS
No. 19 - 24267
REGISTERED PROFESSIONAL ENGINEER IN STRUCTURAL ENGINEERING

THOMPSON, DREESSEN & DORNER, INC.
STRUCTURAL ENGINEERS

RDG Schutte Wilscam Birge
8805 Indian Hills Drive Suite 100 Omaha, Nebraska 68114 402-392-0133 FAX: 402-392-0433
ARCHITECTURE INTERIOR DESIGN PLANNING

CHRISTWOOD
A CONTINUING CARE RETIREMENT FACILITY
COVINGTON LOUISIANA

DATE: 25 NOVEMBER 1994
PROJECT #: 9204100
FILE: 215

S2.5

RENAISSANCE DESIGN GROUP • RENAISSANCE DESIGN GROUP • RENAISSANCE DESIGN GROUP • RENAISSANCE DESIGN GROUP • RENAISSANCE DESIGN GROUP • RENAISSANCE DESIGN GROUP • RENAISSANCE DESIGN GROUP • RENAISSANCE DESIGN GROUP